
RECEIVED
FEB 4 1986


ABELL
SURVEYING & MAPPING
DELAVAN, WISCONSIN 53115

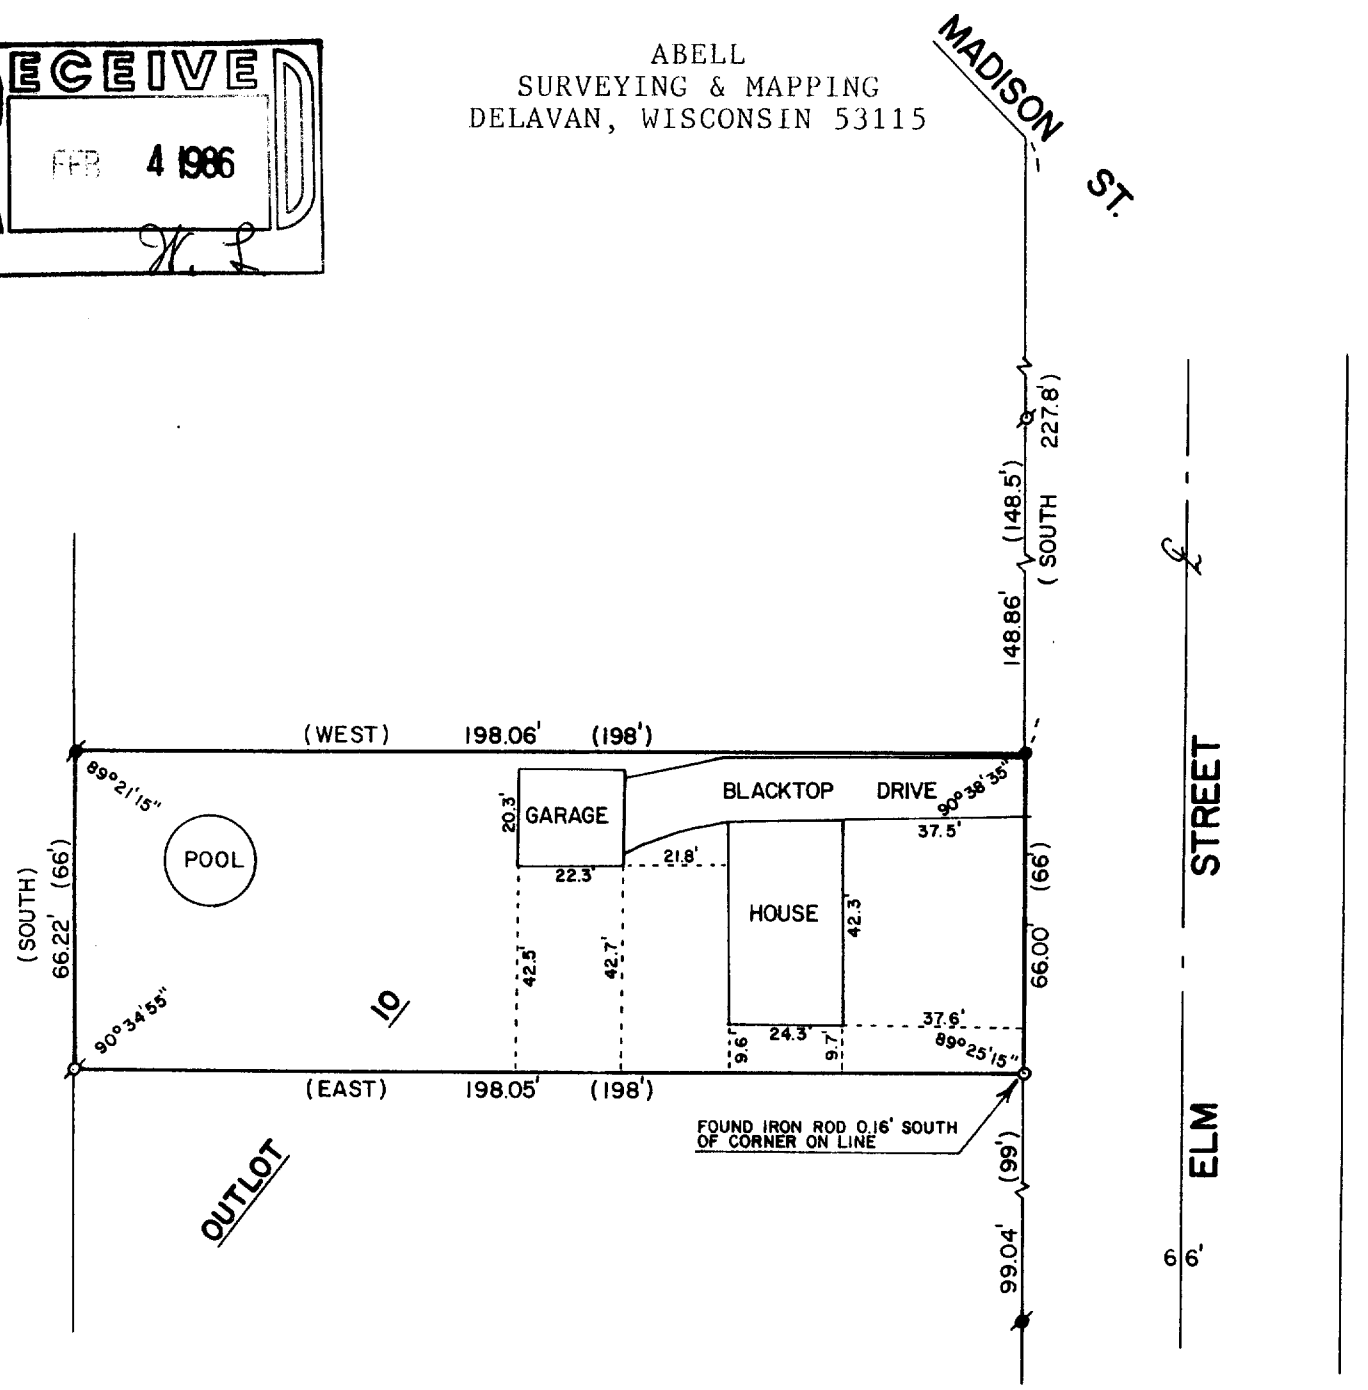

PLAT OF SURVEY OF

THE NORTH 66 FEET OF OUTLOT 10, ASSESSOR'S PLAT, VILLAGE OF WALWORTH, WALWORTH COUNTY, WISCONSIN, AS DESCRIBED IN VOLUME 661 OF DEEDS ON PAGE 252 AS DOCUMENT NUMBER 601216.

ORDERED BY: CENTURY 21
SKANDIA REALTY, INC.
312 S. 7th STREET
DELAVAN, WI 53115

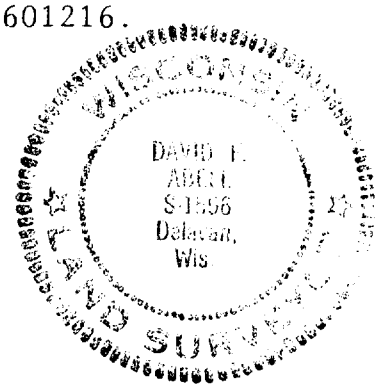



SCALE - 1"=40'

LEGEND
- ⌀ - IRON PIPE FOUND
- ● - IRON ROD SET
- ⌀ - IRON BOLT FOUND
- ( ) - RECORDED AS

I, DAVID F. ABELL, DO HEREBY CERTIFY THAT I HAVE SURVEYED THE PROPERTY HEREON DESCRIBED ACCORDING TO THE OFFICIAL RECORDS, AND THAT THE PLAT HEREON IS A CORRECT REPRESENTATION OF THE LOT LINES TO THE BEST OF MY KNOWLEDGE AND BELIEF.

David F Abell

DAVID F. ABELL
WISCONSIN REGISTERED LAND SURVEYOR, S-1596

JANUARY 14, 1986
DATE JOB NUMBER - 0186001

VWP-18

9-257 ✓