
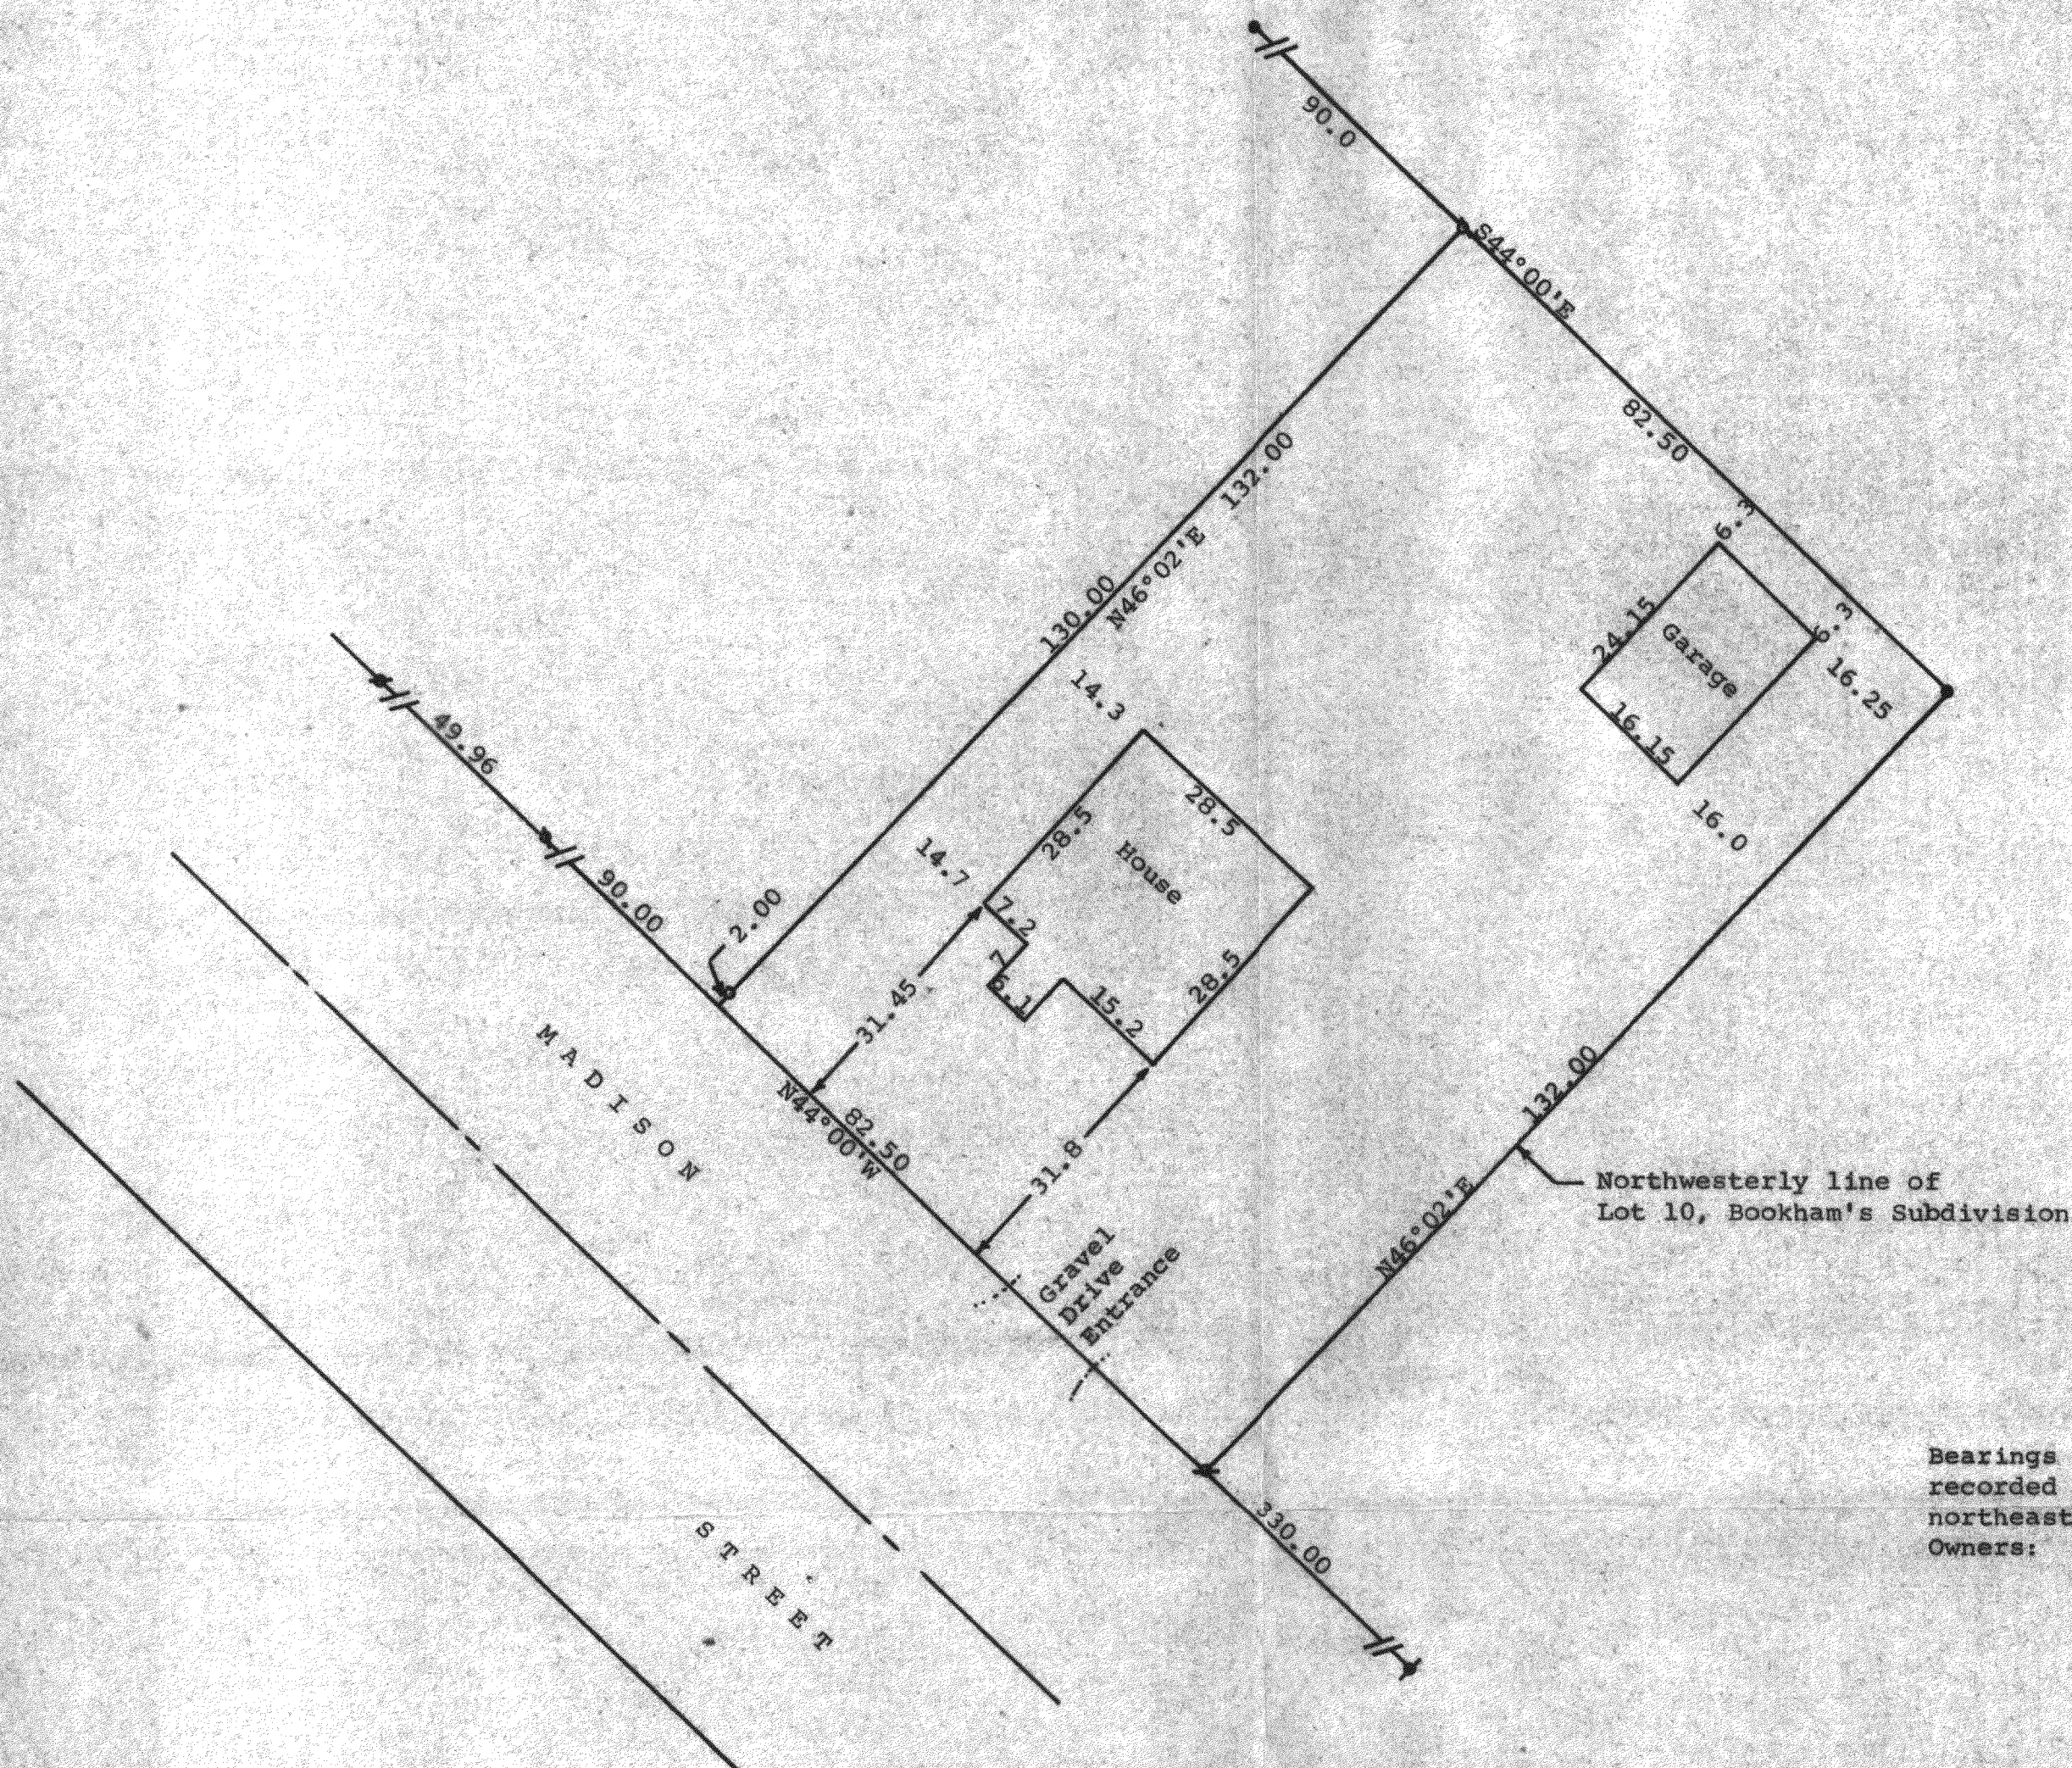


DUNHAM SURVEYING, S.C.
SURVEYING & SUBDIVIDING
DELAVER, WISCONSIN 53115

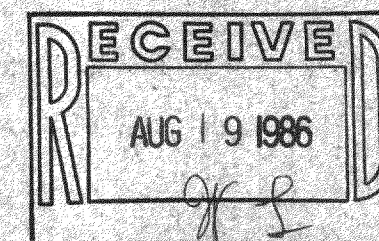

Scale - 1" = 20'
 A = 1/2" Iron Pipe Found
 B = 3/4" Iron Pipe Found
 C = 1 1/4" Iron Pipe Found
 D = 1/2" Bent Iron pipe Found
 3/4" X 24" iron pipe Set
 Bearings referenced to the previously recorded bearing of N44°00'W along the northeasterly line of Madison Street
 Owners: Joseph F. & Lorraine A. Hladish
 Walworth, WI 53184
 E = Concrete Monument Found

STATE OF WISCONSIN) ss
 COUNTY OF WALWORTH)

I, George T. Dunham, Surveyor, certify that I have surveyed the property described as follows:

A parcel of land located in Outlot 5 of the Assessor's Plat of the Village of Walworth, Walworth County, Wisconsin, described as follows: Beginning at a point on the Northwesterly line of Lot 10, Bookham's Subdivision to the Village of Walworth, Walworth County, Wisconsin, where the said Northwesterly line of said Lot 10 intersects the northerly line of Madison Street; thence N44°00'W along the northerly line of Madison Street 82.50 feet to a point; thence N46°02'E parallel to the northwesterly side of said Lot 10, 132.00 feet; thence S44°00'E 82.50 feet to the Northerly corner of said Lot 10; thence S46°02'W along the northwesterly line of said Lot 10, 132.00 feet to the place of beginning.

and that the map shown above is a true representation thereof and shows the size and location of the property, its exterior boundaries, the location of all visible structures and dimensions of all principal buildings thereon, boundary fences, apparent easements, roadways and visible encroachments, if any, and that I have surveyed the property hereon described according to the official records to the best of my knowledge and belief.
 October 30, 1984

George T. Dunham
 George T. Dunham, Surveyor

