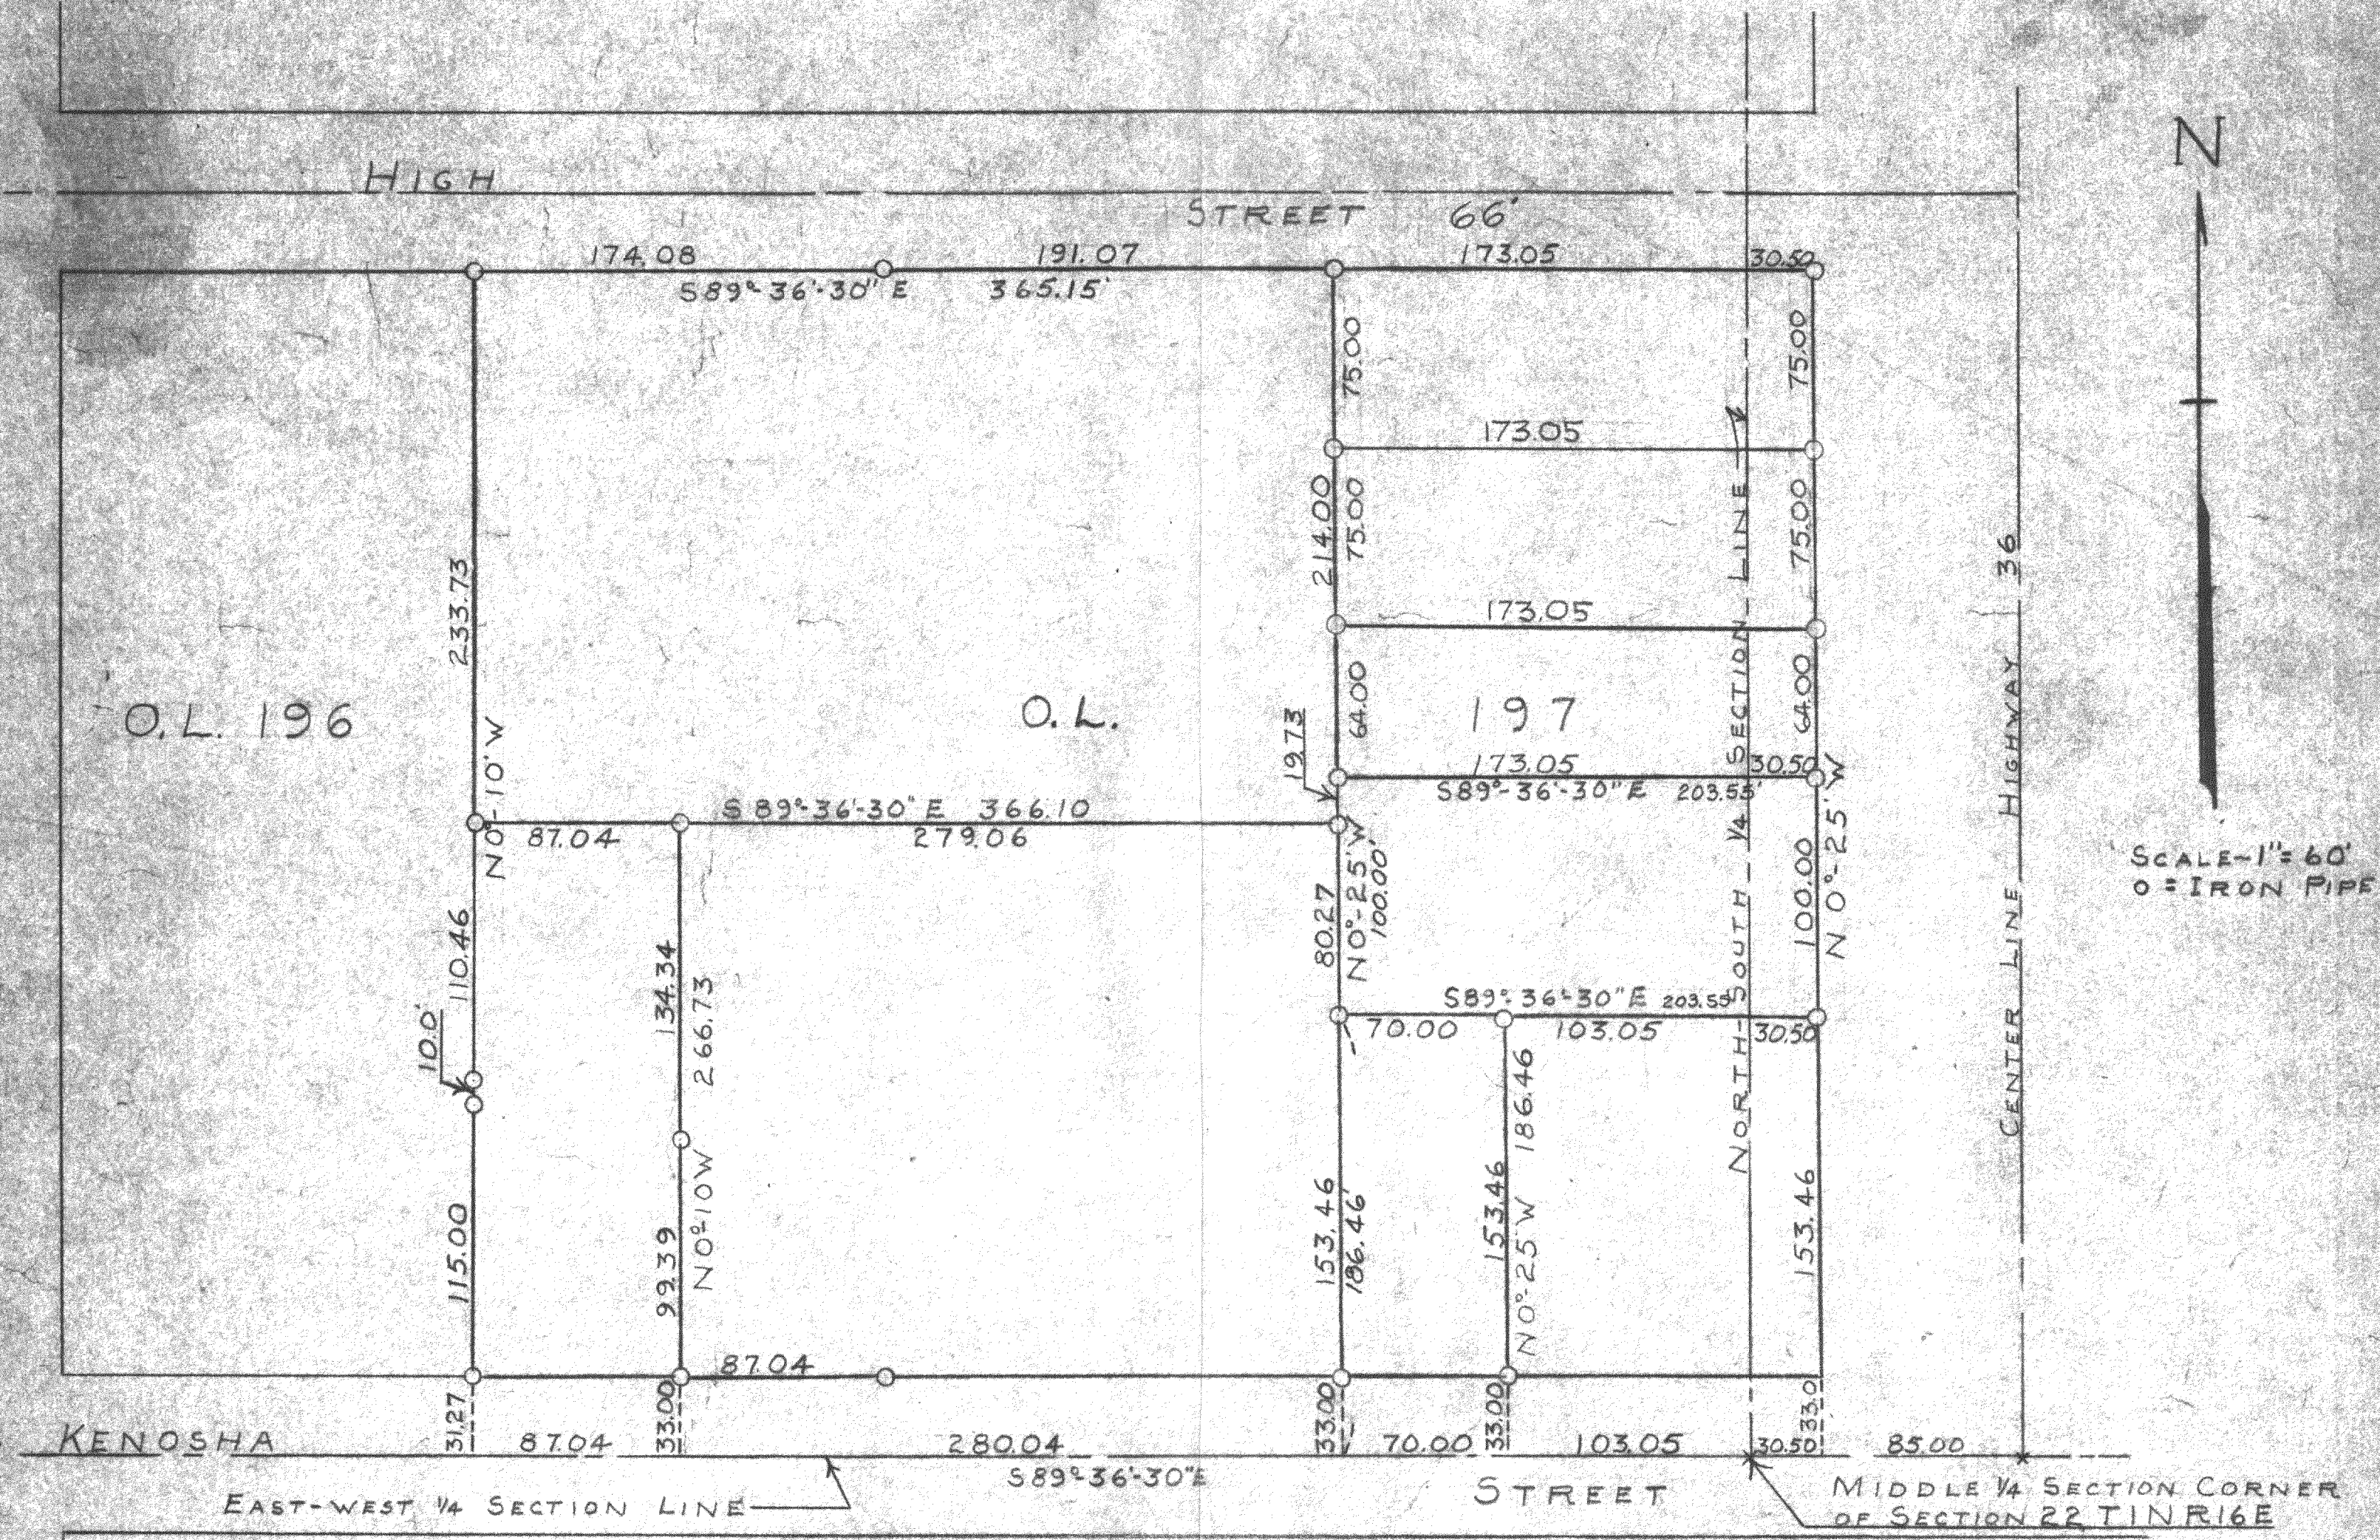


SCALE-1"=60'
O=IRON PIPE

VWP 247
 VWP 248
 VWP 250
 254
 254A
 255
 256
 257
 VWP 2, 4, 44

PLAT OF SURVEY OF LAND LOCATED IN OUTLOT 197 VILLAGE
 OF WALWORTH AND LAND IN NORTH-EAST 1/4 OF SECTION 22
 T1N R16E WALWORTH COUNTY, WISCONSIN
 FEBRUARY 1952
 REVISED MAY 1955
 Lloyd L. Jensen
 COUNTY SURVEYOR