
#258-65

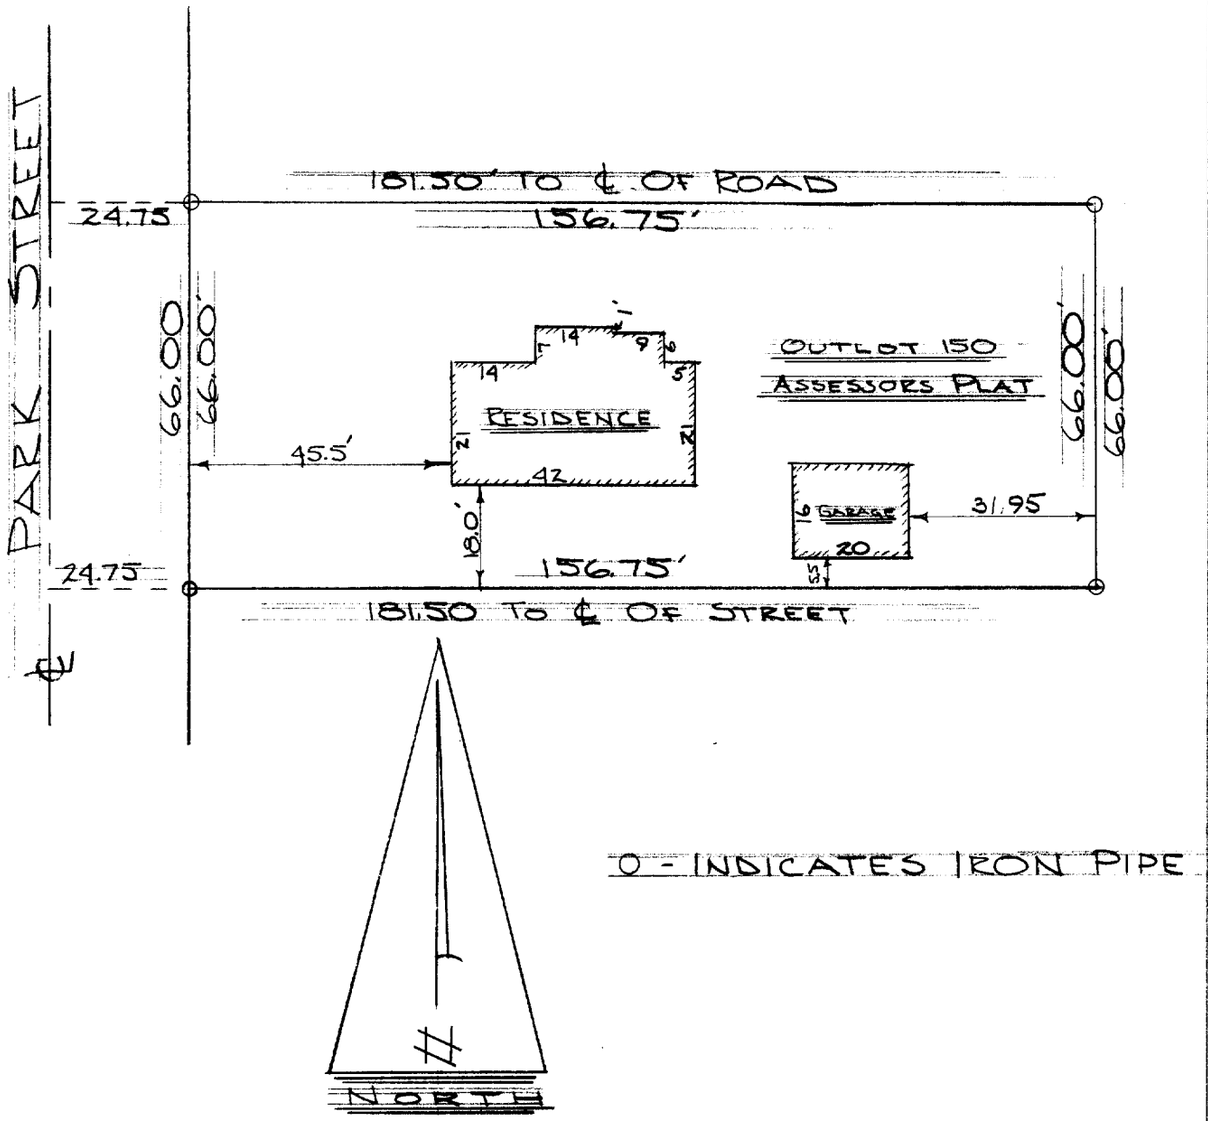

DESCRIPTION:

Outlot #150, Assessor's Plat, Village of Walworth, Walworth County Wisconsin.

CERTIFICATE:

I, hereby certify that I have surveyed the above mentioned property and that the hereon portrayed is an accurate survey and a true representation thereof and correctly shows the exterior boundary lines and the location of buildings and other improvements thereof.

Dated December 2nd 1965.

WISCONSIN
JAMES F.
BIAGI
MILWAUKEE,
WIS.
LAND SURVEYOR

James F. Biagi

James F. Biagi. RLS 272
Elkhorn, Wisconsin.

9-2B

VWP-172