


DUNHAM SURVEYING, S.C.
SURVEYING & SUBDIVIDING
DELAVER, WISCONSIN 53115

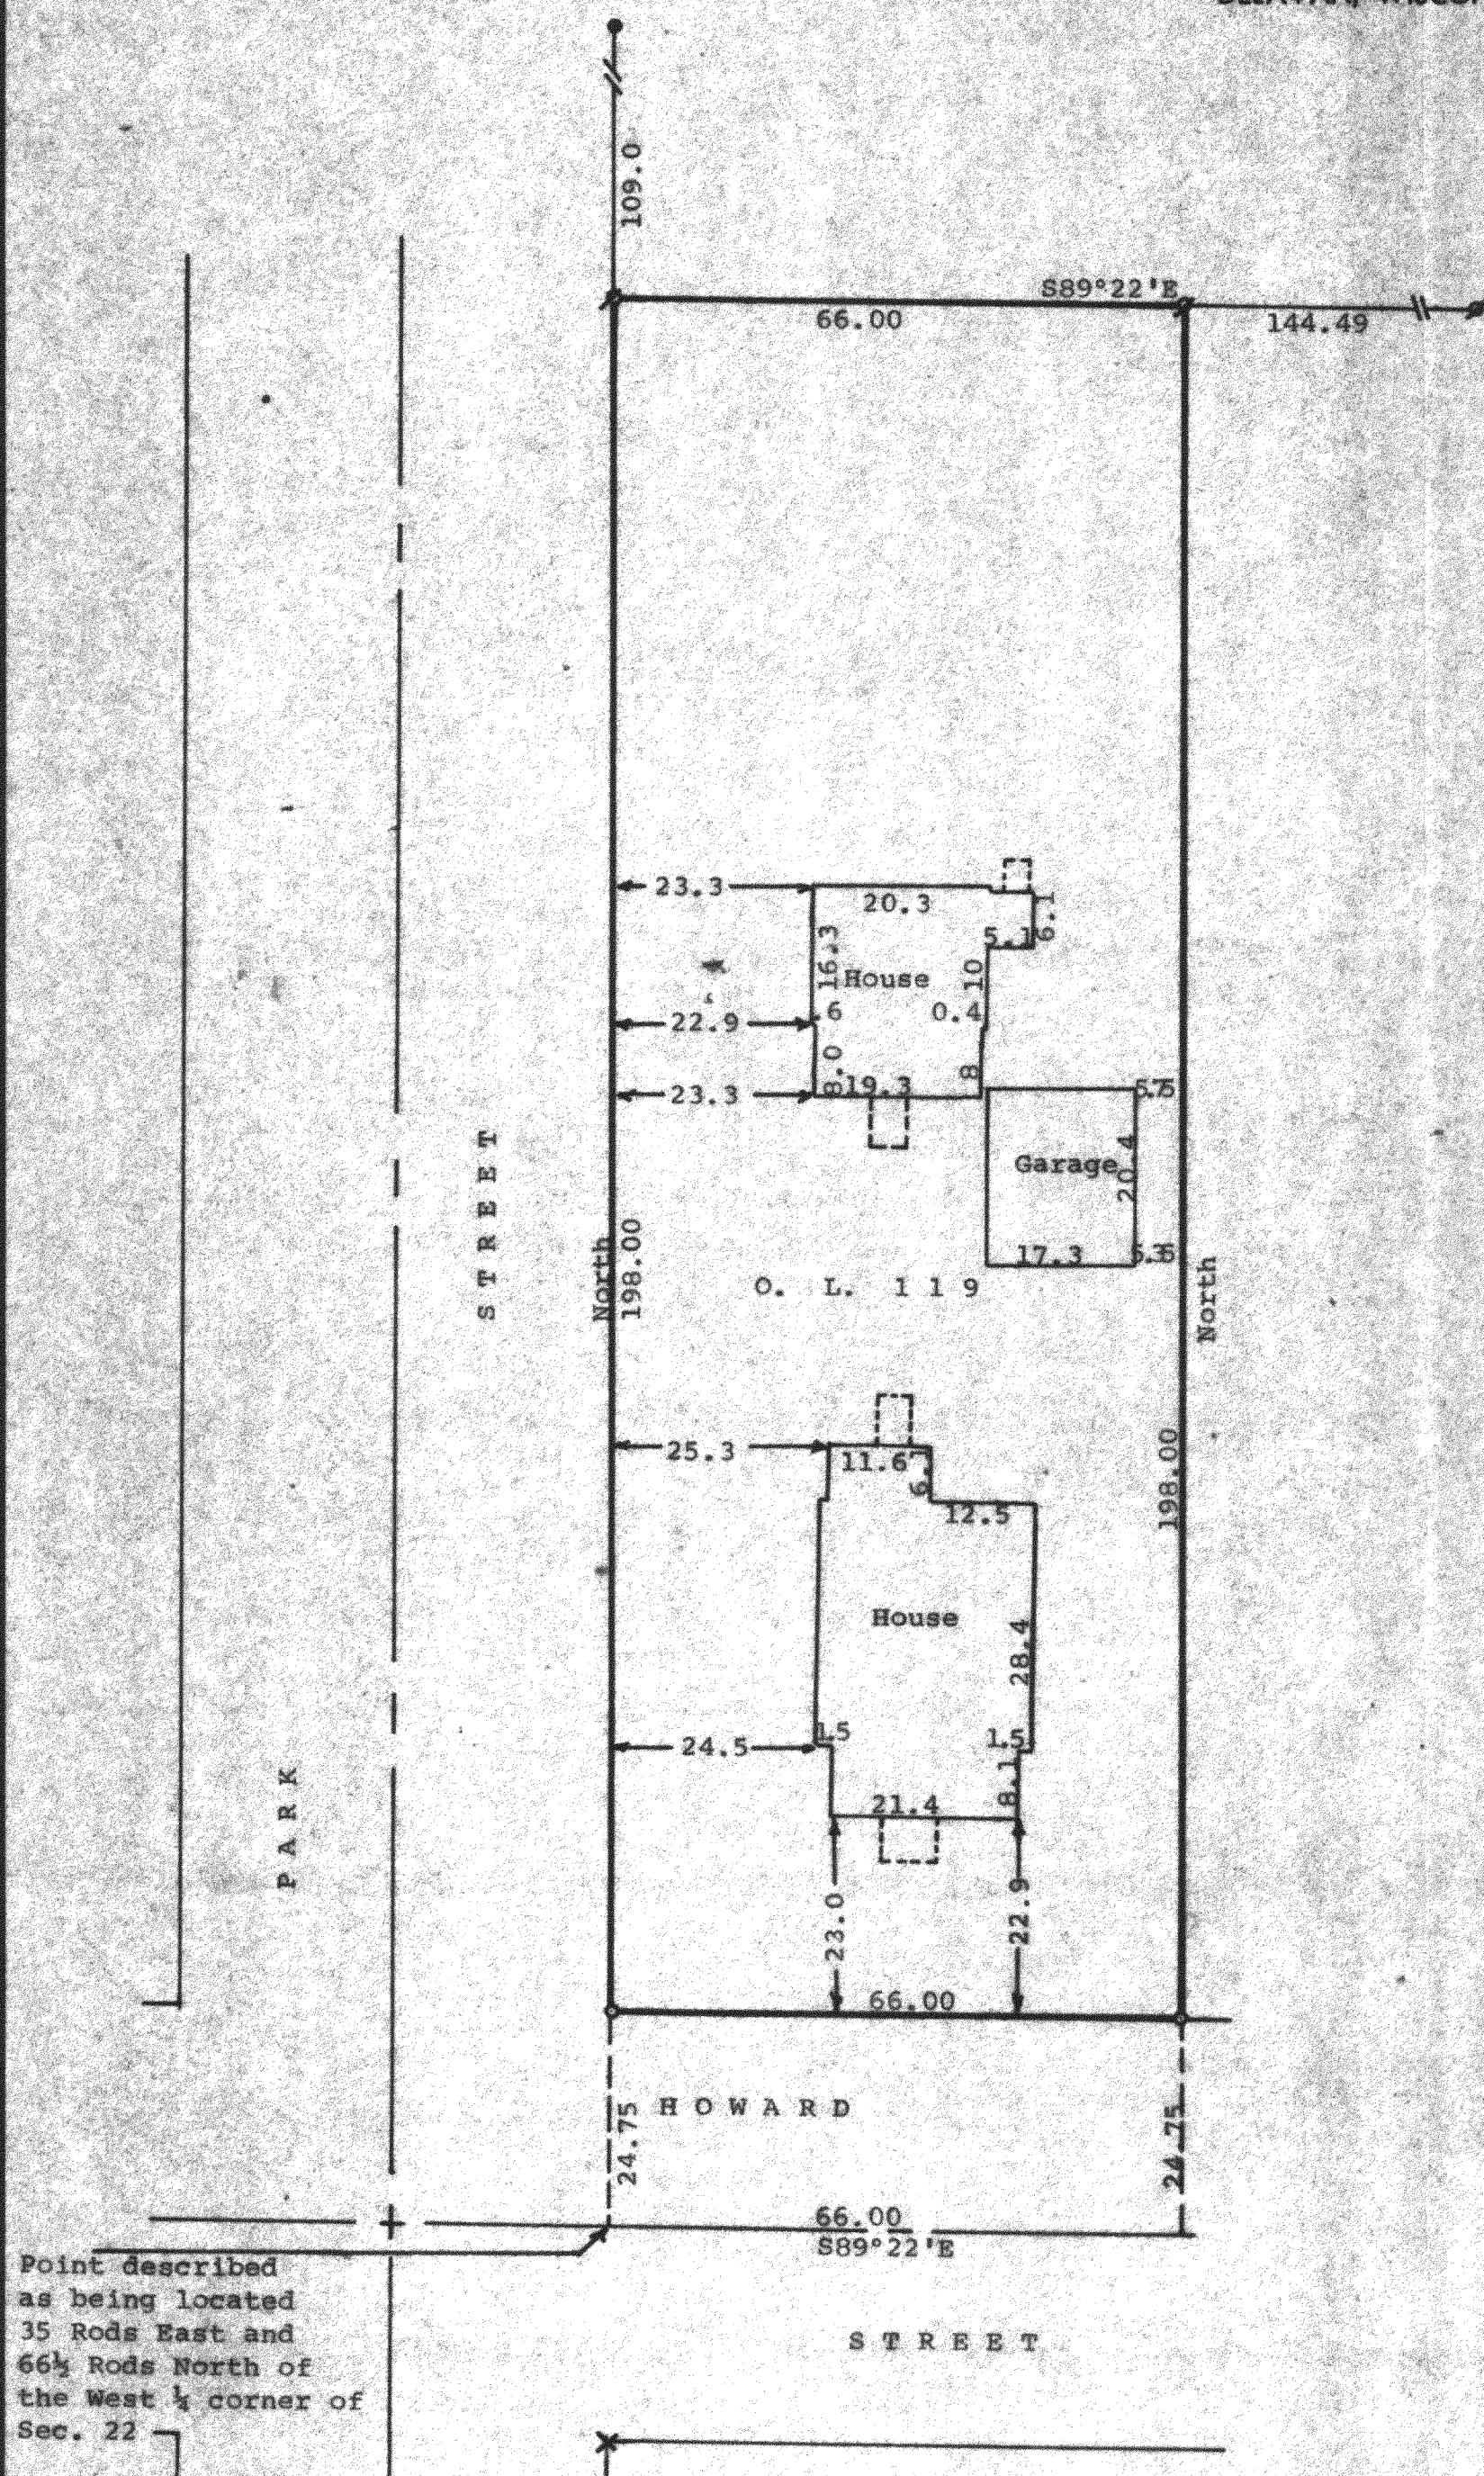

N

Scale - 1" = 20'


- X- found cross in concrete
- 1" Iron Pipe Found
- = Iron Rod Found
- o = 1 1/4" Iron Pipe Set

Bearings referenced to the assumed bearing of North along the east line of Park Street
Survey ordered by: 1st Bank Southeast of Lake Geneva
6 North Wisconsin
Darien, WI 53114

STATE OF WISCONSIN)
COUNTY OF WALWORTH)

I, George T. Dunham, Surveyor, certify that I have surveyed the property described as follows:

Outlot 119 of the Assessor's Plat of the Village of Walworth, Walworth County, Wisconsin, and that the map shown hereon is a correct representation thereof and shows the size and location of the property, its exterior boundaries, the location of all visible structures and dimensions of all principal buildings thereon, apparent easements, roadways and visible encroachments, if any, and that I have surveyed the property hereon described according to the official records, to the best of my knowledge and belief.
October 15, 1987

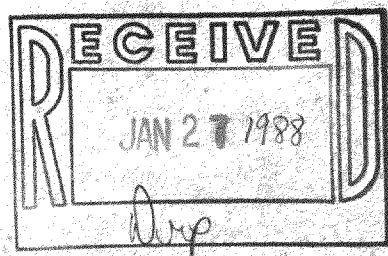

George T. Dunham
George T. Dunham, Surveyor

