RECEIVED
MAY 9 1988

WALWORTH COUNTY
SURVEYING & MAPPING
LAKE GENEVA, WISCONSIN

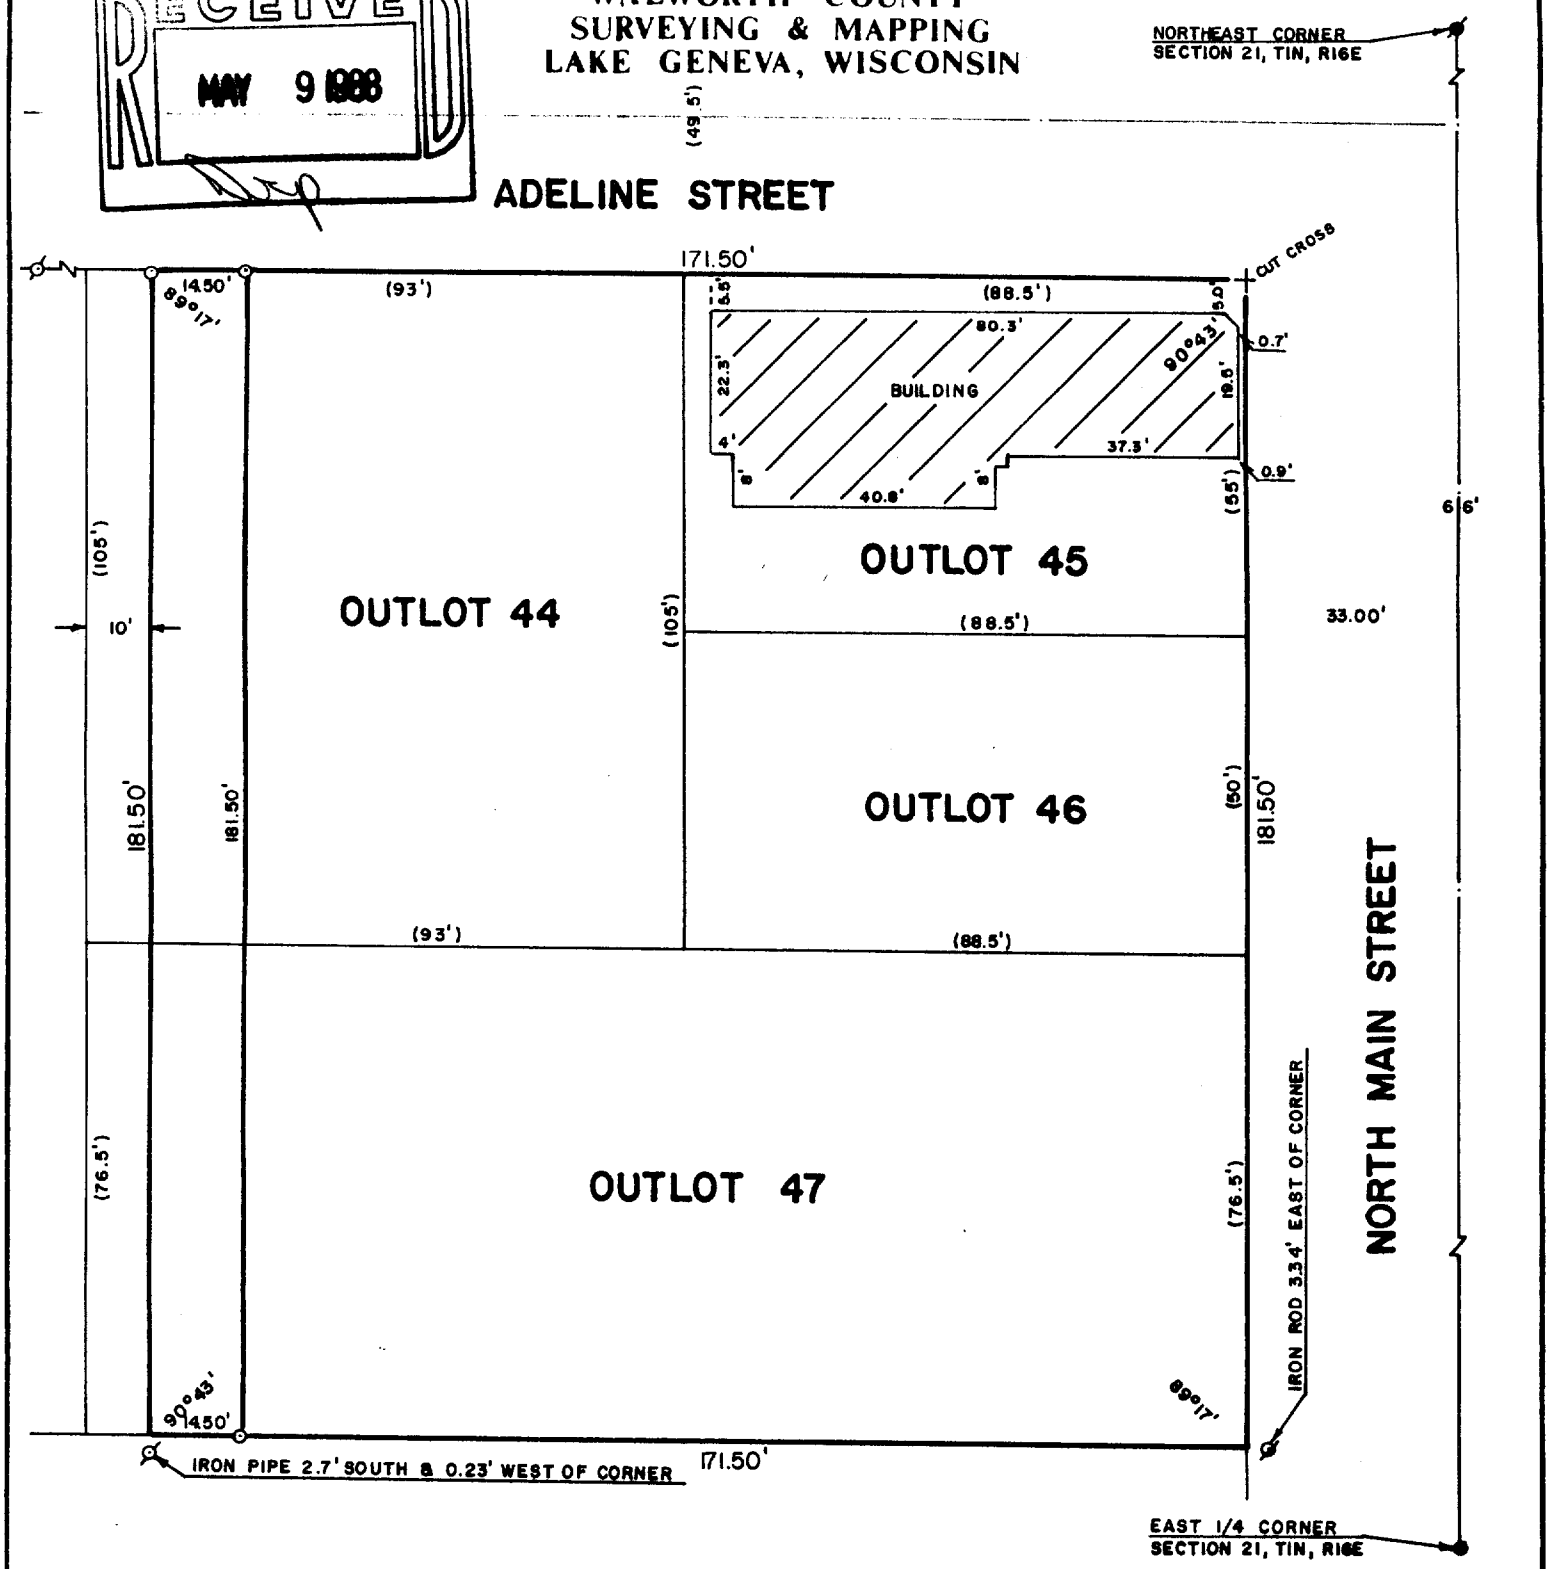

PLAT OF SURVEY OF

OUTLOTS 44, 45, 46 AND 47 OF THE ASSESSOR'S PLAT OF THE VILLAGE OF WALWORTH, WALWORTH COUNTY, WISCONSIN EXCEPTING THE WESTERLY 10 FEET OF OUTLOTS 44 AND 47.

ORDERED BY: VACATION PROPERTIES NETWORK
159 BROAD STREET
LAKE GENEVA, WISCONSIN
53147

REVISED: JANUARY 14, 1988

SCALE: 1"=30'

- ø -IRON PIPE FOUND
- ø -IRON ROD FOUND
- ● -IRON PLUG FOUND
- ø -CONCRETE MONUMENT FOUND
- o -IRON ROD PLACED
- ( )-RECORDED AS

I, ROBERT M. BAERENWALD, DO HEREBY CERTIFY THAT I HAVE SURVEYED THE PROPERTY HEREON DESCRIBED ACCORDING TO THE OFFICIAL RECORDS AND THAT THE PLAT HEREON IS A CORRECT REPRESENTATION OF THE PROPERTY LINES TO THE BEST OF MY KNOWLEDGE AND BELIEF.

Robert M. Baerenwald
ROBERT M. BAERENWALD
WISCONSIN REGISTERED LAND SURVEYOR, S-1508

Jan. 2, 1988
DATE JOB NO. 1366

NOTE: THIS IS NOT A CERTIFIED COPY UNLESS SEALED.

UWP-482