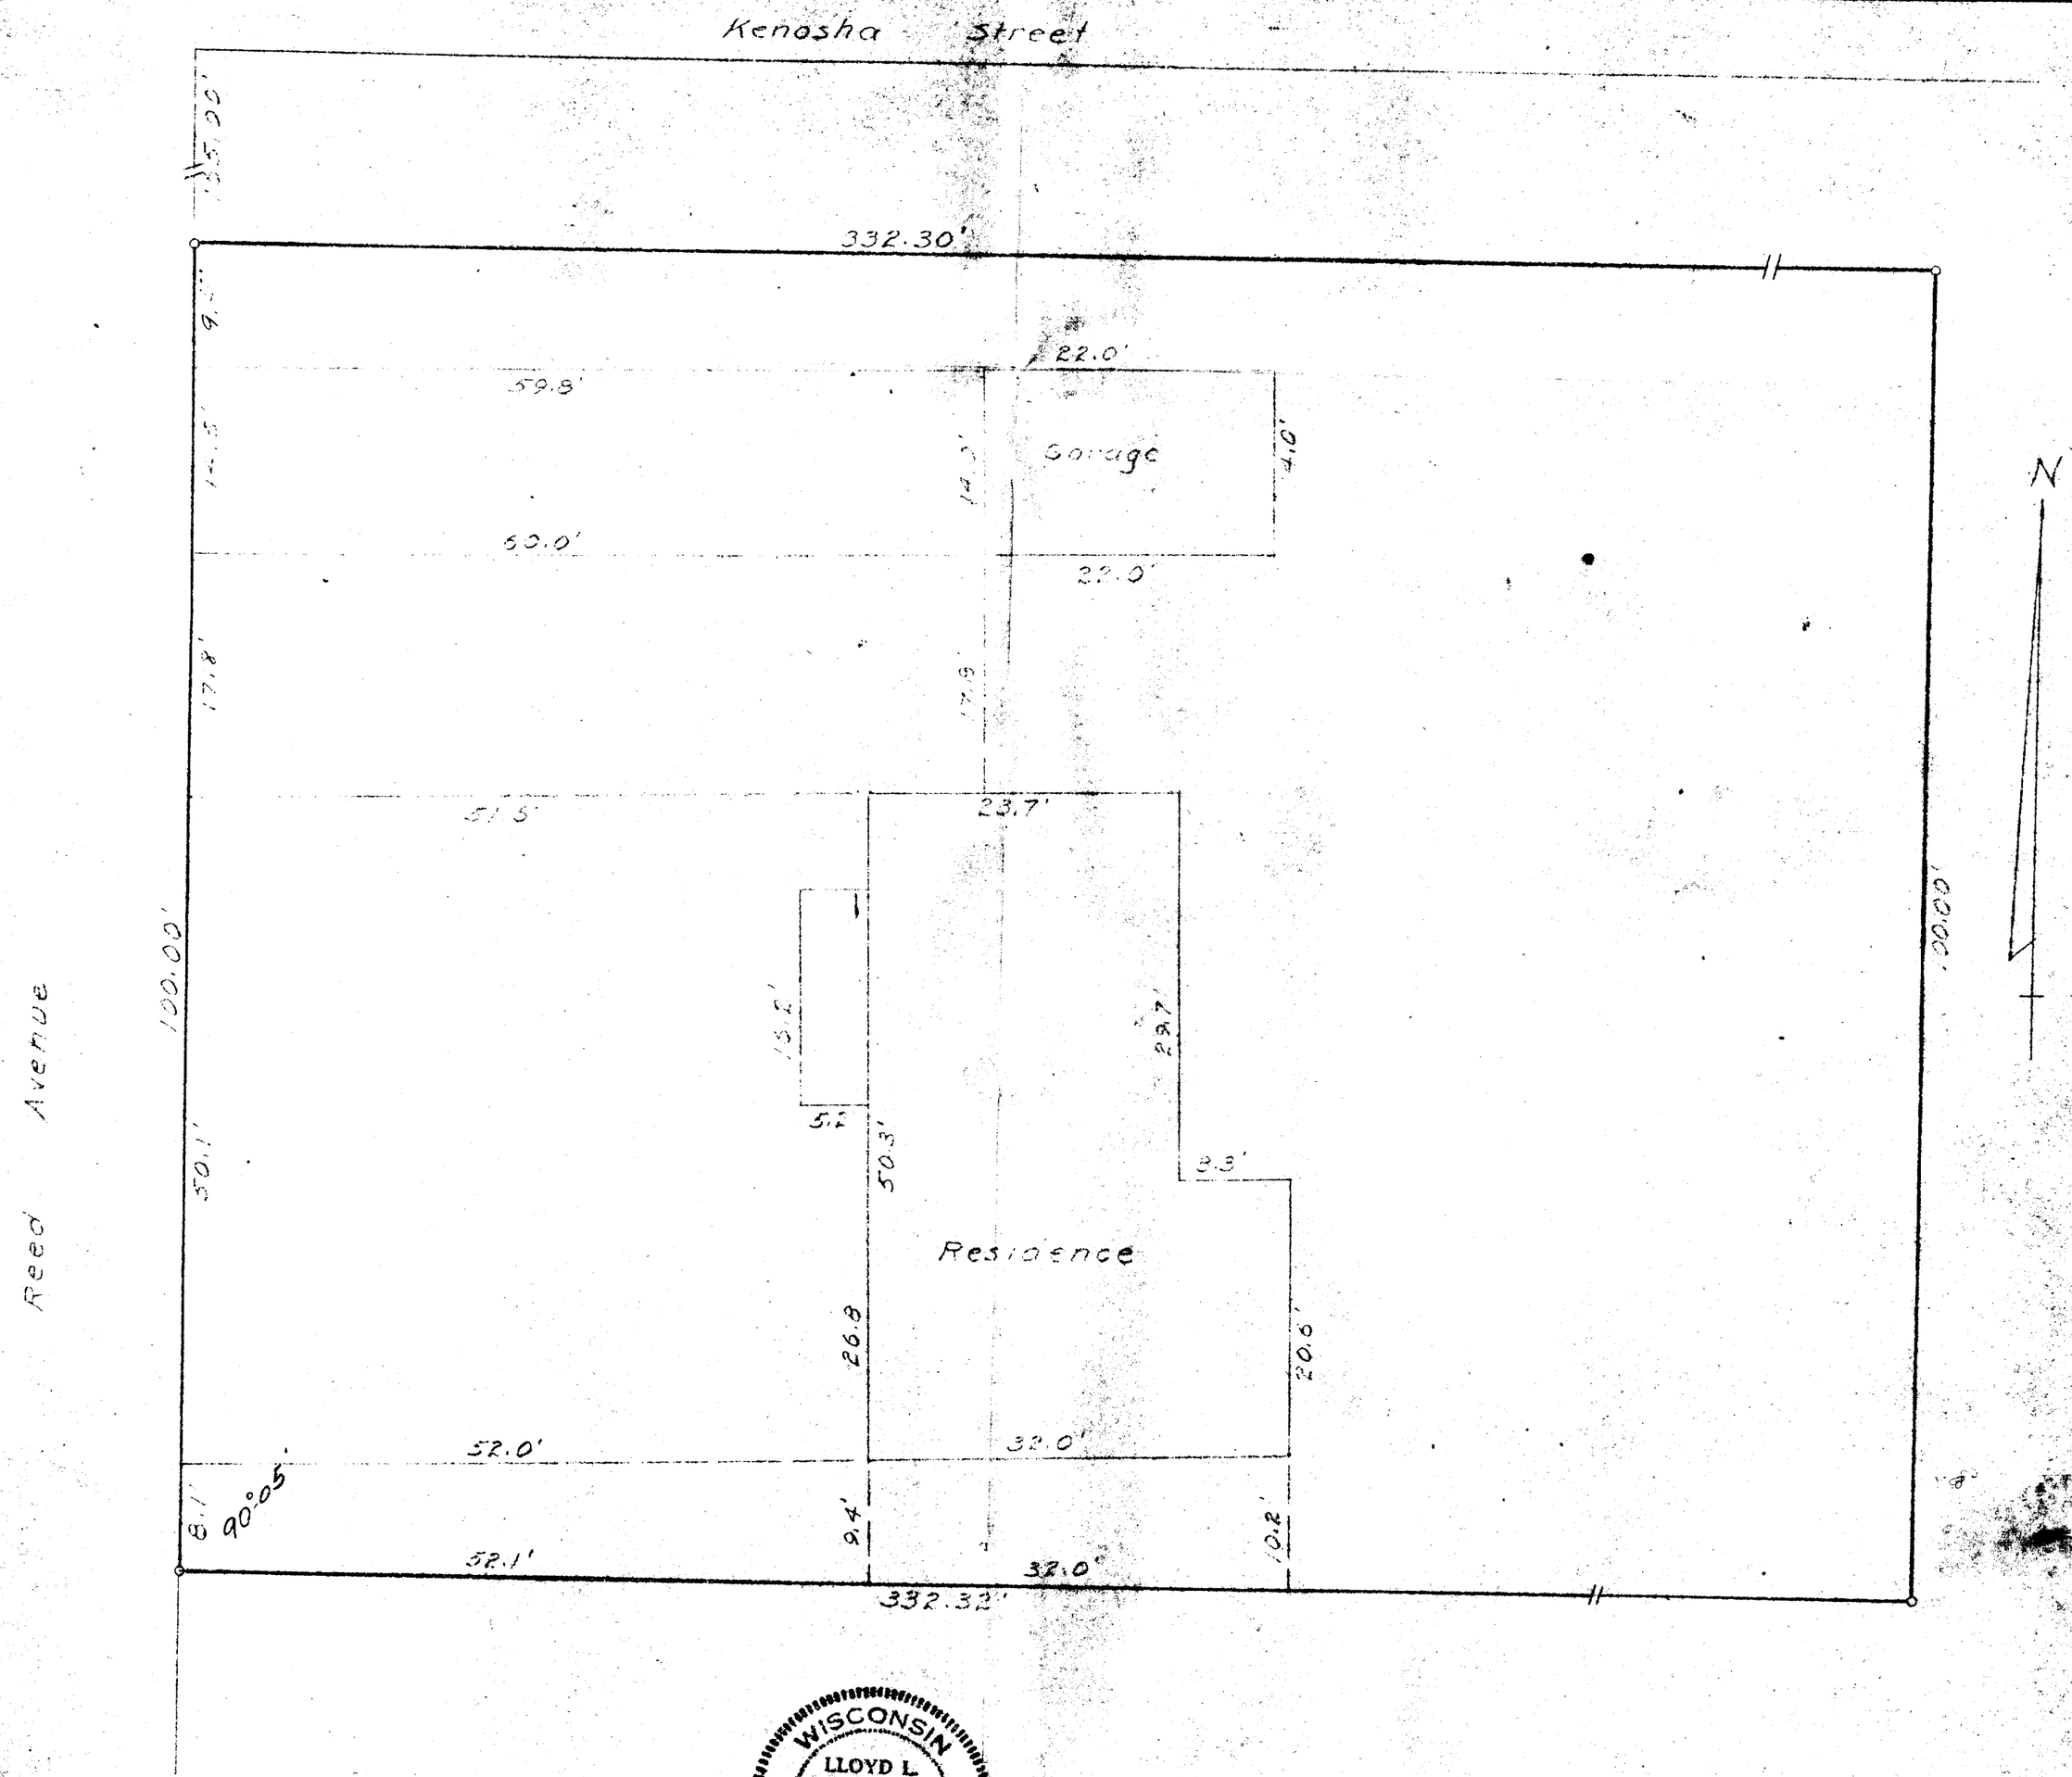

PLAT OF SURVEY
OF
Part of Outlot 218 of the Village of Walworth, Walworth County, Wisconsin

Lloyd L Jensen

SCALE 1" = 10'

DATE Aug. 1962

V.W.P. 293