


DUNHAM SURVEYING, S.C.
SURVEYING & SUBDIVIDING
DELAVER, WISCONSIN 53115

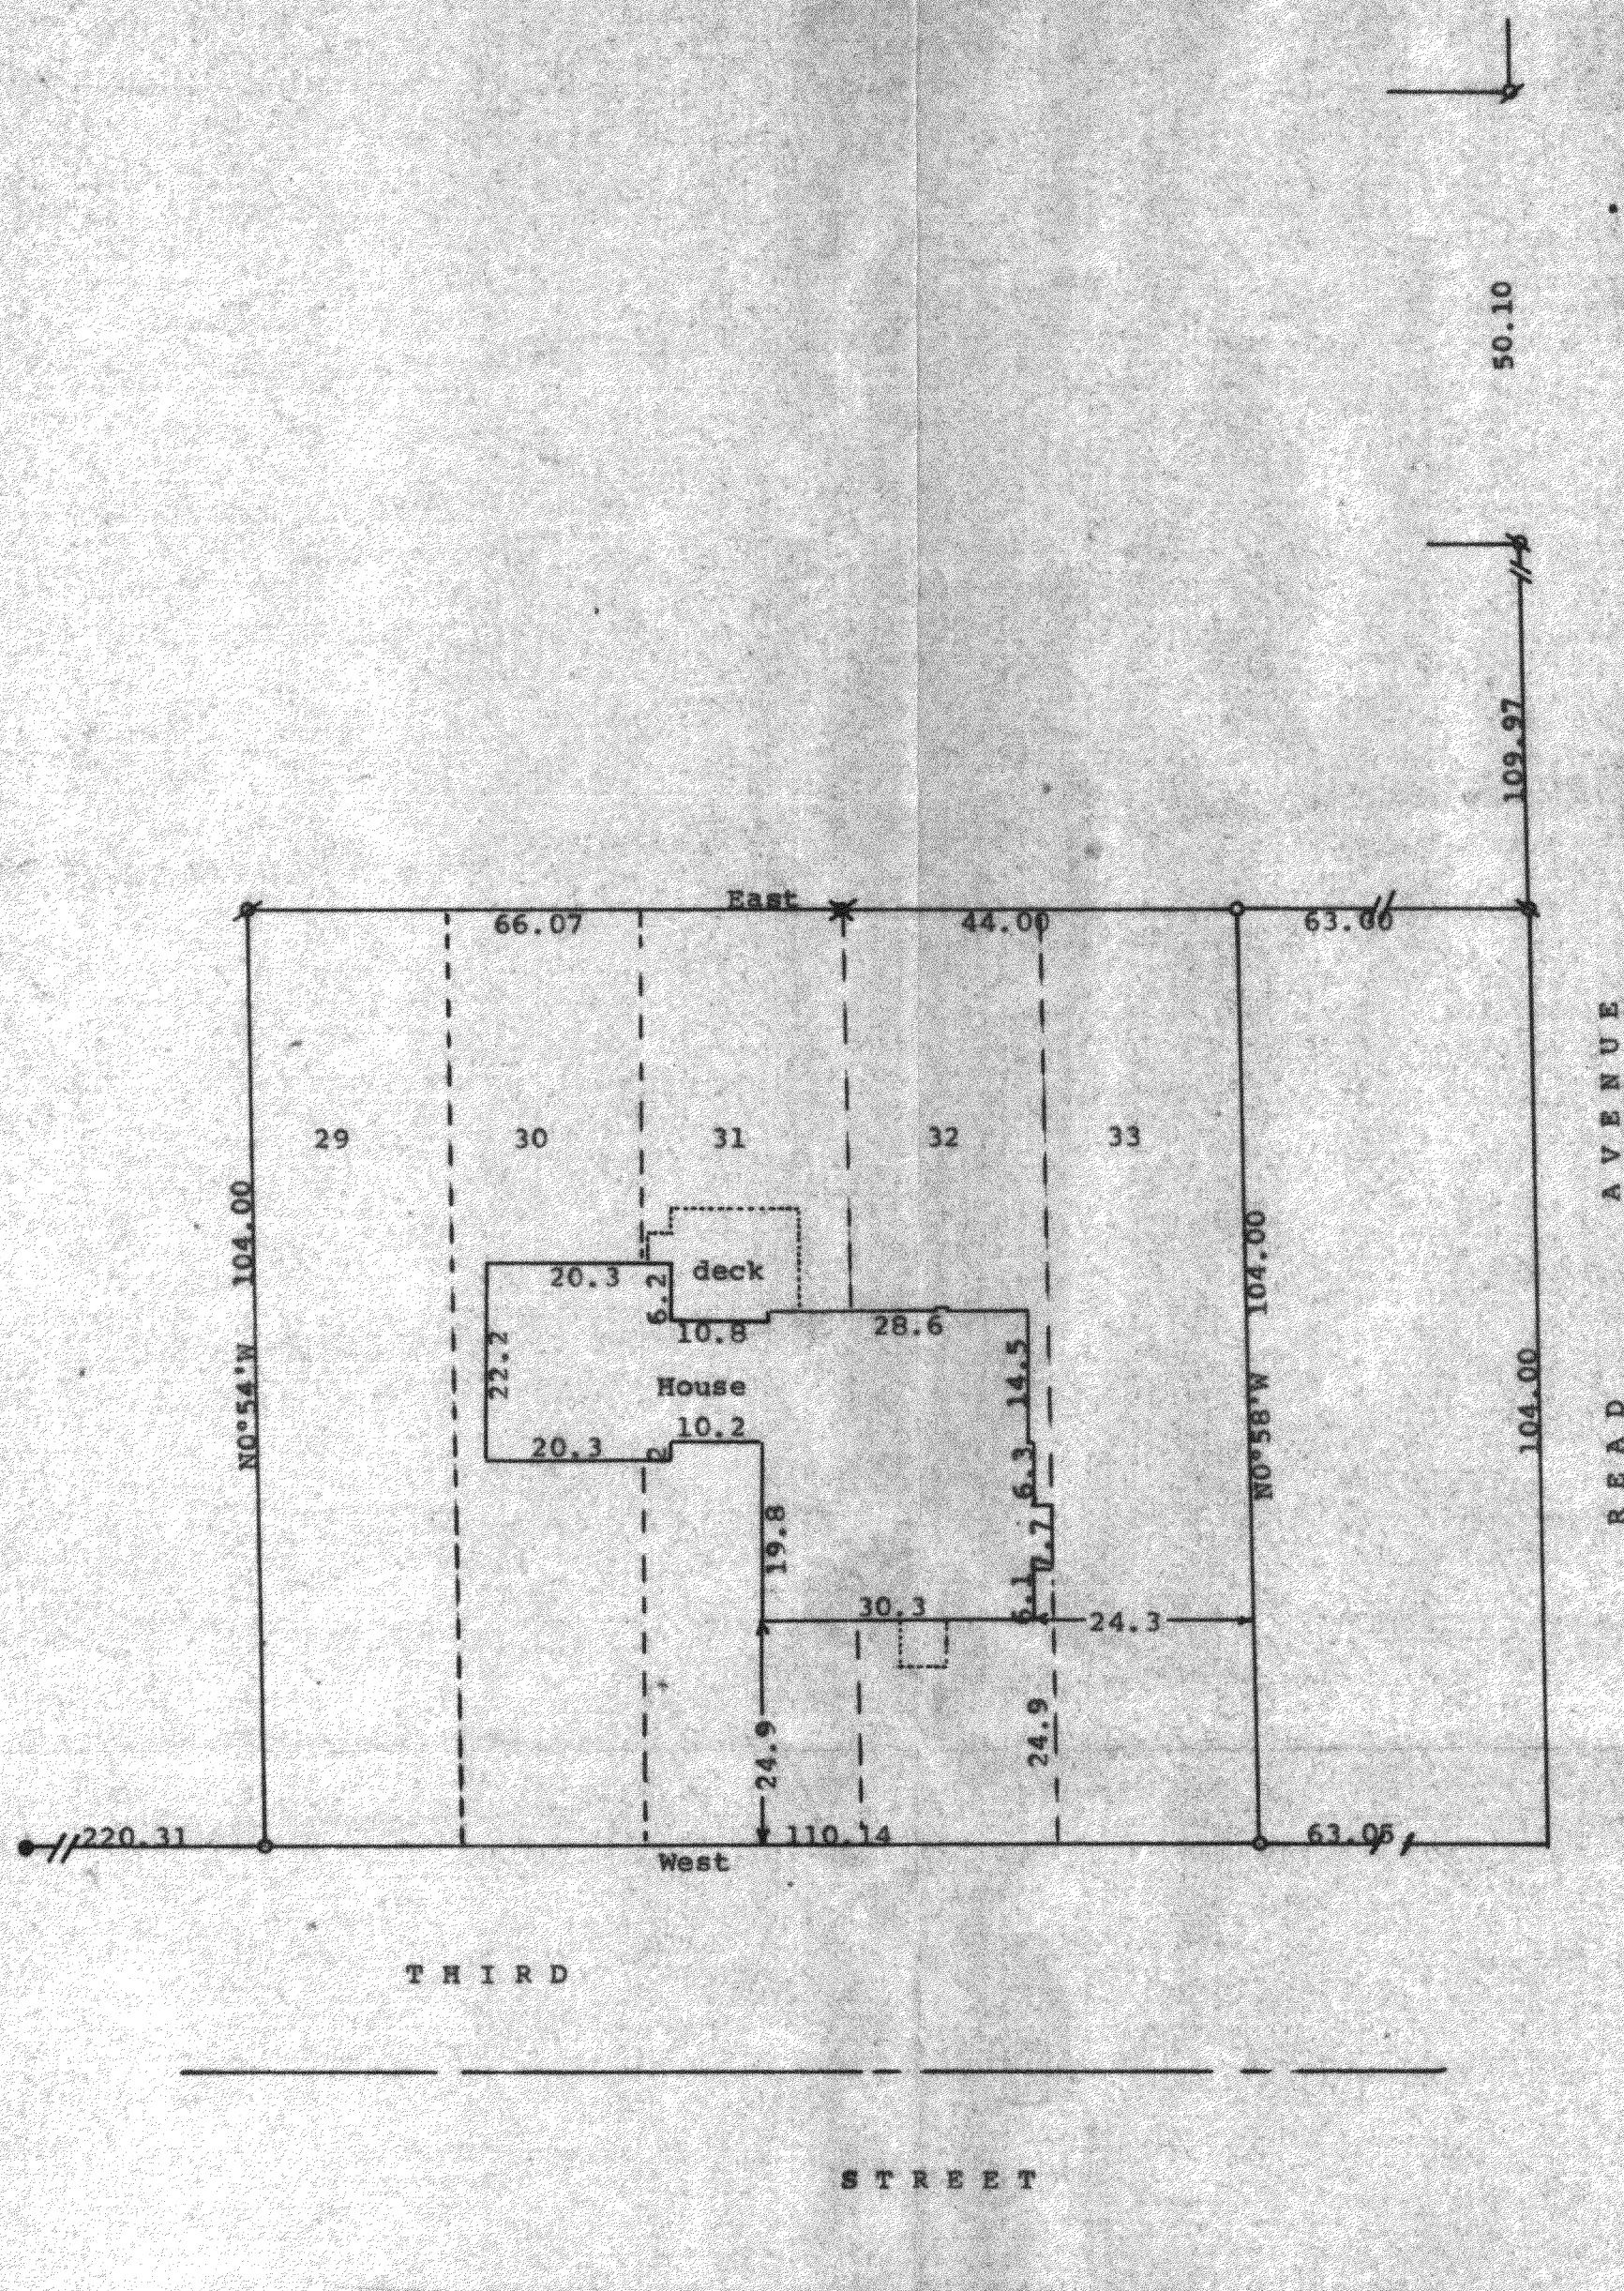

Scale - 1" = 20'
 ● = 1" Iron Pipe Found
 ■ = 3/4" Iron Pipe Found
 X = 1 1/4" Iron Pipe Found
 ○ = 3/4" X 24" Iron Pipe Set
 ● = concrete monument under concrete sidewalk, 0.47' South of the north edge of the walk


STATE OF WISCONSIN) SS
COUNTY OF WALWORTH)

I, George T. Dunham, Surveyor, certify that I have surveyed the property described as follows:

Lots 29, 30, 31, 32, and 33, all in Block 4, East Side Second Addition, Village of Walworth, Walworth County, Wisconsin

and that the plat shown hereon is a correct representation thereof and shows the size and location of the property, its exterior boundaries, the location of all visible structures and dimensions of all principal buildings thereon, boundary fences, apparent easements, roadways and visible encroachments, if any, and that I have surveyed the property hereon described, according to the official records, to the best of my knowledge and belief.

October 24, 1988

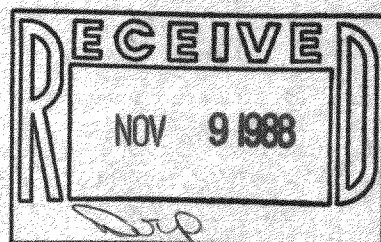

George T. Dunham
George T. Dunham, Surveyor

