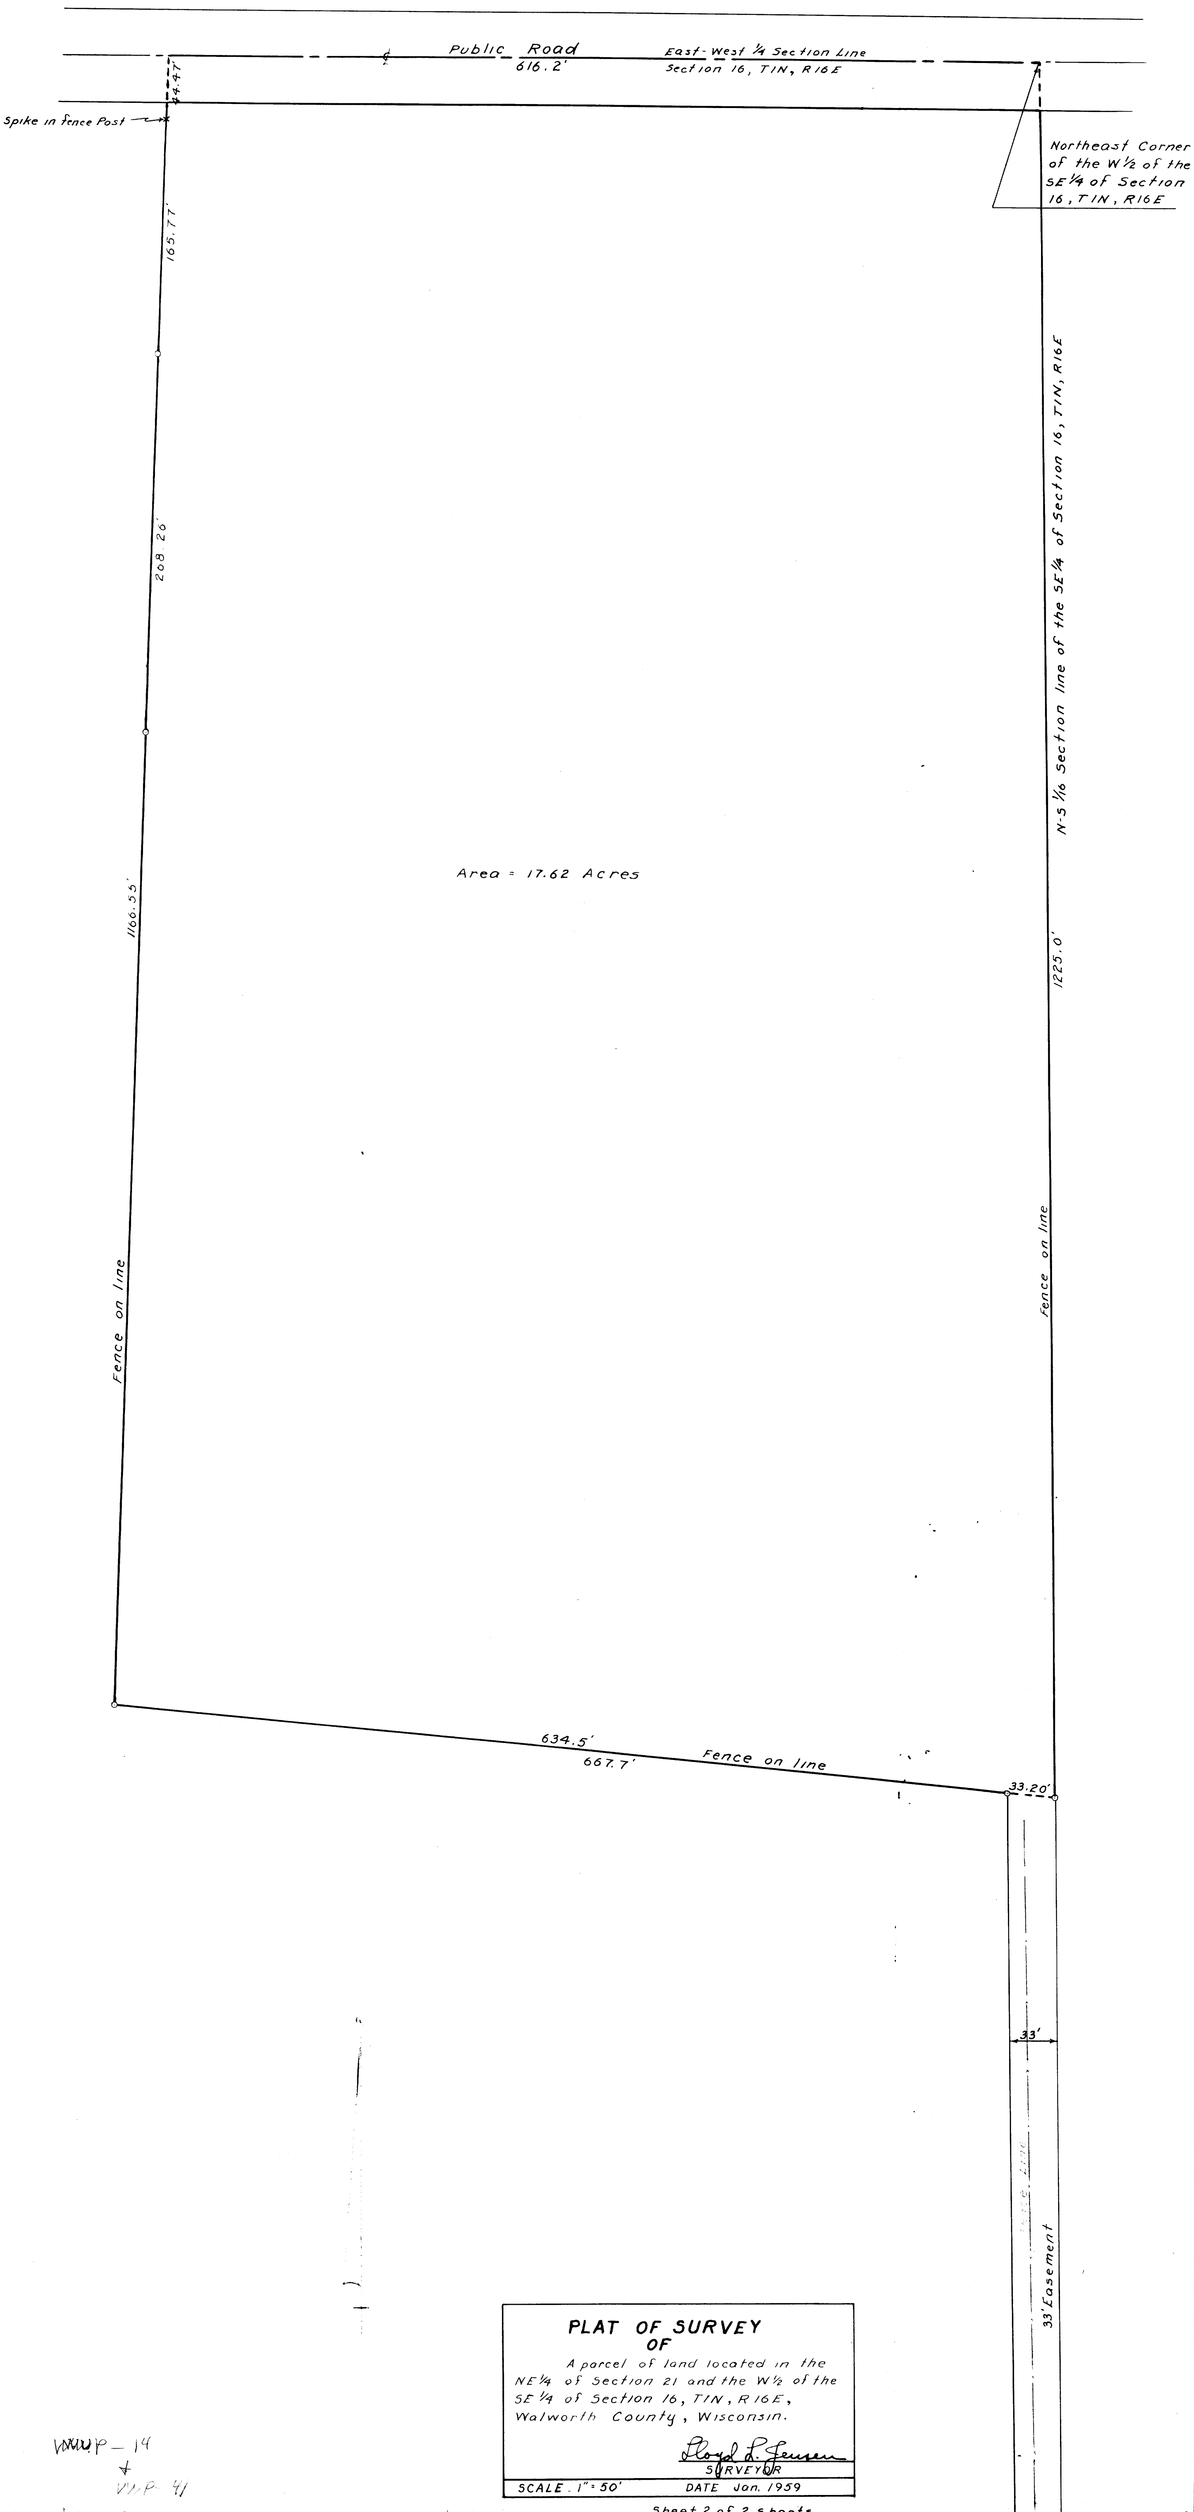


PLAT OF SURVEY OF

A parcel of land located in the NE¼ of Section 21 and the W½ of the SE¼ of Section 16, T1N, R16E, Walworth County, Wisconsin.

Floyd L. Jensen
SURVEYOR

SCALE 1" = 50' DATE Jan. 1959

Sheet 2 of 2 Sheets

WWP-14
+
WWP-41

9-34