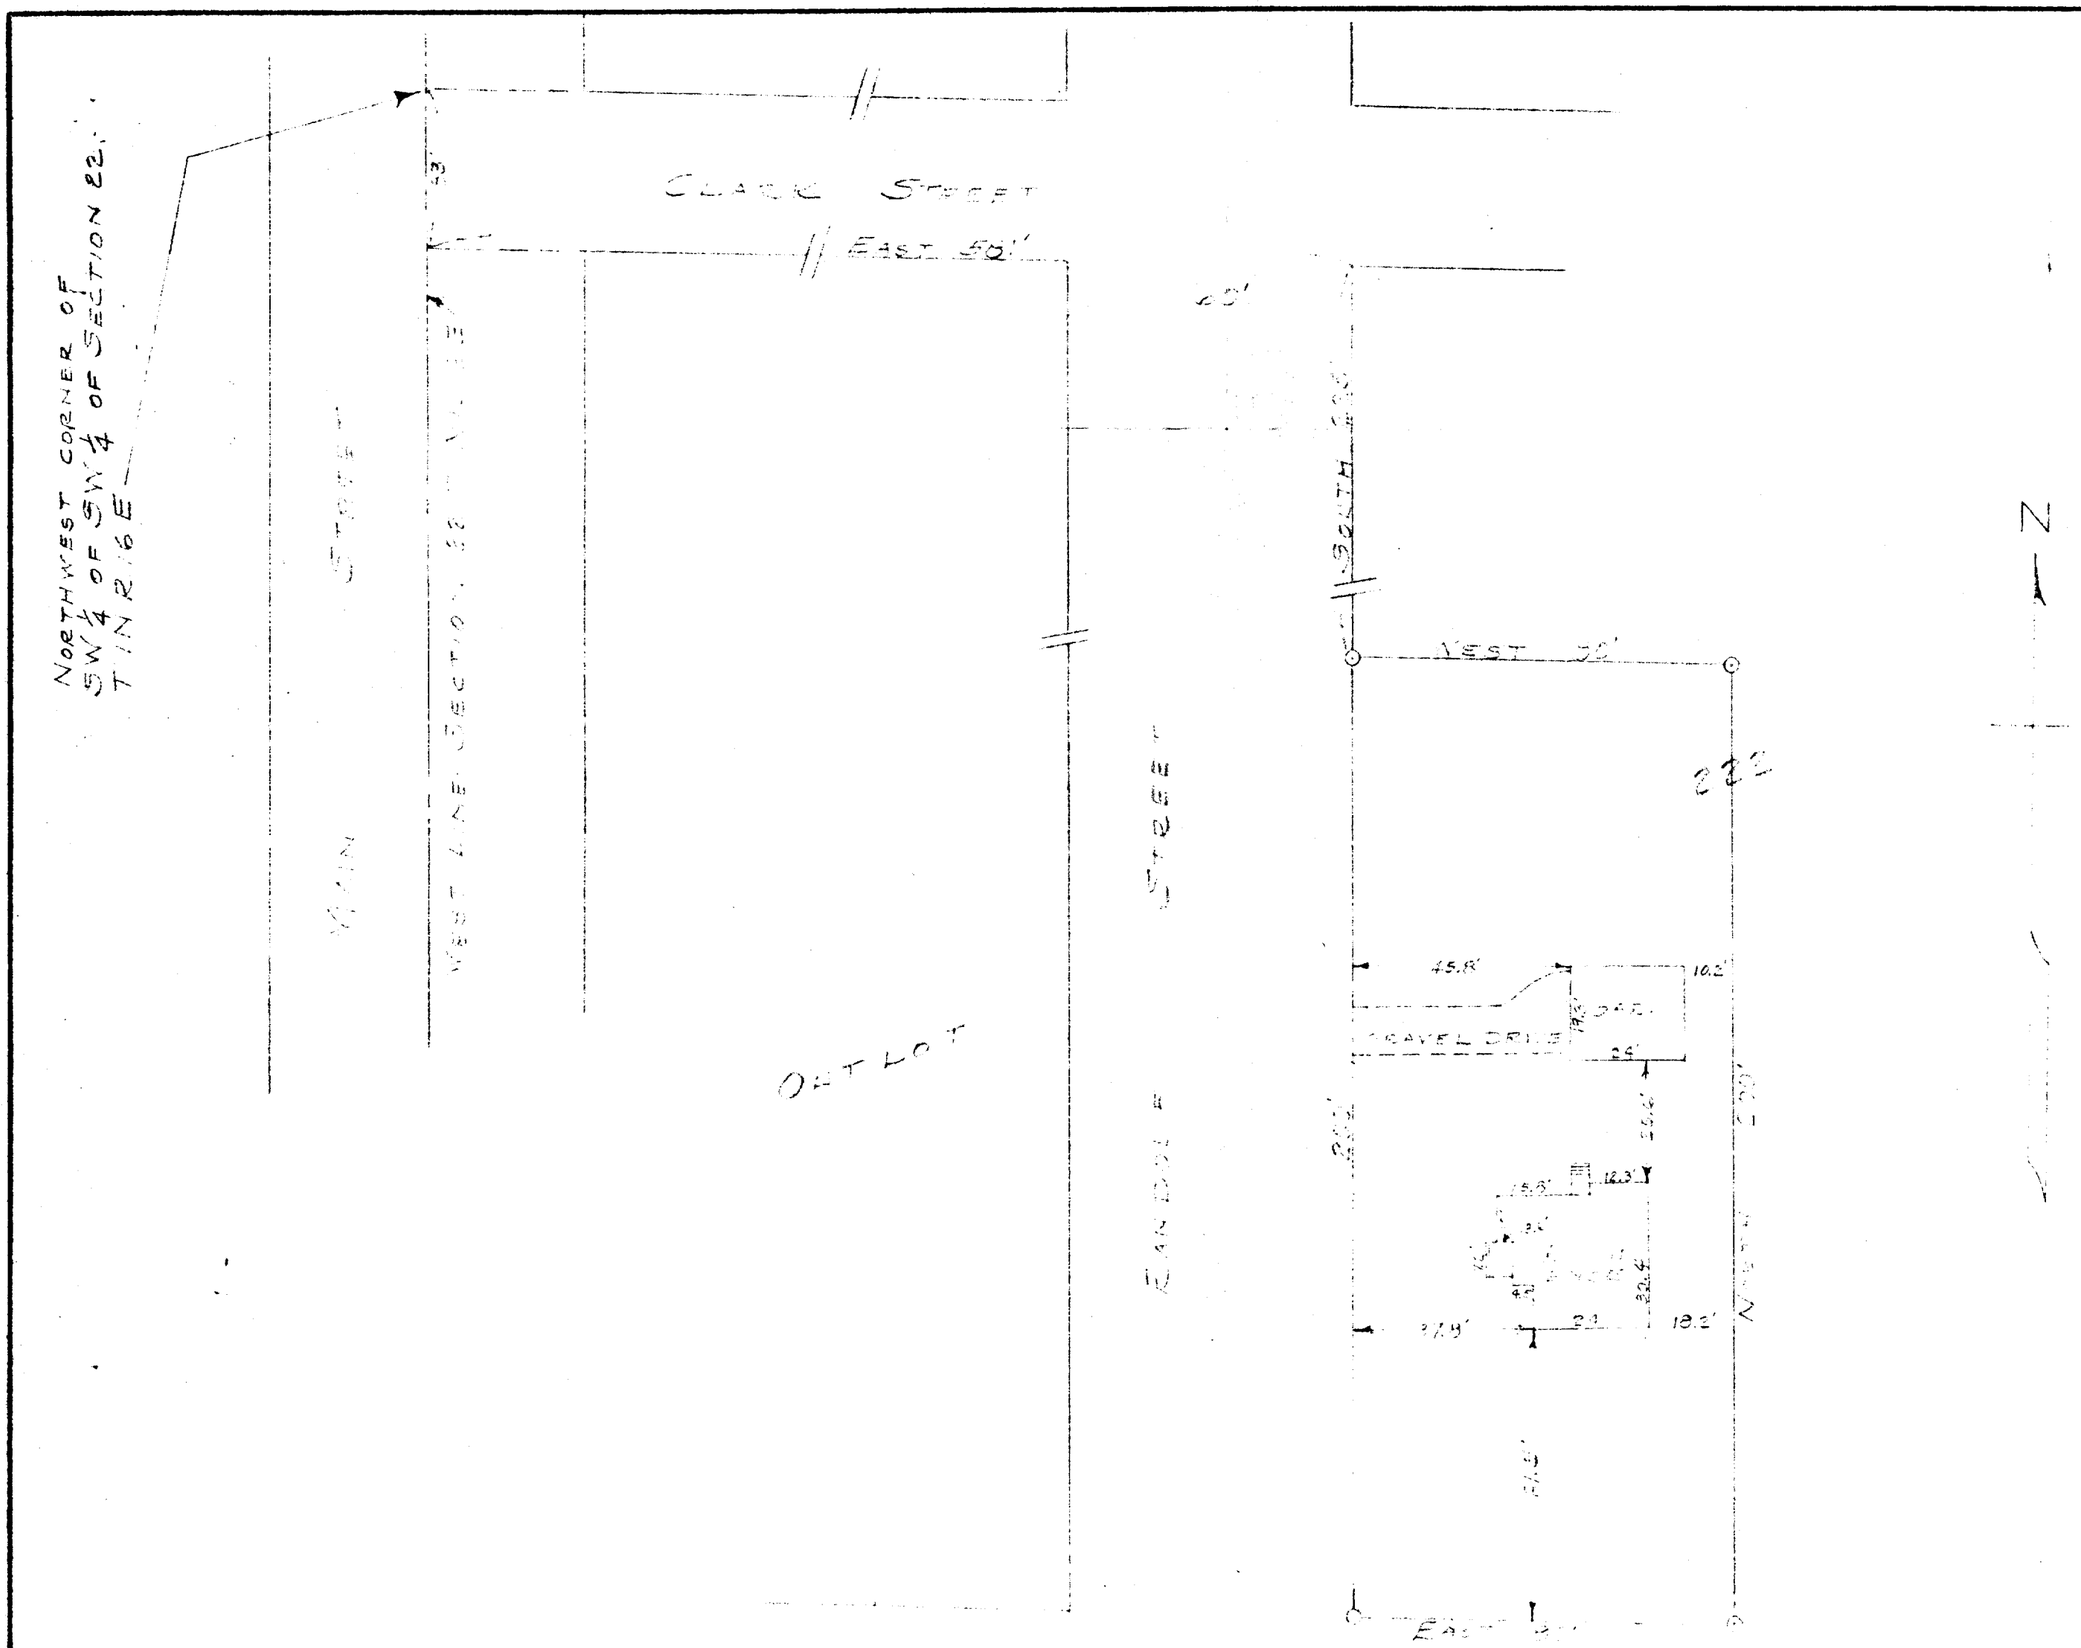


I hereby certify that I have made a survey of the following described parcel of land:

A parcel of land located in the Sw 1/4 of the Sw 1/4 of Sec. 22 T.1 N. R. 16 E. of Walworth County, Wisconsin, described as follows, to-wit: Commencing at the NW corner of said Sw 1/4 of the Sw 1/4 of Sec. 22, thence S. along the W. line of said Sec., 33 ft; thence E. parallel to the E-W 1/8th Sec. line in said Sw 1/4, 581 ft., thence S. parallel to the W. line of said Sec. 22, a distance of 225 ft. to the place of beginning; thence continue S. parallel to the W. line of said Sec. 22, a distance of 200 ft; thence E. parallel to the S. line of said Sec. 22, a distance of 80 ft; thence N. parallel to the W. line of said Sec. 22 a distance of 200 ft; thence W. 80 ft. to the place of beginning; said real estate being a portion of Outlot 222 of the Assessor's Plat of the Village of Walworth, Walworth County, Wisconsin, and that we have shown all buildings located thereon.

County Surveyor

WISCONSIN
LLOYD L. JENSEN
S-211
ELKHORN, WIS.
REGISTERED LAND SURVEYOR

PLAT OF SURVEY
OF
LAND
LOCATED IN THE SW 1/4 OF SW 1/4
OF SECTION 22 T1N R16E
OF WALWORTH COUNTY
WISCONSIN

SURVEYOR

SCALE 1" = 30'

DATE MAY 1960

NO. 1781-400-1-30-58

VWP-314

9-35