



DUNHAM SURVEYING, S.C.
SURVEYING & SUBDIVIDING
DELAVAN, WISCONSIN 53115

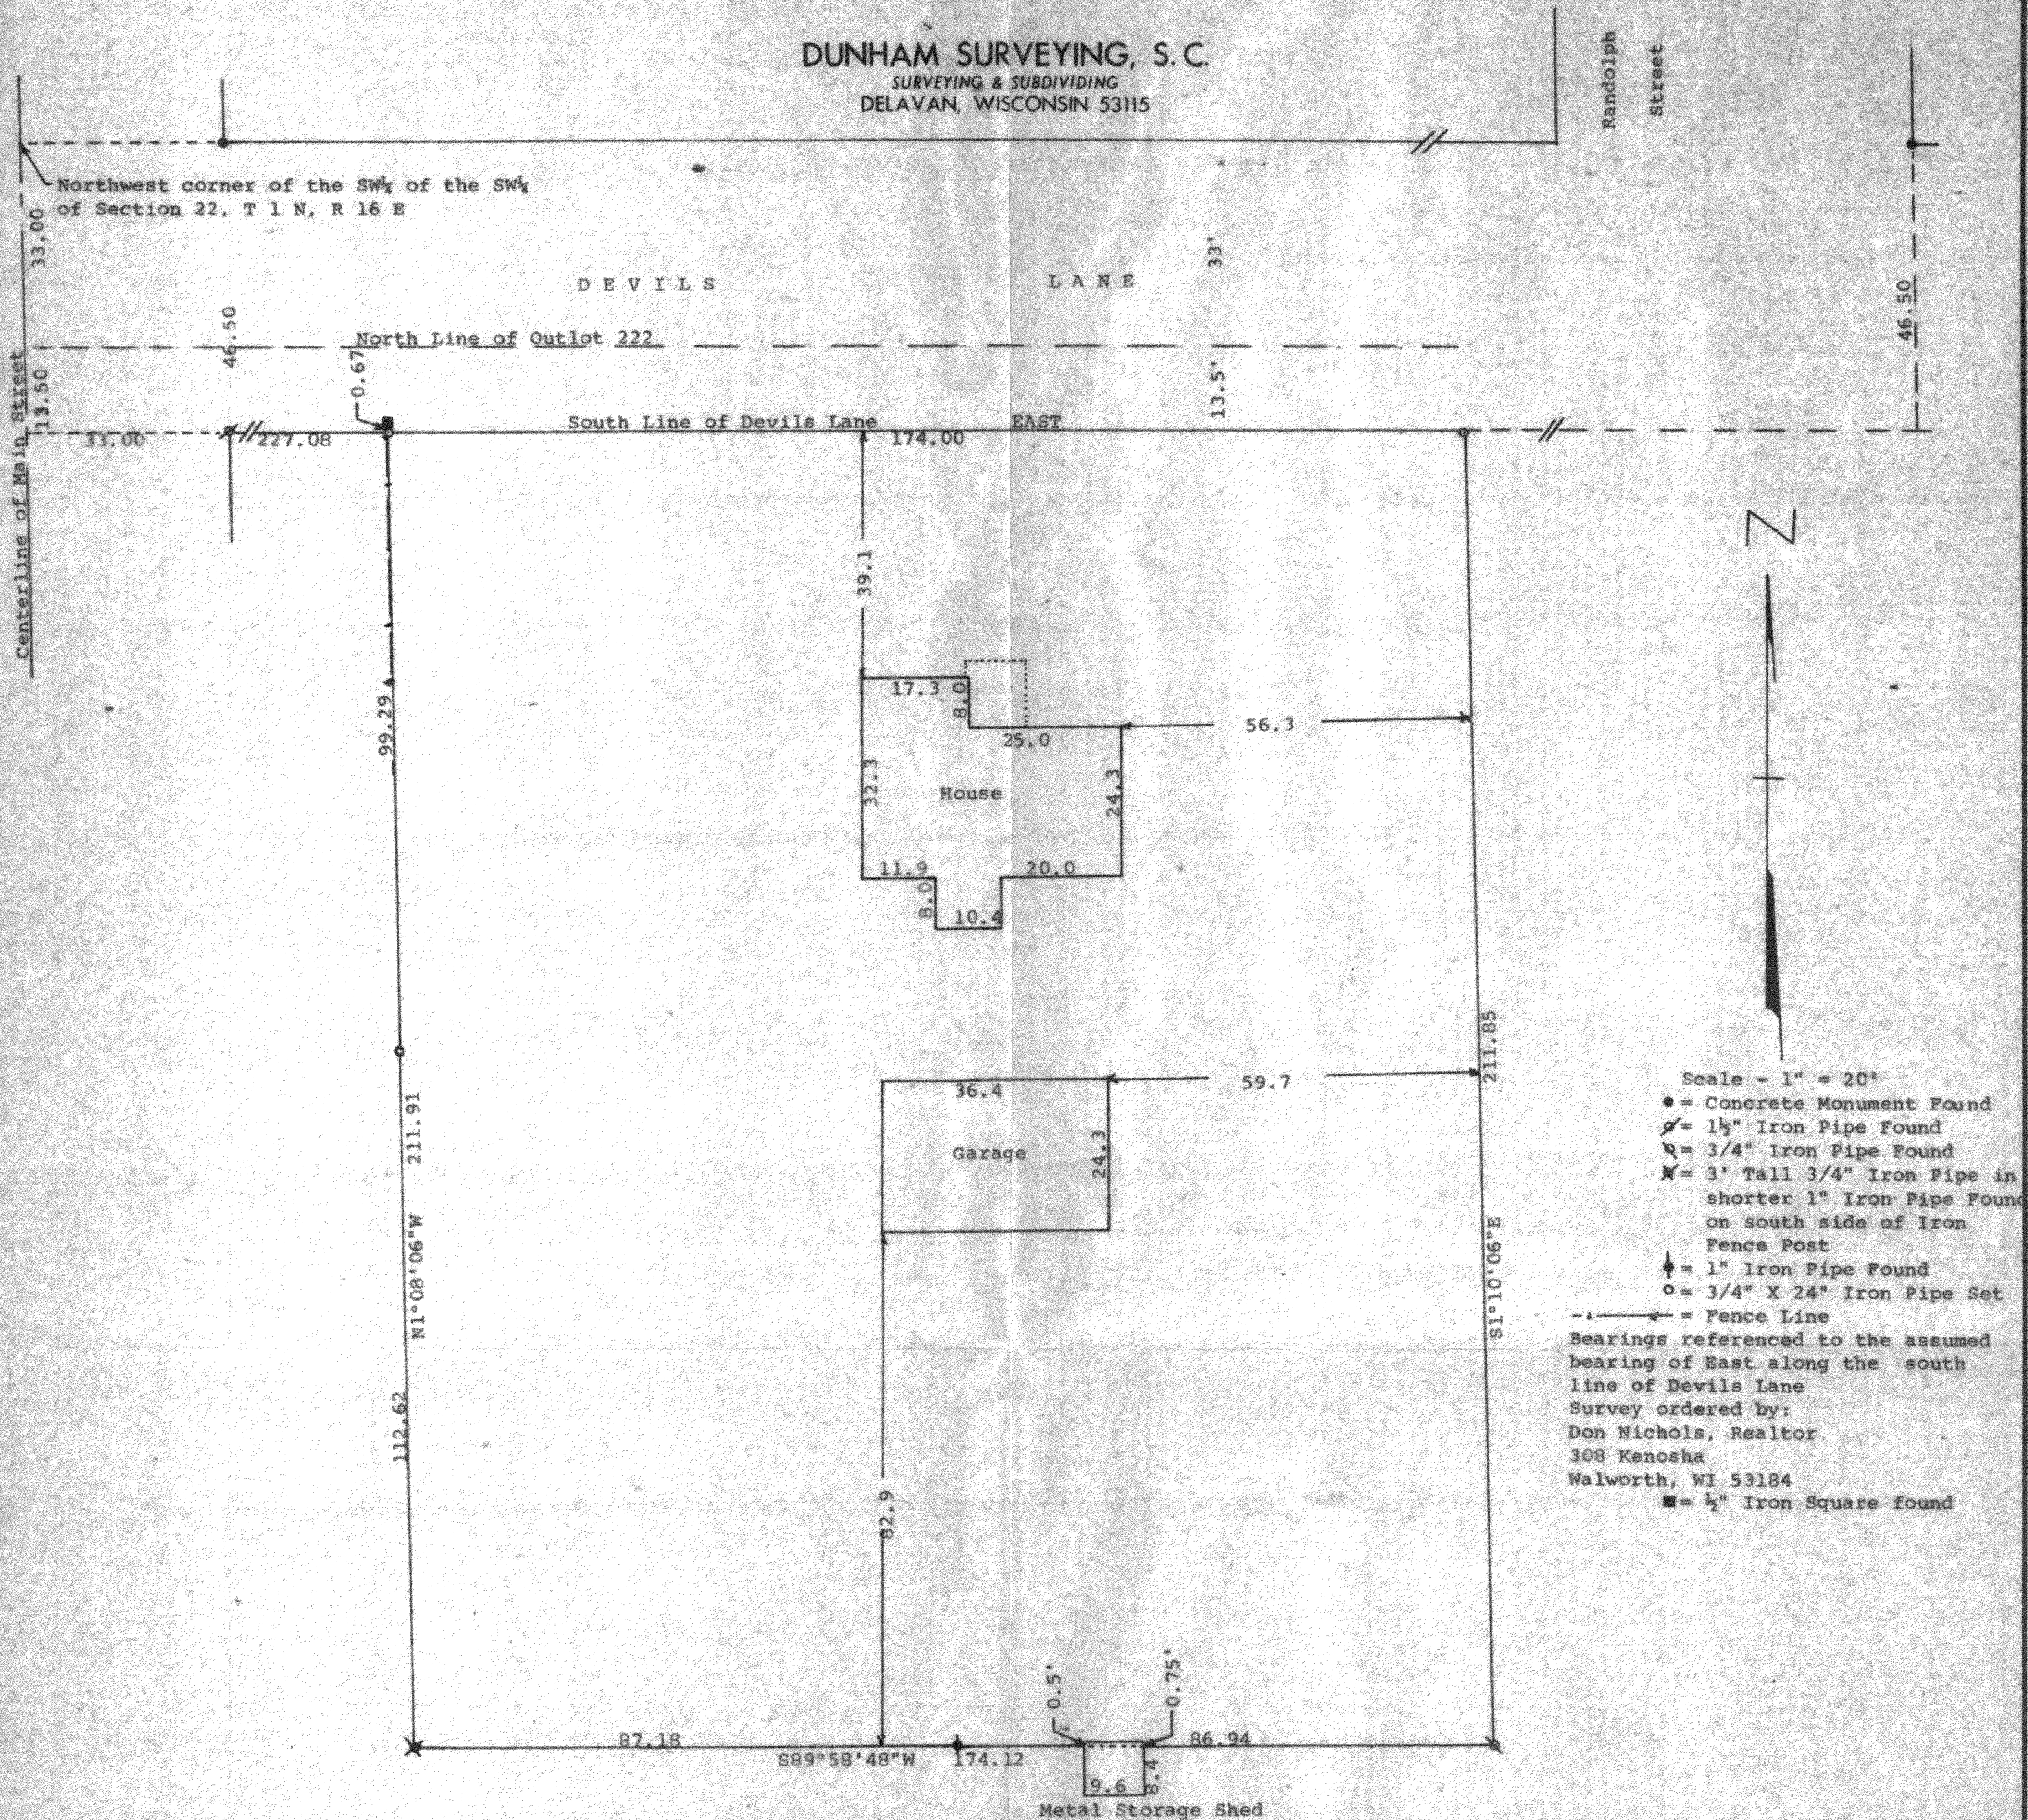

STATE OF WISCONSIN)
COUNTY OF WALWORTH)

I, George T. Dunham, Surveyor, certify that I have surveyed the property described as follows:

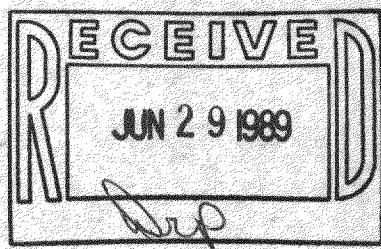

A parcel of land located in the Southwest $\frac{1}{4}$ of the Southwest $\frac{1}{4}$ of Section 22, T 1 N, R 16 E, Village of Walworth, Walworth County, Wisconsin, described as follows: Commencing at the northwest corner of said Southwest $\frac{1}{4}$ of the Southwest $\frac{1}{4}$ of said section; thence South along the west line of said Section 33.00 feet; thence East parallel with the east-west 1/8th section line in said Southwest $\frac{1}{4}$, 260 feet to the place of beginning; thence continue East on the same line 174 feet; thence South parallel with the west line of said section 225 feet; thence West 174 feet; thence North 225 feet to the place of beginning, EXCEPTING THEREFROM the North 13.50 feet of the above described land previously deeded to the Village of Walworth for road right of way purposes

and that the plat shown hereon is a correct representation thereof and shows the size and location of the property, its exterior boundaries, the location of all visible structures and dimensions of all principal buildings thereon, boundary fences, apparent easements, roadways and visible encroachments, if any, and that I have surveyed the property hereon described, according to the official records, to the best of my knowledge and belief.

January 5, 1989

George T. Dunham
George T. Dunham, Surveyor

