



DUNHAM SURVEYING, S.C.
SURVEYING & SUBDIVIDING
DELAVER, WISCONSIN 53115

FIFTH

STREET

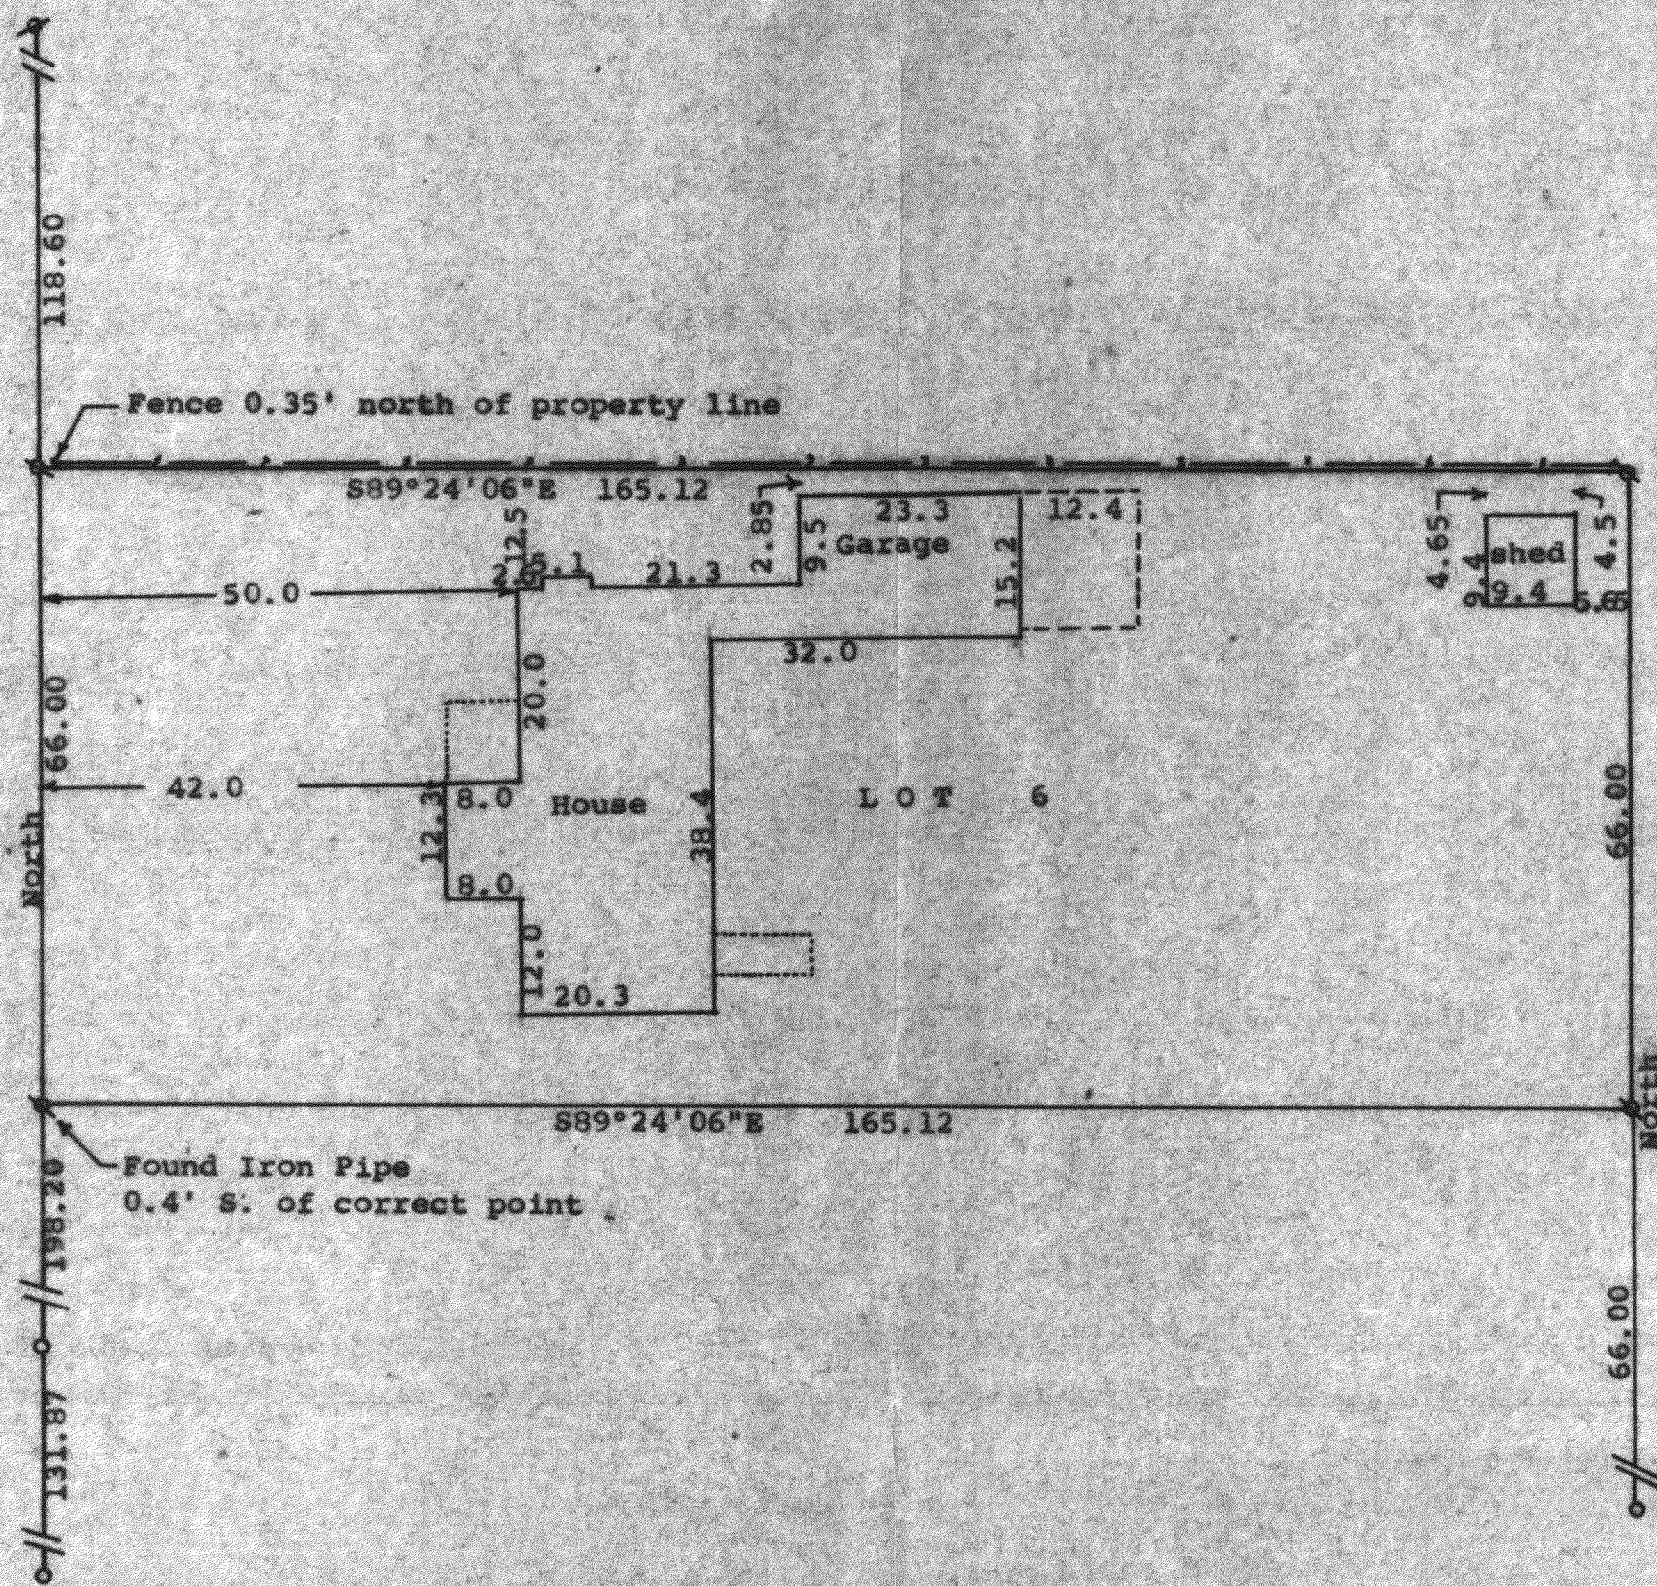

Scale - 1" = 20'
 o = 1/2" Iron Pipe Found
 o = 1" Iron Pipe Found
 o = 3/4" Iron Pipe Found
 --- = Fence Line
 Bearings referenced to the east line
 of Fifth Street with the assumed
 bearing of North.
 Survey ordered by:
 Churchill Real Estate
 322 Park
 Walworth, WI 53184

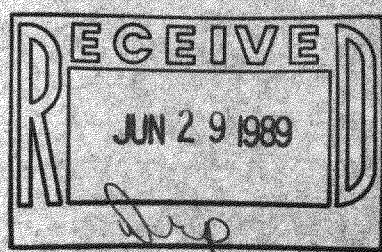

STATE OF WISCONSIN) SS
COUNTY OF WALWORTH)

I, George T. Dunham, Surveyor, certify that I have surveyed the property described as follows:

Lot 6 in Block 1 of E. W. Crumbs Addition to the Village of Walworth, Walworth County, Wisconsin.

and that the plat shown hereon is a correct representation thereof and shows the size and location of the property, its exterior boundaries, the location of all visible structures and dimensions of all principal buildings thereon, boundary fences, apparent easements, roadways and visible encroachments, if any, and that I have surveyed the property hereon described, according to the official records, to the best of my knowledge and belief.

November 11, 1988

George T. Dunham
George T. Dunham, Surveyor

