
120/72

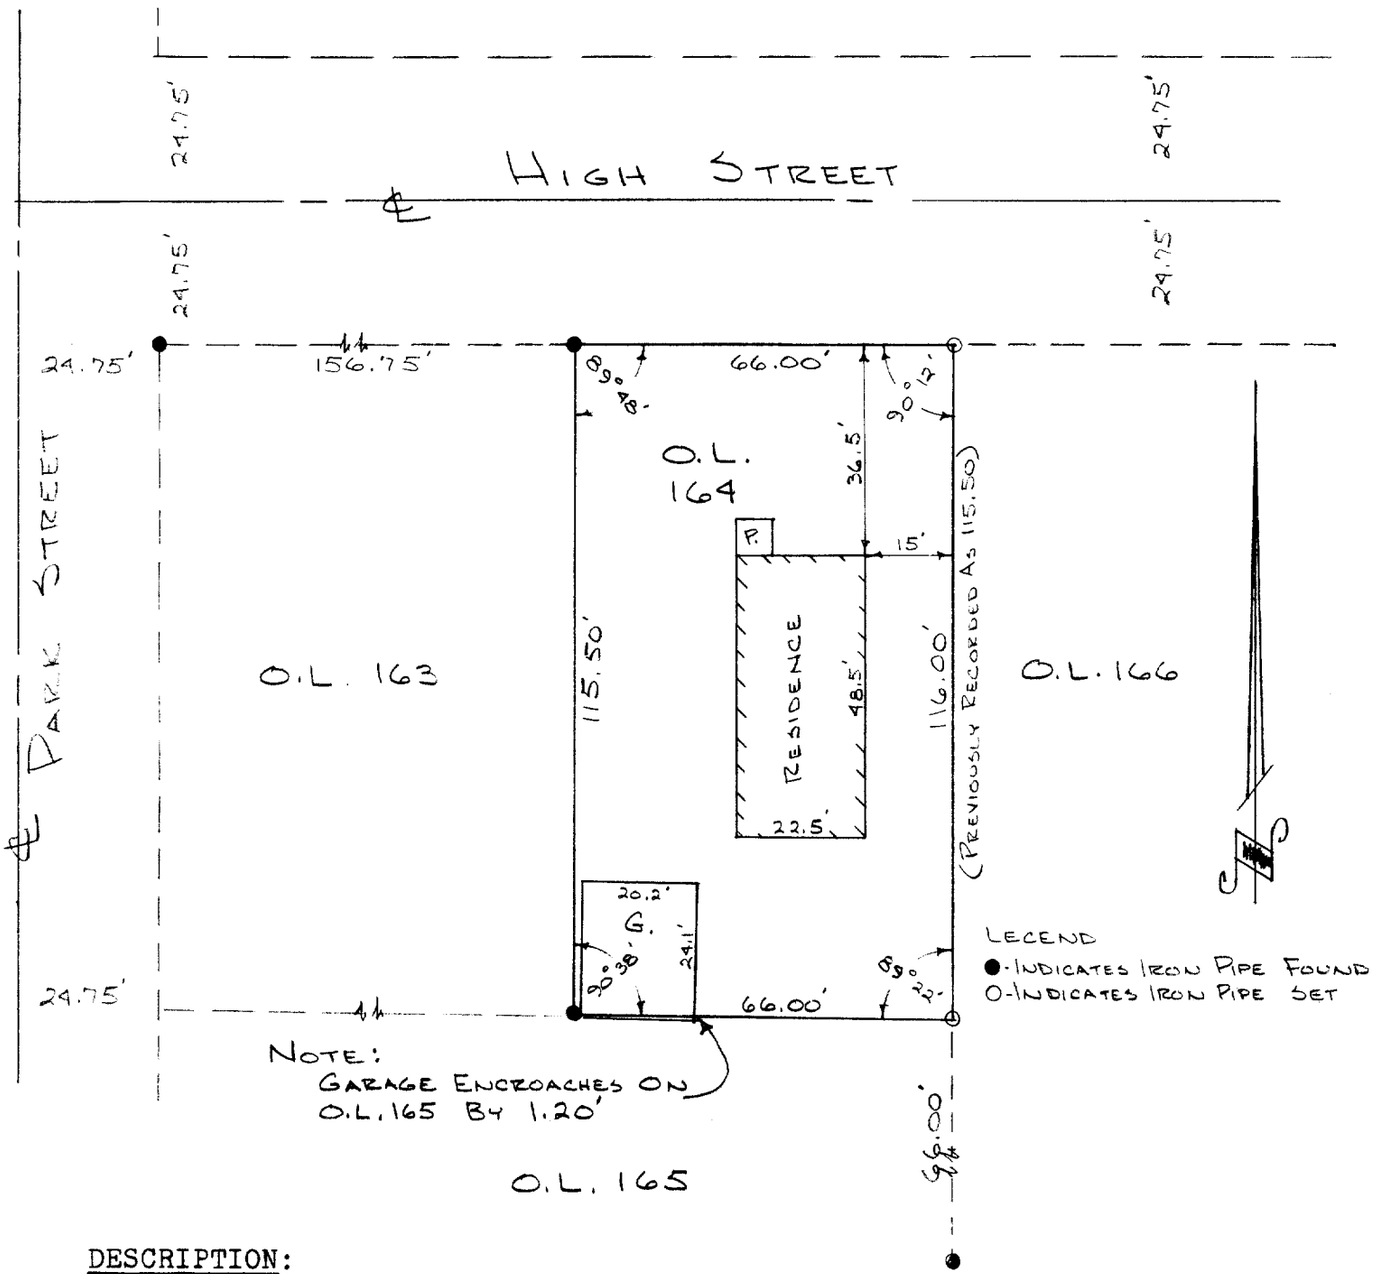

DESCRIPTION:
Out Lot 164 of Assessors Plat, Village of Walworth, Walworth County, Wisconsin.

CERTIFICATE:
I, James F. Biagi, surveyor, do hereby certify that I have surveyed the lands hereon described.

September 27, 1972

James F. Biagi RLS #272

WISCONSIN JAMES F. BIAGI MILWAUKEE, WIS LAND SURVEYOR

VWP 191

9-3B