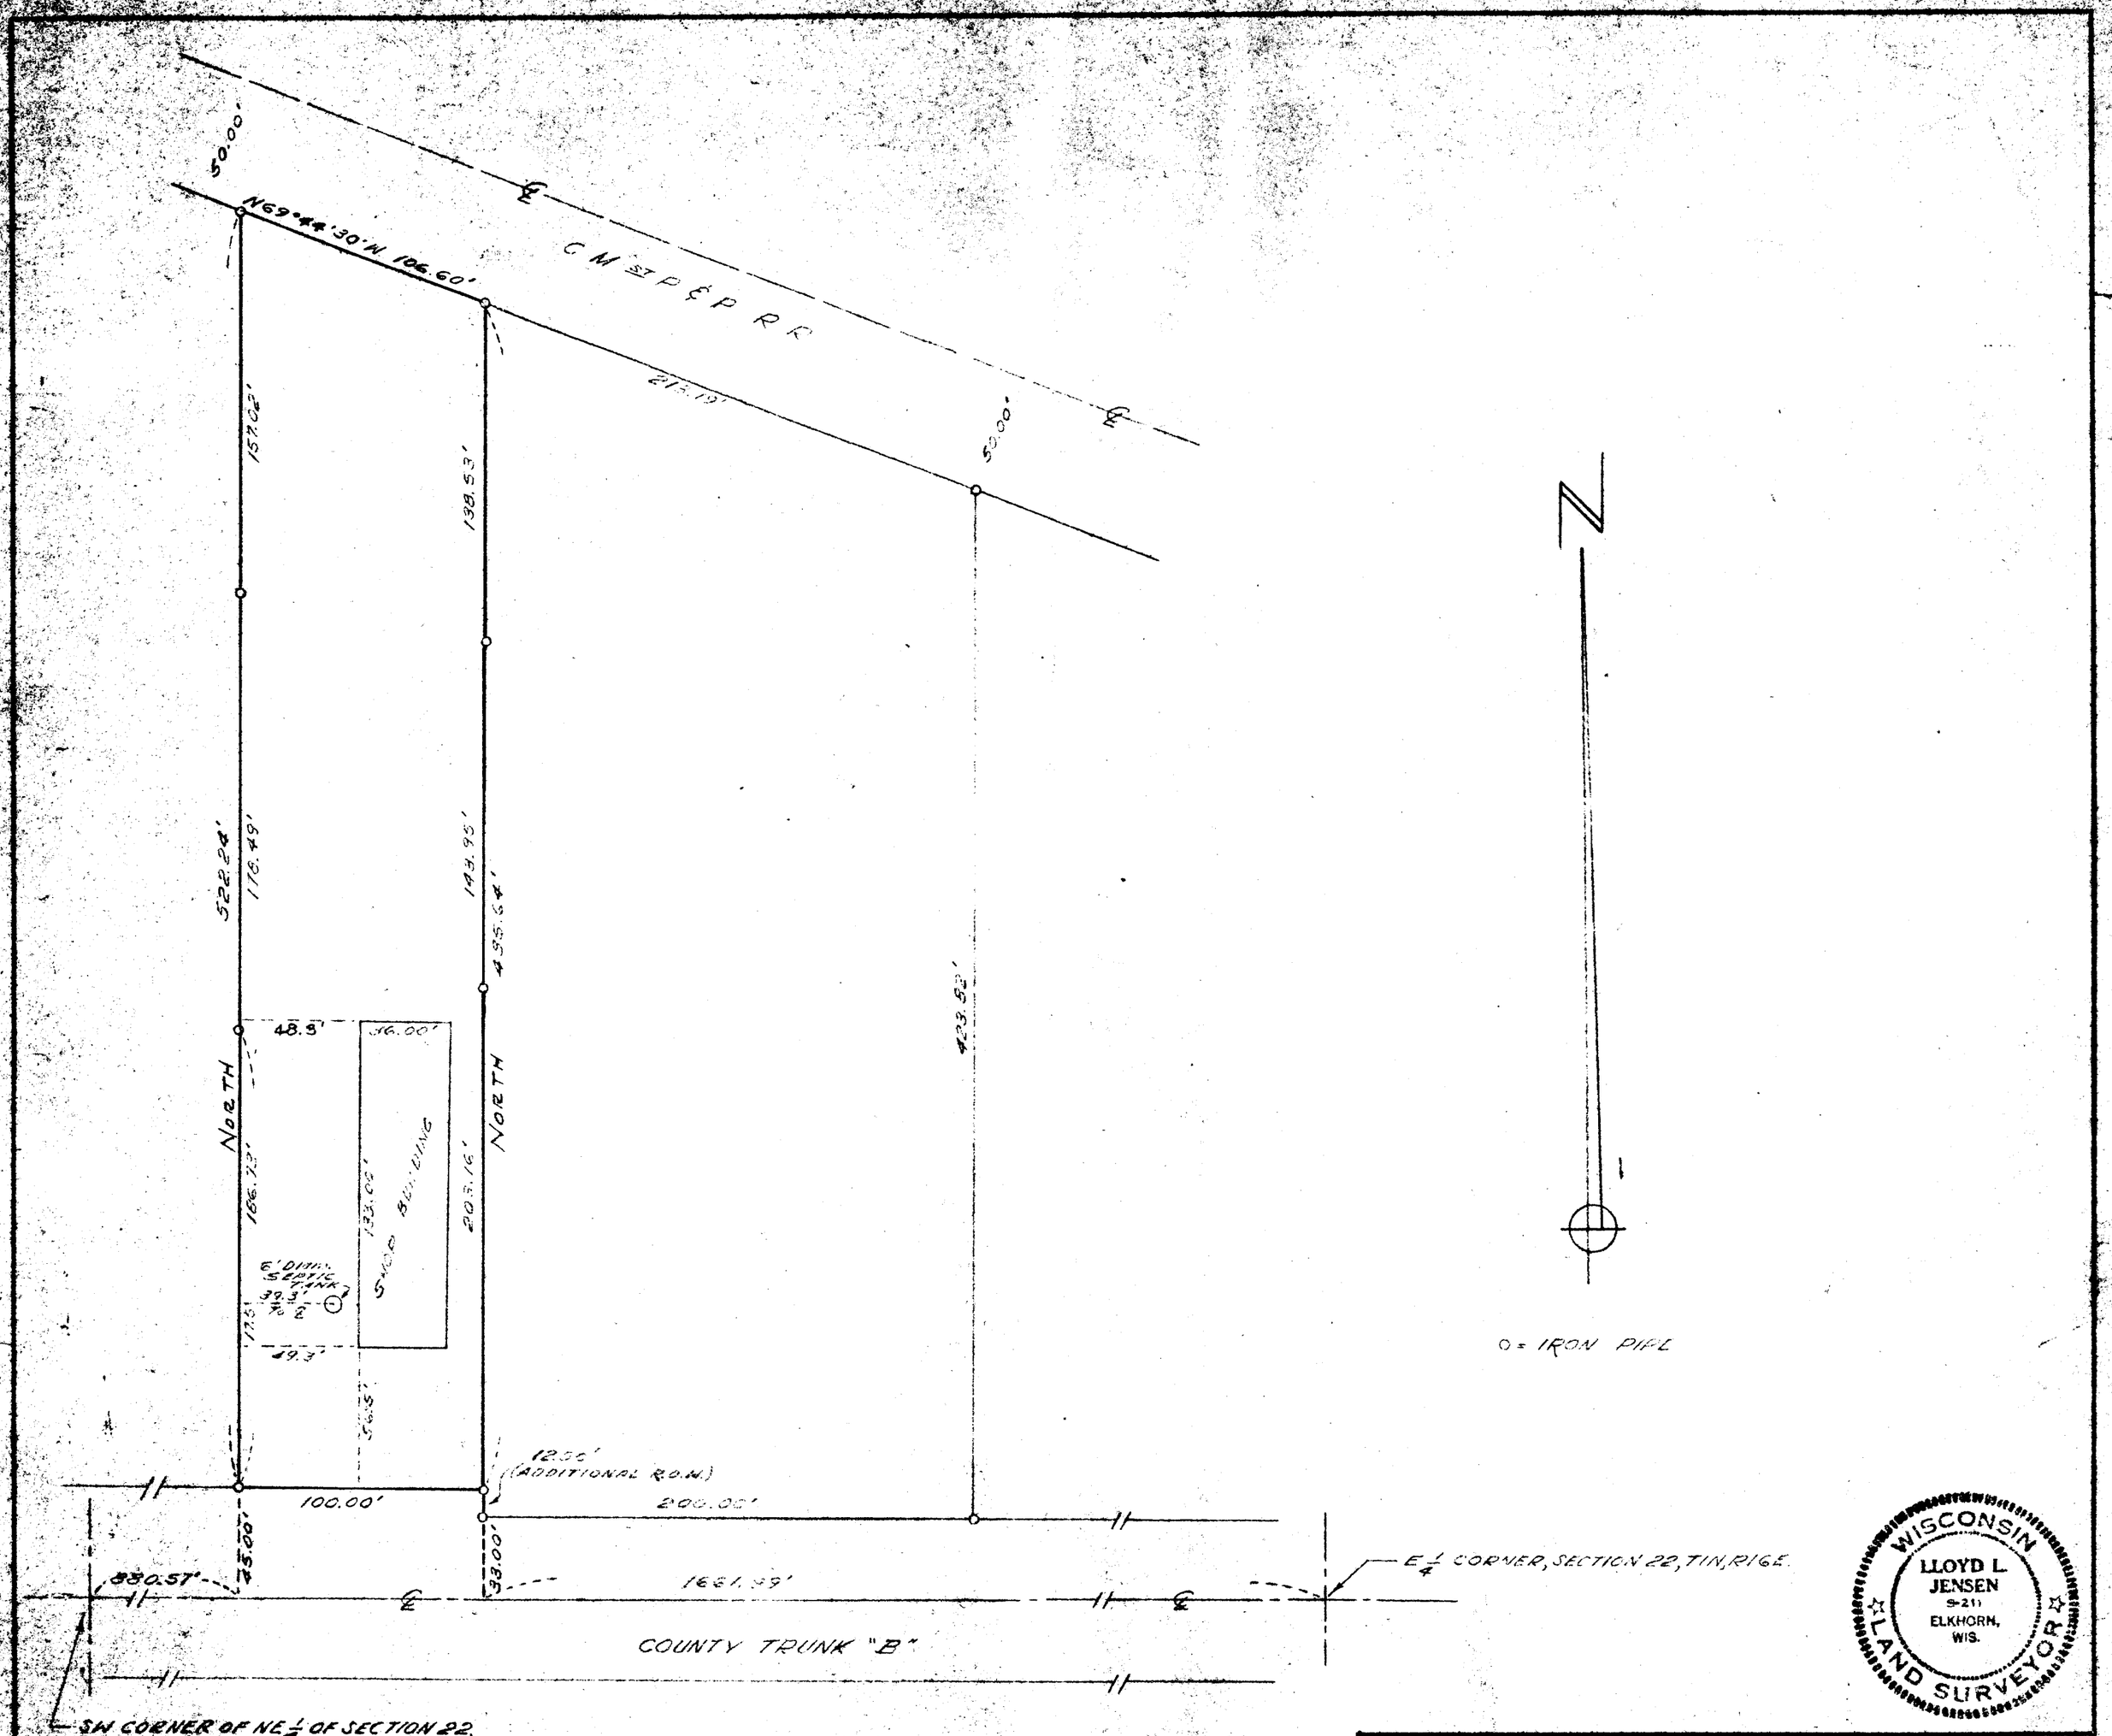

COUNTY OF WALWORTH
STATE OF WISCONSIN

I, Lloyd L. Jensen, hereby certify that I have surveyed the following described land:

A parcel of land located in the Northeast 1/4 of Section 22, T1N R16E, Walworth County, Wisconsin, described as follows, to-wit: Commencing at the Southwest corner of said Northeast 1/4; thence East along the 1/4 Section line 880.57 feet to a point; thence North 46.00 feet to the place of beginning, which point is located on the North line of the right of way of County Trunk B; thence continue North 522.24 feet to the right of way of the Chicago, Milwaukee, St. Paul and Pacific Railroad; thence S49°-44'-30"E along said Railroad right of way line 106.60 feet to a point located 100 feet East of the 1/4 Section line; thence South 485.64 feet to the North line of the right of way of County Trunk Highway B; thence West along the North line of said Highway 100.00 feet to the place of beginning, containing 1.16 acres of land;

That the plat shown hereon is a true and correct copy of said survey and that I have correctly shown all buildings and located on said parcel of land.

Dated 24, 1949

Lloyd L. Jensen
County Surveyor

VWUP-7

PLAT OF SURVEY
OF

A PARCEL OF LAND AND BUILDING THEREON, LOCATED IN THE NE¼ OF SECTION 22, T1N, R16E, WALWORTH COUNTY, WISCONSIN.

Lloyd L. Jensen
SURVEYOR

SCALE 1" = 50'

DATE August, 1949