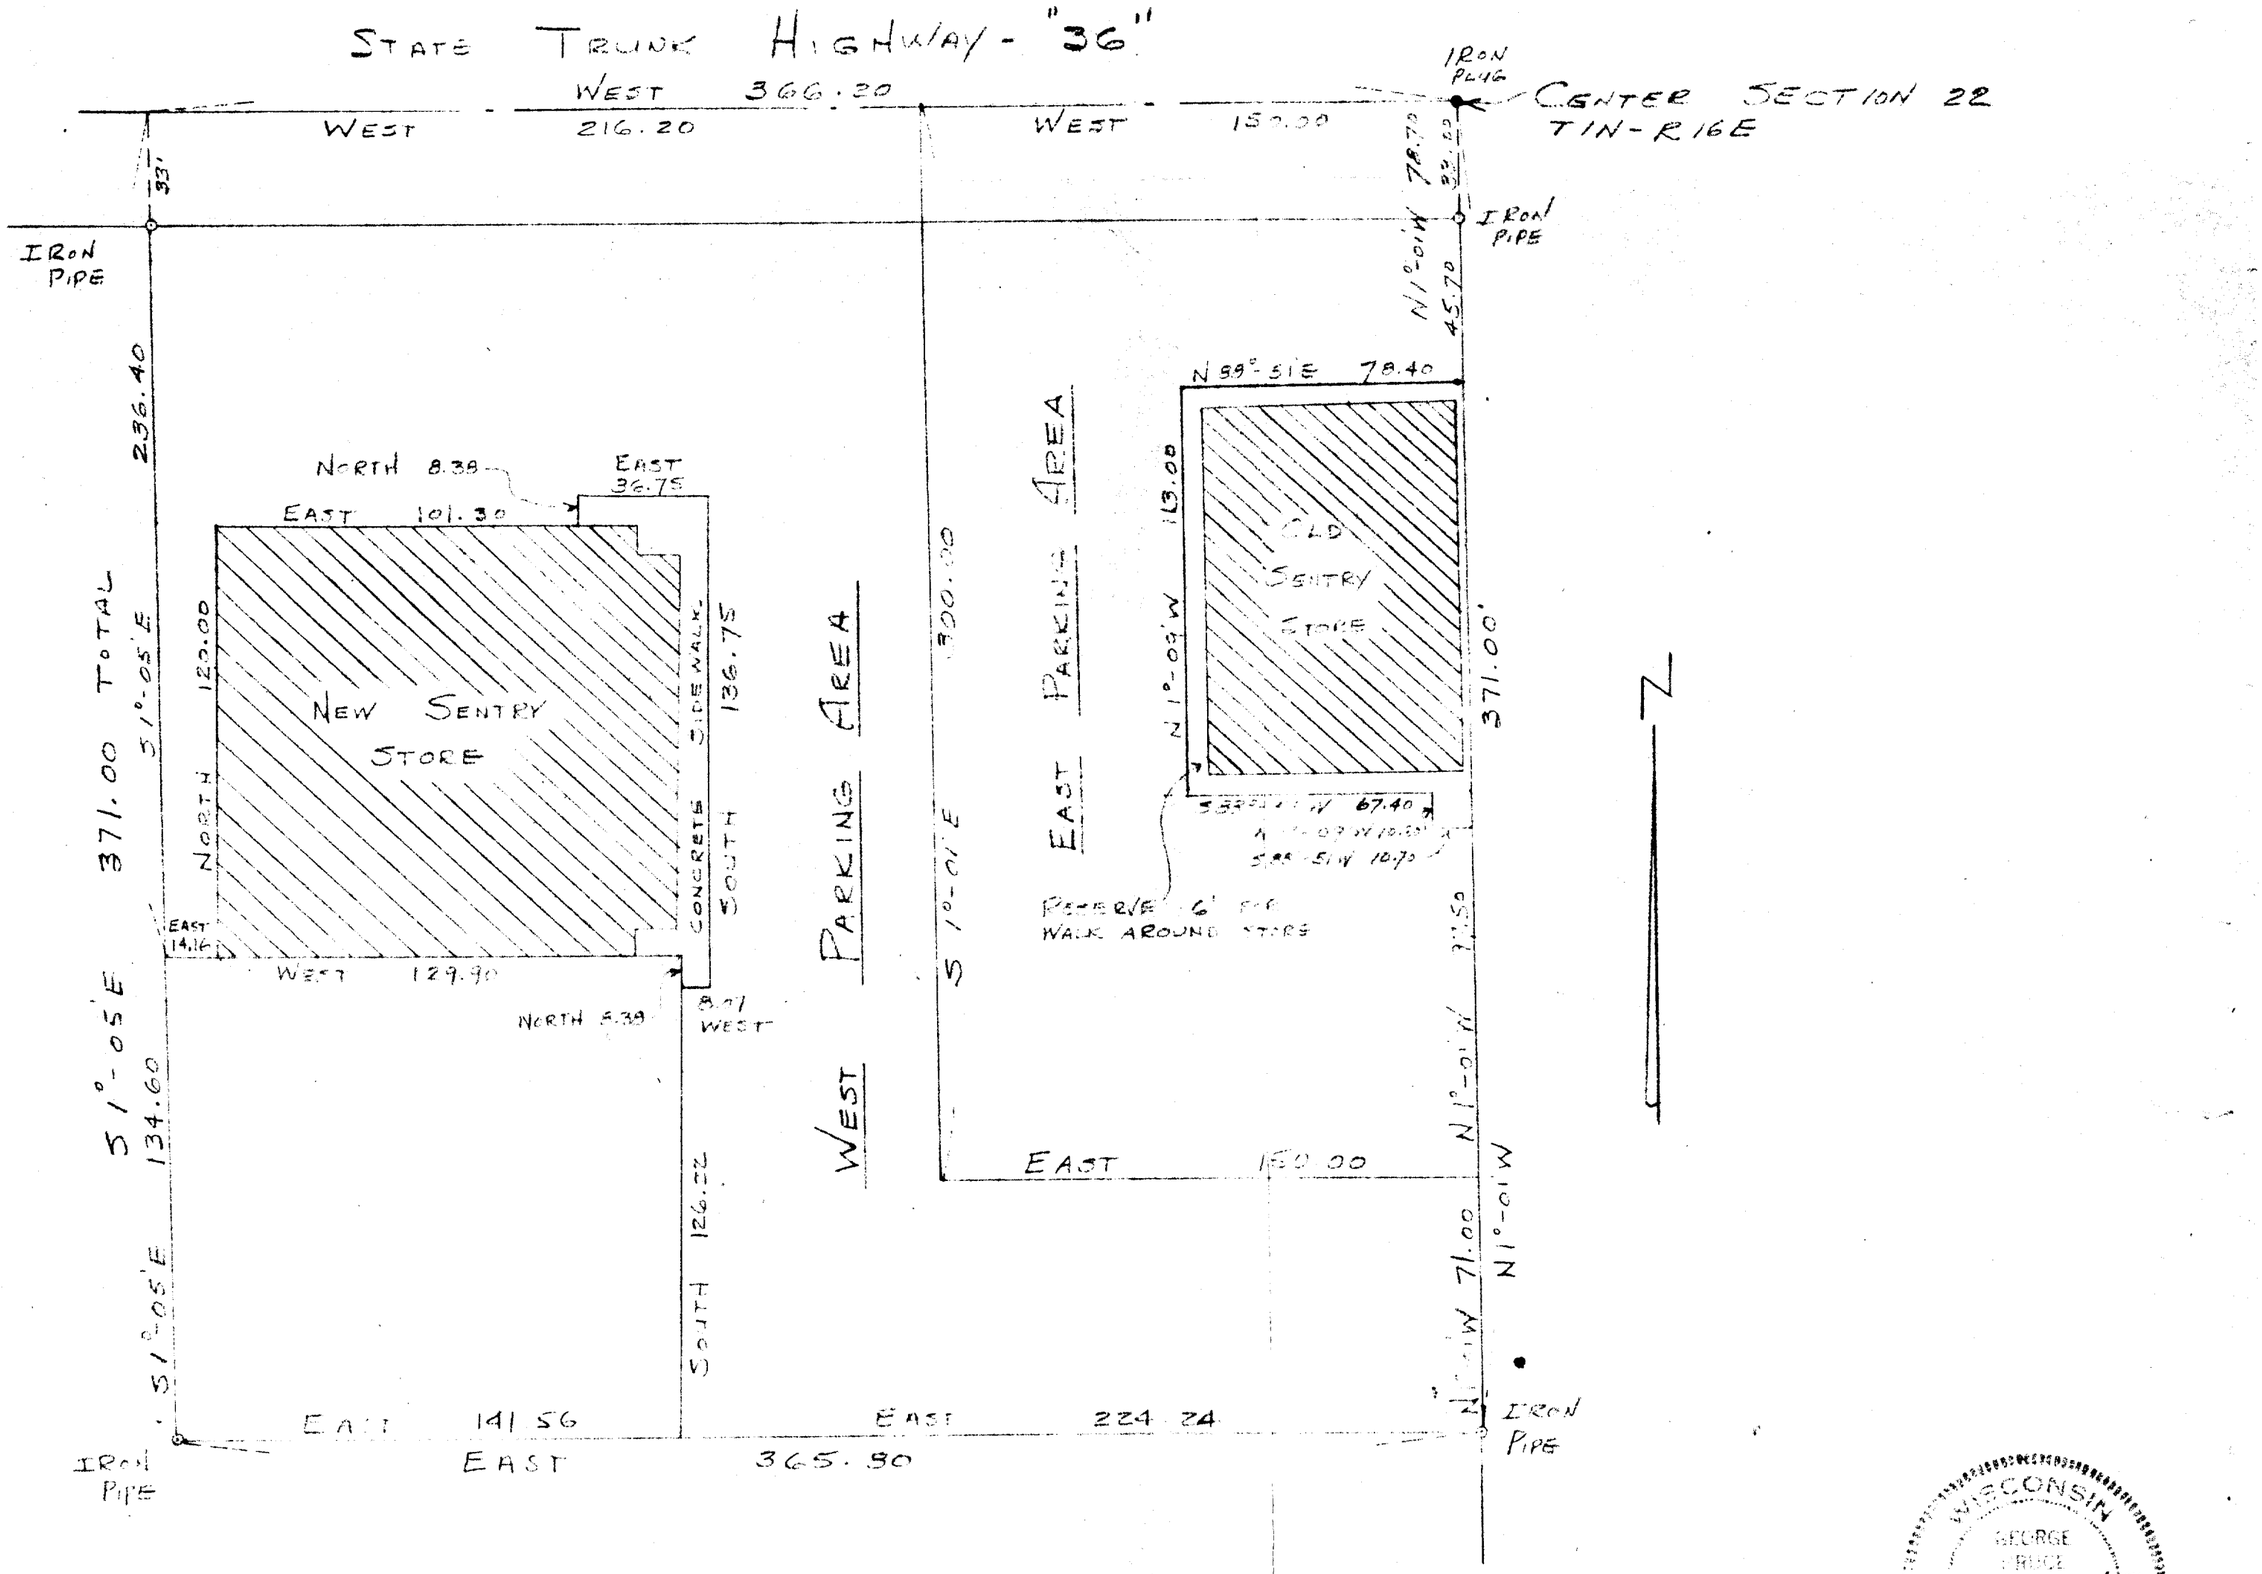

SURVEY CERTIFICATE

November 26, 1965

The undersigned hereby CERTIFIES to the EQUITABLE LIFE ASSURANCE SOCIETY OF THE UNITED STATES, as of the above date, that the attached print of survey correctly shows the location of all buildings, structures and other improvements situated on the above premises; and that, except as shown, there are no visible easements or rights of way across said premises or any other easements or rights of way of which the undersigned has been advised, no party walls, no encroachments on adjoining premises, streets or alleys by any of said buildings, structures or other improvements, and no encroachments on said premises by buildings, structures or other improvements situated on adjoining premises.

George B. Wilson

George B. Wilson, Surveyor S-751

WISCONSIN GEORGE BRUCE WILSON S-751 LAND SURVEYOR

PLAT OF SURVEY

OF

LANDS LOCATED IN OUTLOT 218, SW 1/4 SECTION 22, T1N-R16E, VILLAGE OF WALWORTH, WALWORTH COUNTY, WISCONSIN.

George B. Wilson
SURVEYOR

SCALE 1" = 40 DATE Nov. 26, 1965

WP-291 + WP-291A + 292

9-41