



DUNHAM SURVEYING, S.C.
SURVEYING & SUBDIVIDING
DELAVER, WISCONSIN 53115

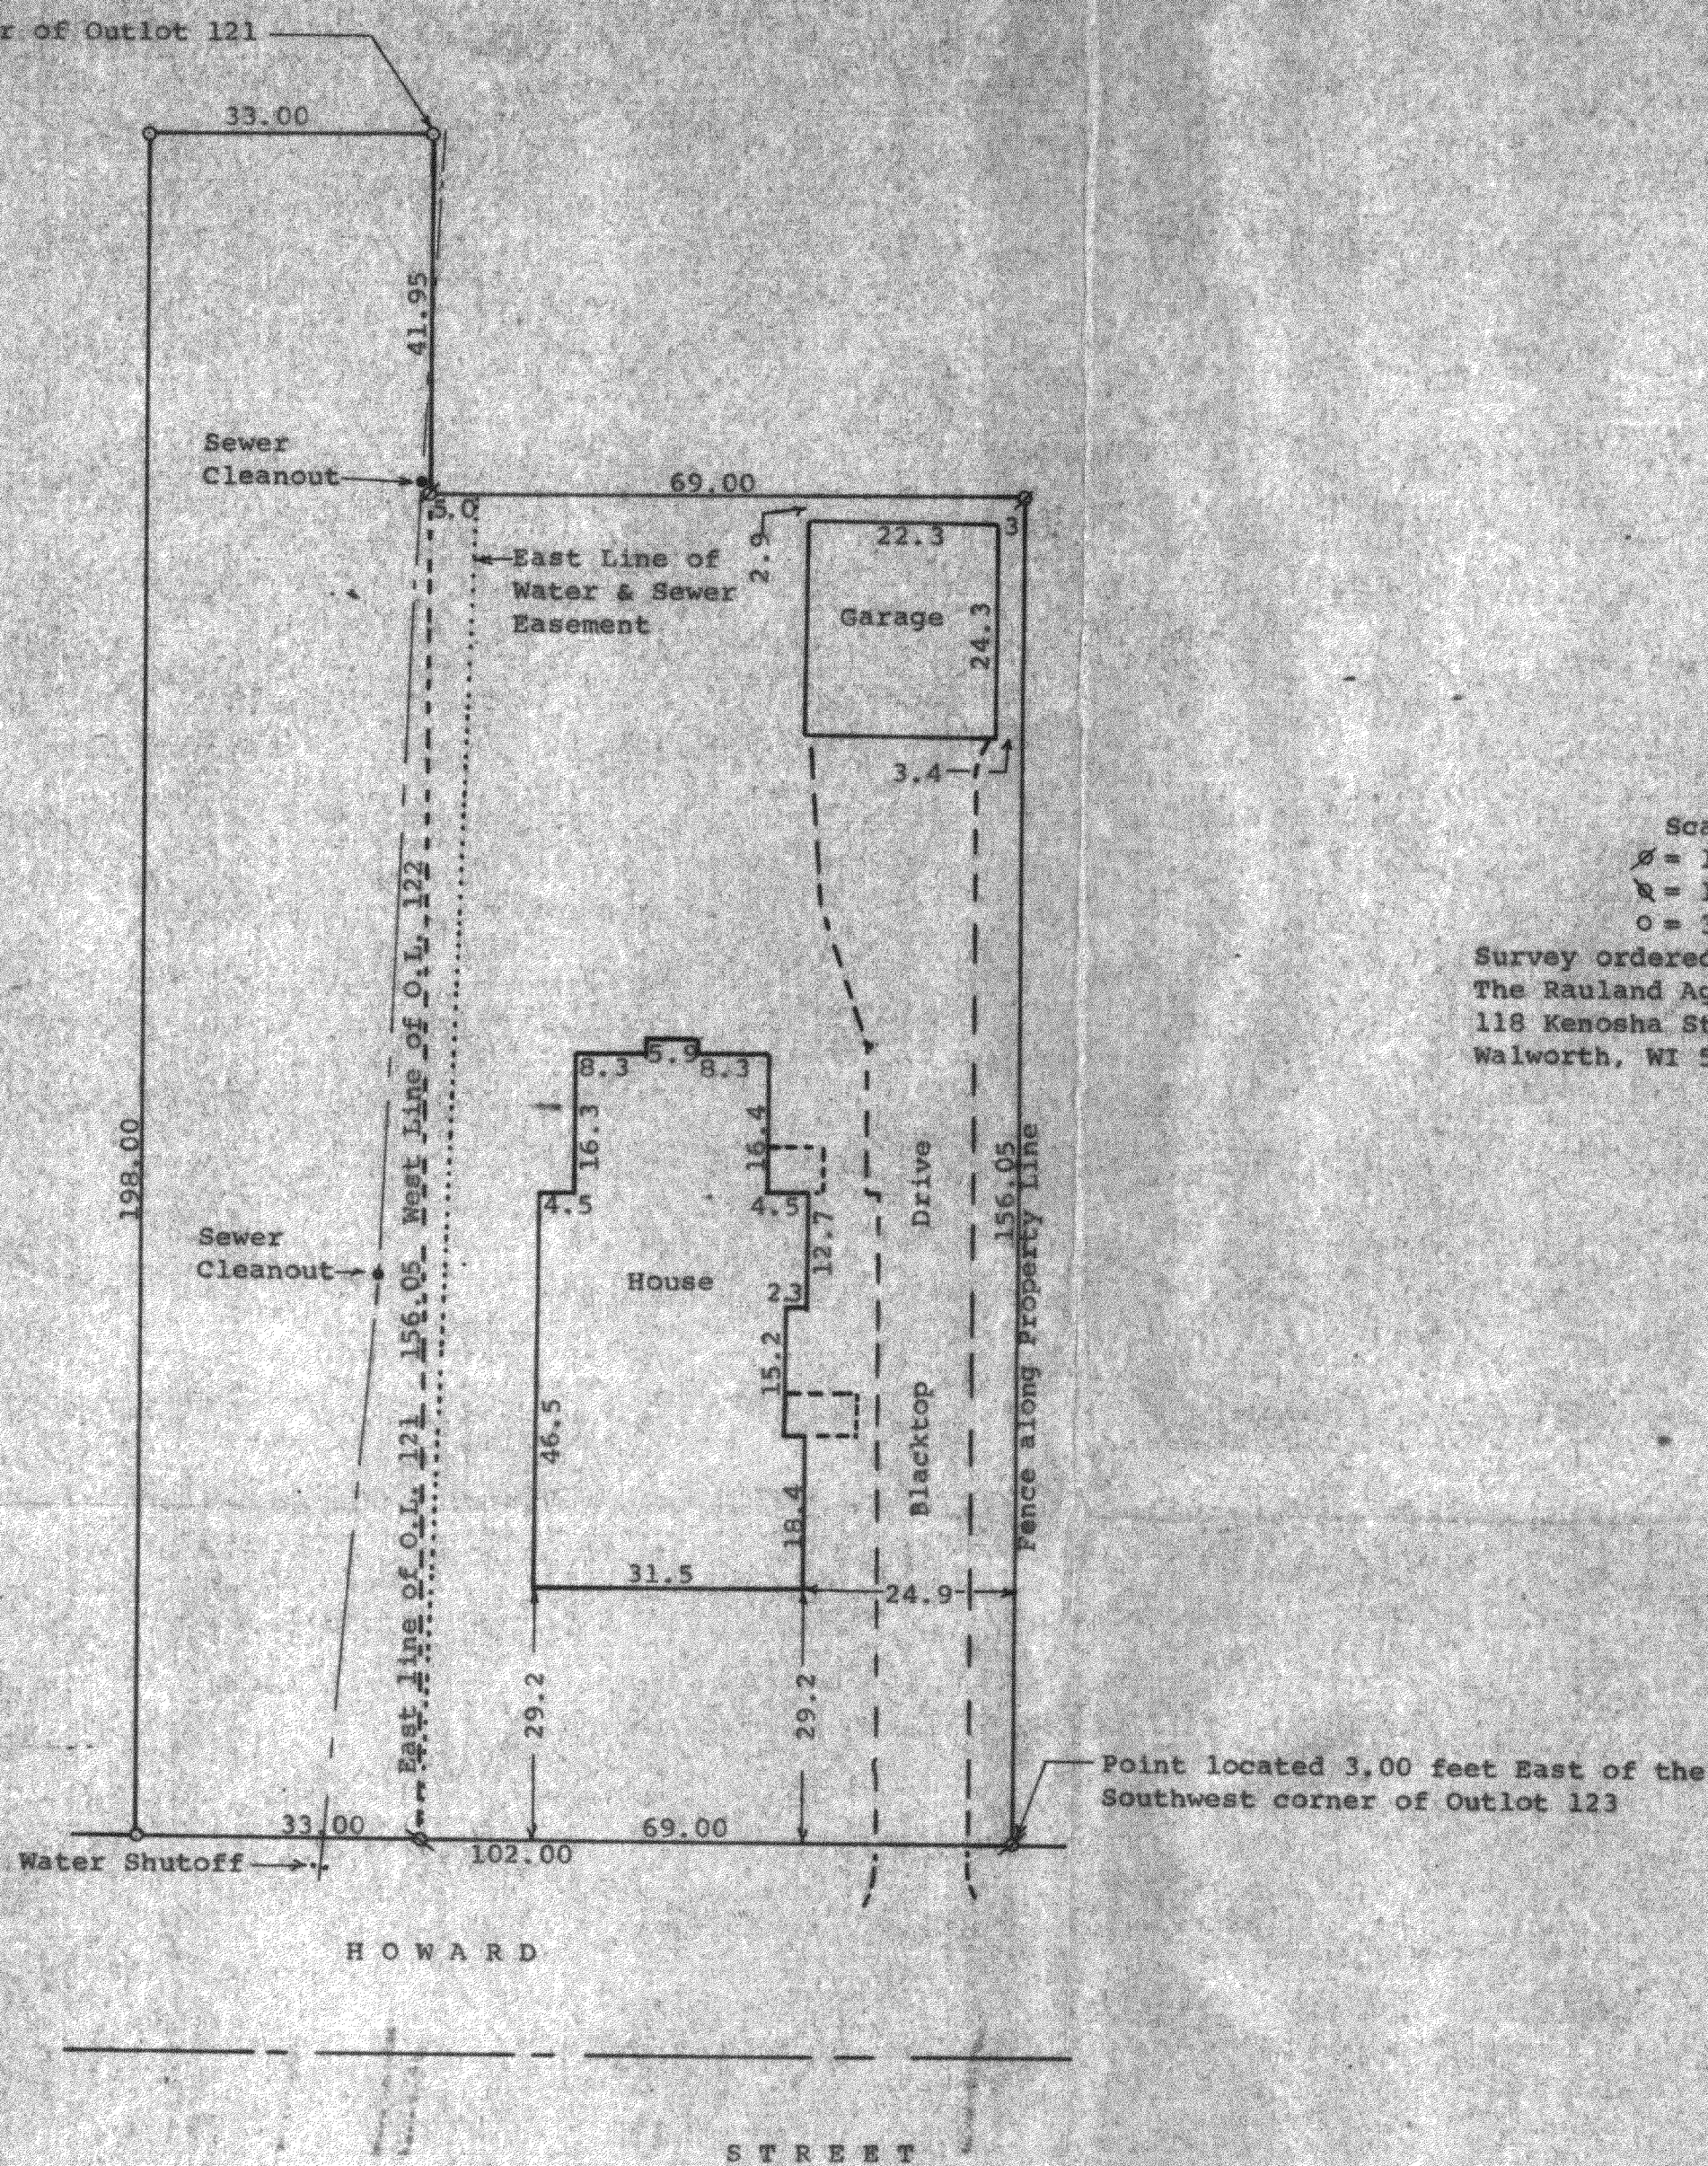

Scale = 1" = 20'
 Ø = 1" Iron Pipe Found
 Ø = 1 1/4" Iron Pipe Found
 Ø = 3/4" Iron Pipe Found
 Survey ordered by:
 The Rauland Agency
 118 Kenosha Street
 Walworth, WI 53184

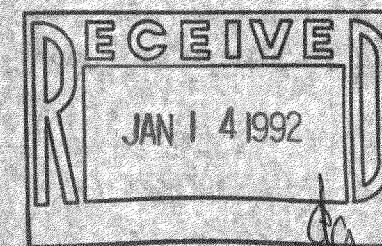

STATE OF WISCONSIN)
 COUNTY OF WALWORTH)

I, George T. Dunham, Certify that I have surveyed the property described as follows:

A parcel of land located in Outlots 122 and 123 of the Assessors Plat of the Village of Walworth, Walworth County, Wisconsin, described as follows: Beginning at the southwest corner of said Outlot 122; thence North along the west line of said Outlot 122, 156.05 feet; thence East parallel with the south line of said Outlot 122 and 123, 69.00 feet; thence South parallel with the west line of said Outlot 122, 156.05 feet; thence West along the south line of said Outlots 122 and 123, 69.00 feet to the place of beginning. ALSO the East 33.00 feet of Outlot 121 of the Assessors Plat of the Village of Walworth, Walworth County, Wisconsin. An easement is reserved for the maintenance and repair of the sewer and water lines located in Outlot 121 over that part of Outlots 121 and 122, described as follows: Beginning at the southwest corner of said Outlot 122; thence west along the south line of said Outlot 121, 33.00 feet; thence North parallel with the east line of said Outlot 121, 198.00 feet; thence East along the north line of said Outlot 121, 33.00 feet; thence South along the east line of said Outlot 121, 41.95 feet; thence East 5.00 feet; thence southerly to the southwest corner of Outlot 122 and the place of beginning.

and that the plat shown hereon is a correct representation thereof and shows the size and location of the property, its exterior boundaries, the location of all visible structures and dimensions of all principal buildings thereon, boundary fences, apparent easements, roadways and visible encroachments, if any, and that I have surveyed the property hereon described, according to the official records, to the best of my knowledge and belief, February 21, 1991

George T. Dunham, Surveyor

