


DUNHAM SURVEYING, S.C.  
SURVEYING & SUBDIVIDING  
DELAVER, WISCONSIN 53115

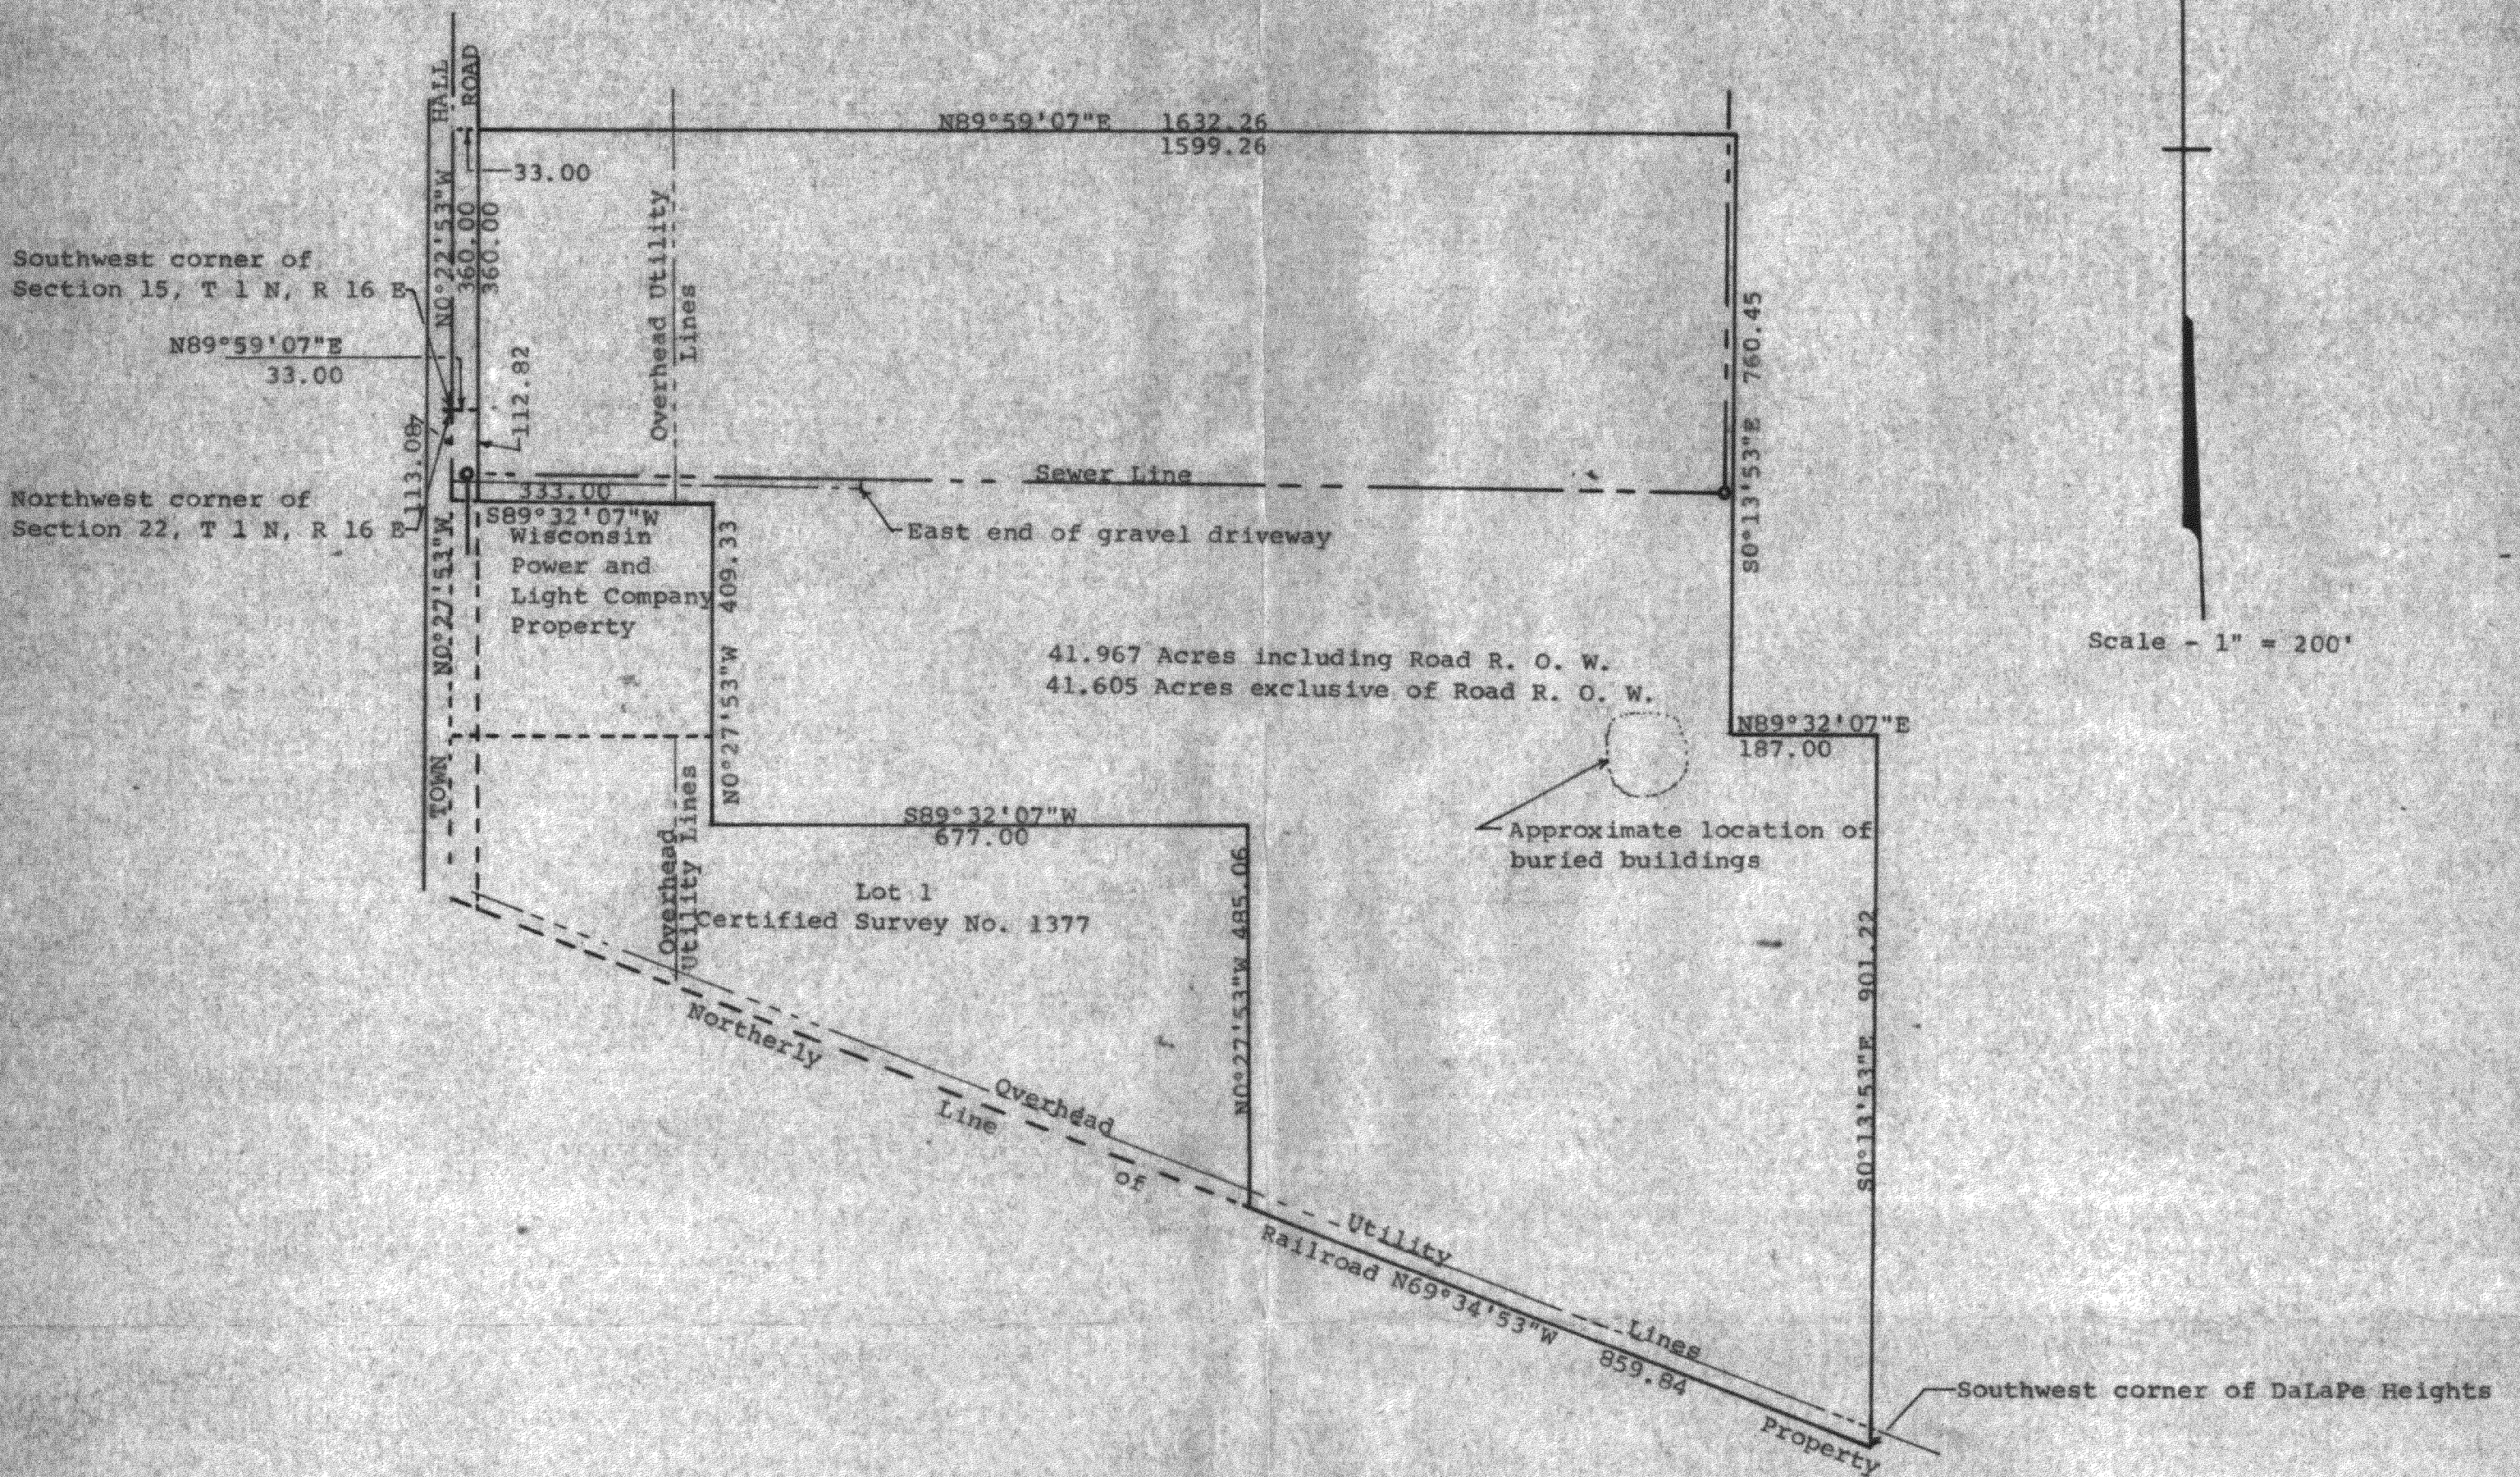

Plat of survey of:

A parcel of land located in the Southeast  $\frac{1}{4}$  of the Southwest  $\frac{1}{4}$  and in the Southwest  $\frac{1}{4}$  of the Southwest  $\frac{1}{4}$  of Section 15, T 1 N, R 16 E, and in the Northwest  $\frac{1}{4}$  of the Northwest  $\frac{1}{4}$  and in the Northeast  $\frac{1}{4}$  of the Northwest  $\frac{1}{4}$  of Section 22, T 1 N, R 16 E, being a part of Outlots 85 and 183 of the Assessor's Plat of the Village of Walworth, Walworth County, Wisconsin, described as follows: Commencing at the southeast corner of said Section 15; thence N89°59'07"E 33.00 feet to the east right of way line of Town Hall Road and the place of beginning; thence N0°22'53"W along said east line 360.00 feet; thence N89°59'07"E 1599.26 feet; thence S0°13'53"E 760.45 feet; thence N89°32'07"E 187.00 feet; thence S0°13'53"E 901.22 feet to the southwest corner of Dalape Heights and the northerly line of the railroad property; thence N69°34'53"W along said northerly line, 859.84 feet to the southeast corner of Certified Survey No. 1377; thence N0°27'53"W along the easterly line of said certified survey 485.06 feet to the northeast corner of said Certified Survey No. 1377; thence S89°32'07"W along the northerly line of said Certified Survey No. 1377, 677.00 feet; thence N0°27'53"W 409.33 feet to the northeast corner of property owned by the Wisconsin Power & Light Company; thence S89°32'07"W along the northerly line of said property owned by the Wisconsin Power & Light Company, 300.00 feet to the east line of Town Hall Road; thence N0°27'53"W parallel to the west line of said section 22, 112.82 feet to the place of beginning, containing 41.605 acres of land, subject to easements of record.

Information for the above plat of survey, is from the plat of survey by James M. Dunham, Dated May 4, 1983, from plat of Certified Survey No. 1377 by George T. Dunham, recorded September 11, 1984 and by field measurements made this date of February 20 and February 26, 1991

*George T. Dunham*  
George T. Dunham, Surveyor

