


GEORGE T. DUNHAM
SURVEYING & SUBDIVIDING
DELAVER, WISCONSIN

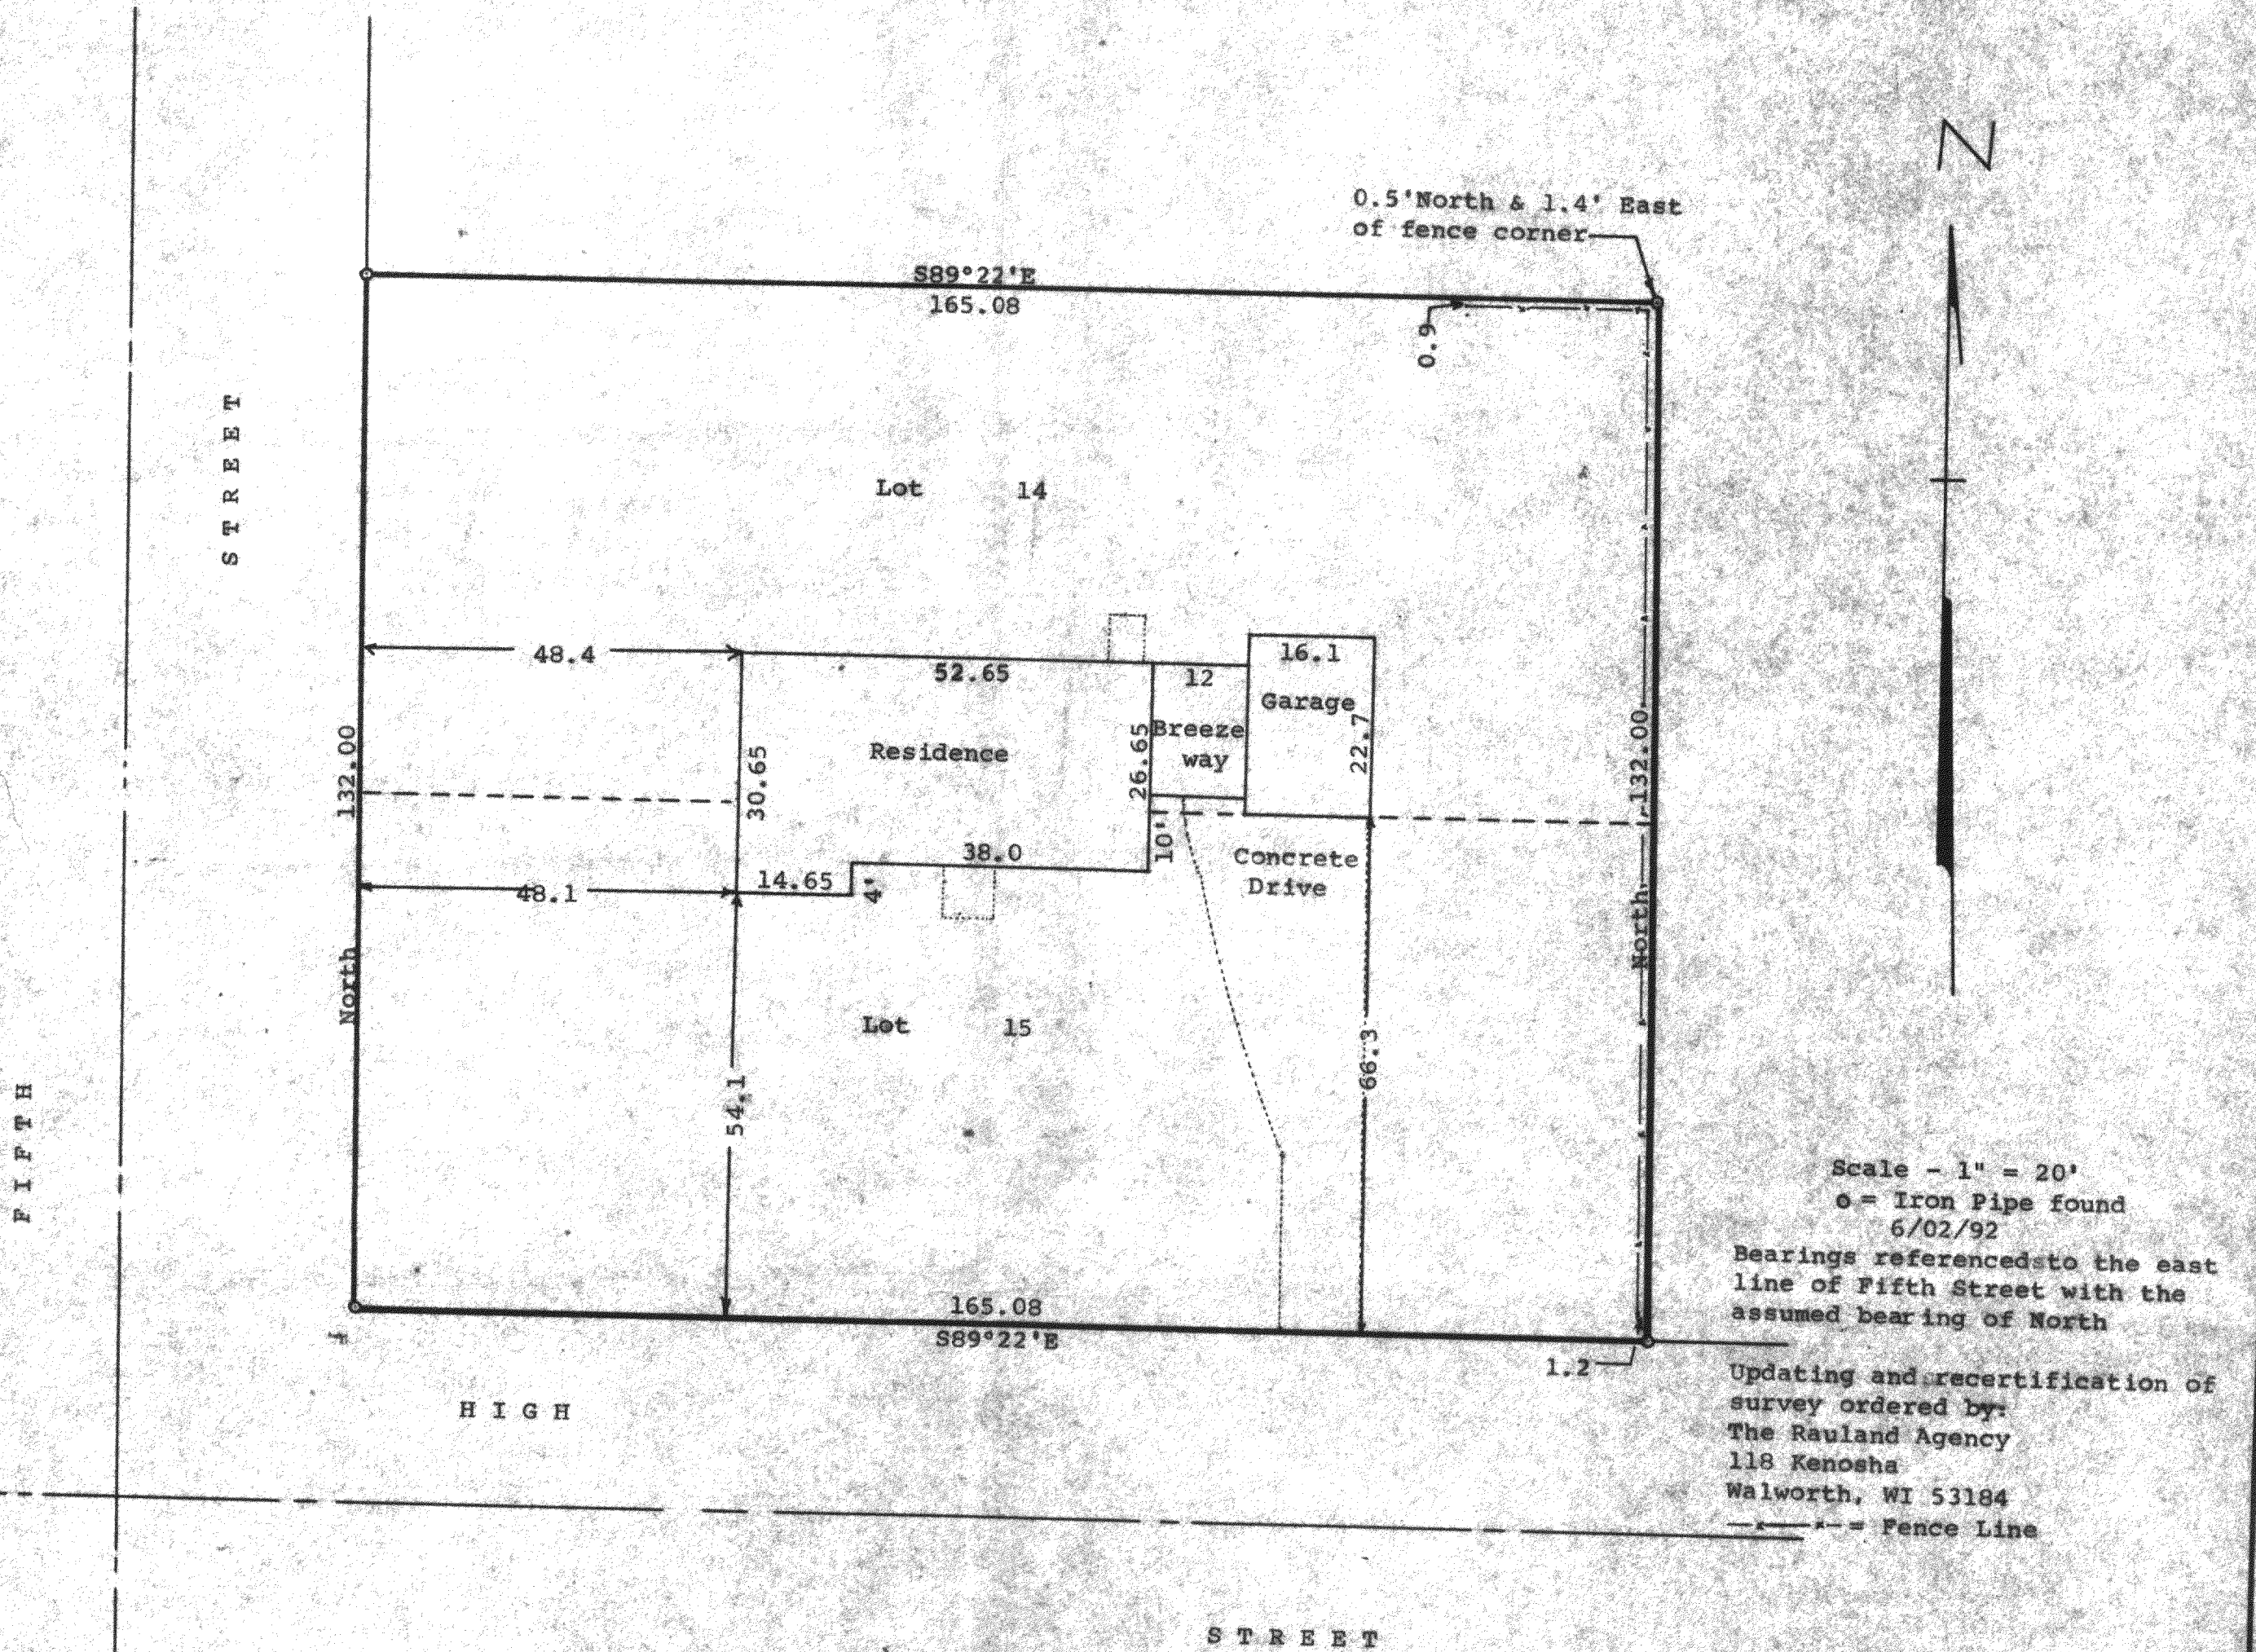

STATE OF WISCONSIN)
WALWORTH COUNTY) SS

I, George T. Dunham, Surveyor, certify that I have surveyed the property described as follows,
Lots 14 & 15, Block 1 of E. W. Crumbs Addition located in the Village of Walworth, Walworth County, Wisconsin, and that the above plat is an accurate survey and a true representation thereof and correctly shows the exterior boundary lines and location of the buildings on said property and the correct measurements thereof.

November 30, 1966

Updated and recertified to
this 2nd day of June 1992

George T. Dunham
George T. Dunham, Surveyor

