
PLAT OF SURVEY

OF

PART OF OUTLOT 198 AND A 12 FOOT WIDE ALLEY LOCATED IN THE SW¼ OF SECTION 22, TIN 4E, VILLAGE OF WALWORTH, WALWORTH COUNTY, WISCONSIN.

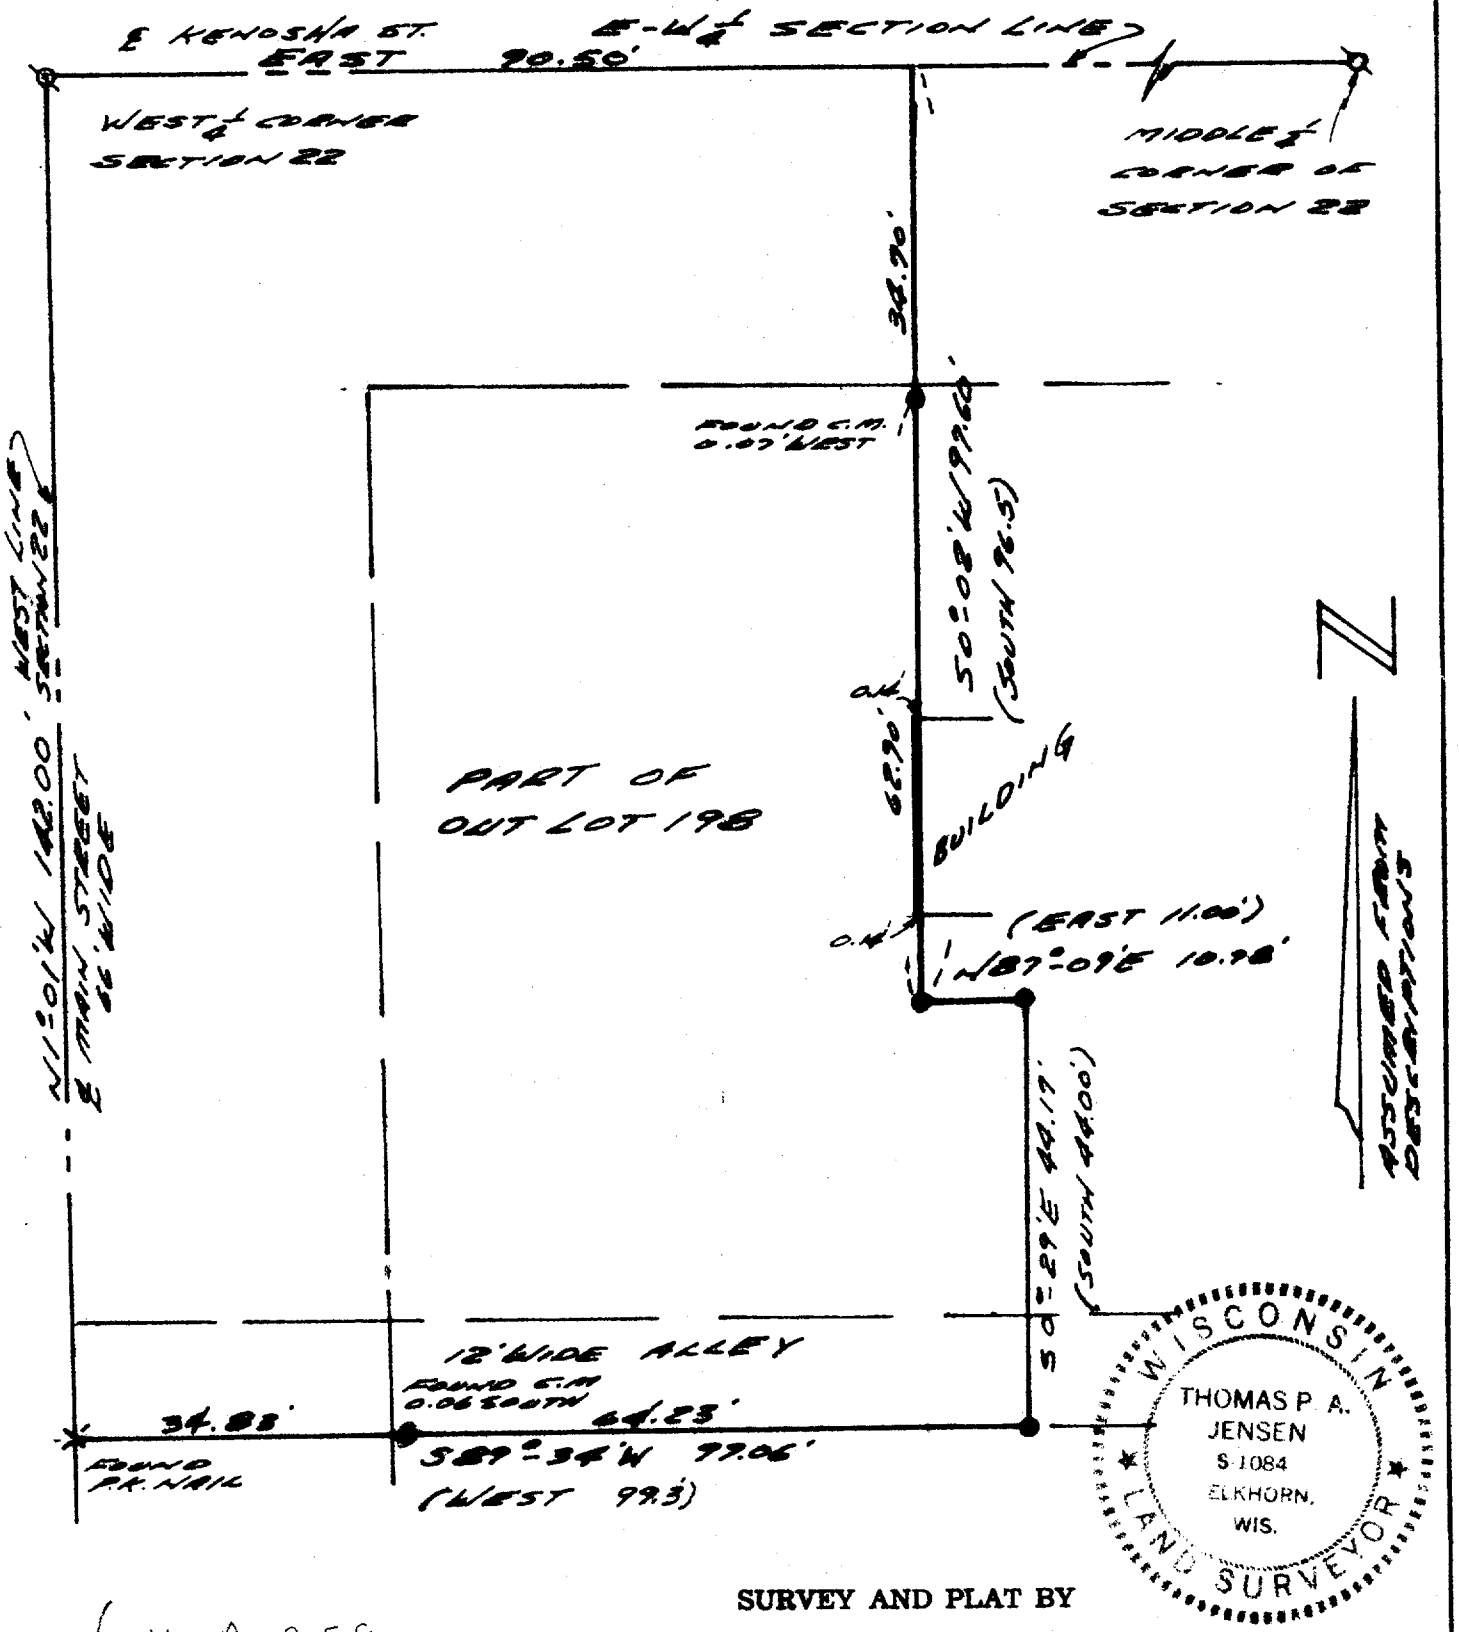

Parcel VWP-258

LEGEND

○ — Iron Pipe

● — Concrete Monument FOUND

Scale 1" = 20'

⌀ — IRON PLUG FOUND

SURVEY AND PLAT BY

JENSEN & JOHNSON, INC.

CIVIL ENGINEERS AND SURVEYORS

Elkhorn, Wisconsin

WE CERTIFY: That we have surveyed the above described property and that the plat shown hereon is an accurate survey and a true representation thereof and correctly shows the exterior boundary lines and all divisions of said property.

Date JAN. 4, 1973

Thomas P.A. Jensen
THOMAS P.A. JENSEN

Wisconsin Registered Land Surveyor, No. S-1084

9-47