PARTIAL SURVEY

COMMENCING AT THE EAST 1/4 CORNER OF SECTION 22, TOWN 1 NORTH, RANGE 16 EAST, THENCE WEST ALONG THE 1/4 SECTION LINE, 221.99 FEET TO THE PLACE OF BEGINNING; THENCE CONTINUE WEST ALONG THE 1/4 SECTION LINE 1120.00 FEET; THENCE NORTH AT RIGHT ANGLES TO THE 1/4 SECTION LINE 412.23 FEET TO THE SOUTHERLY LINE OF THE RIGHT-OF-WAY OF THE CHICAGO, MILWAUKEE, ST. PAUL AND PACIFIC RAILWAY; THENCE SOUTHERLY ALONG SAID RIGHT-OF-WAY 1193.80 FEET TO THE PLACE OF BEGINNING.

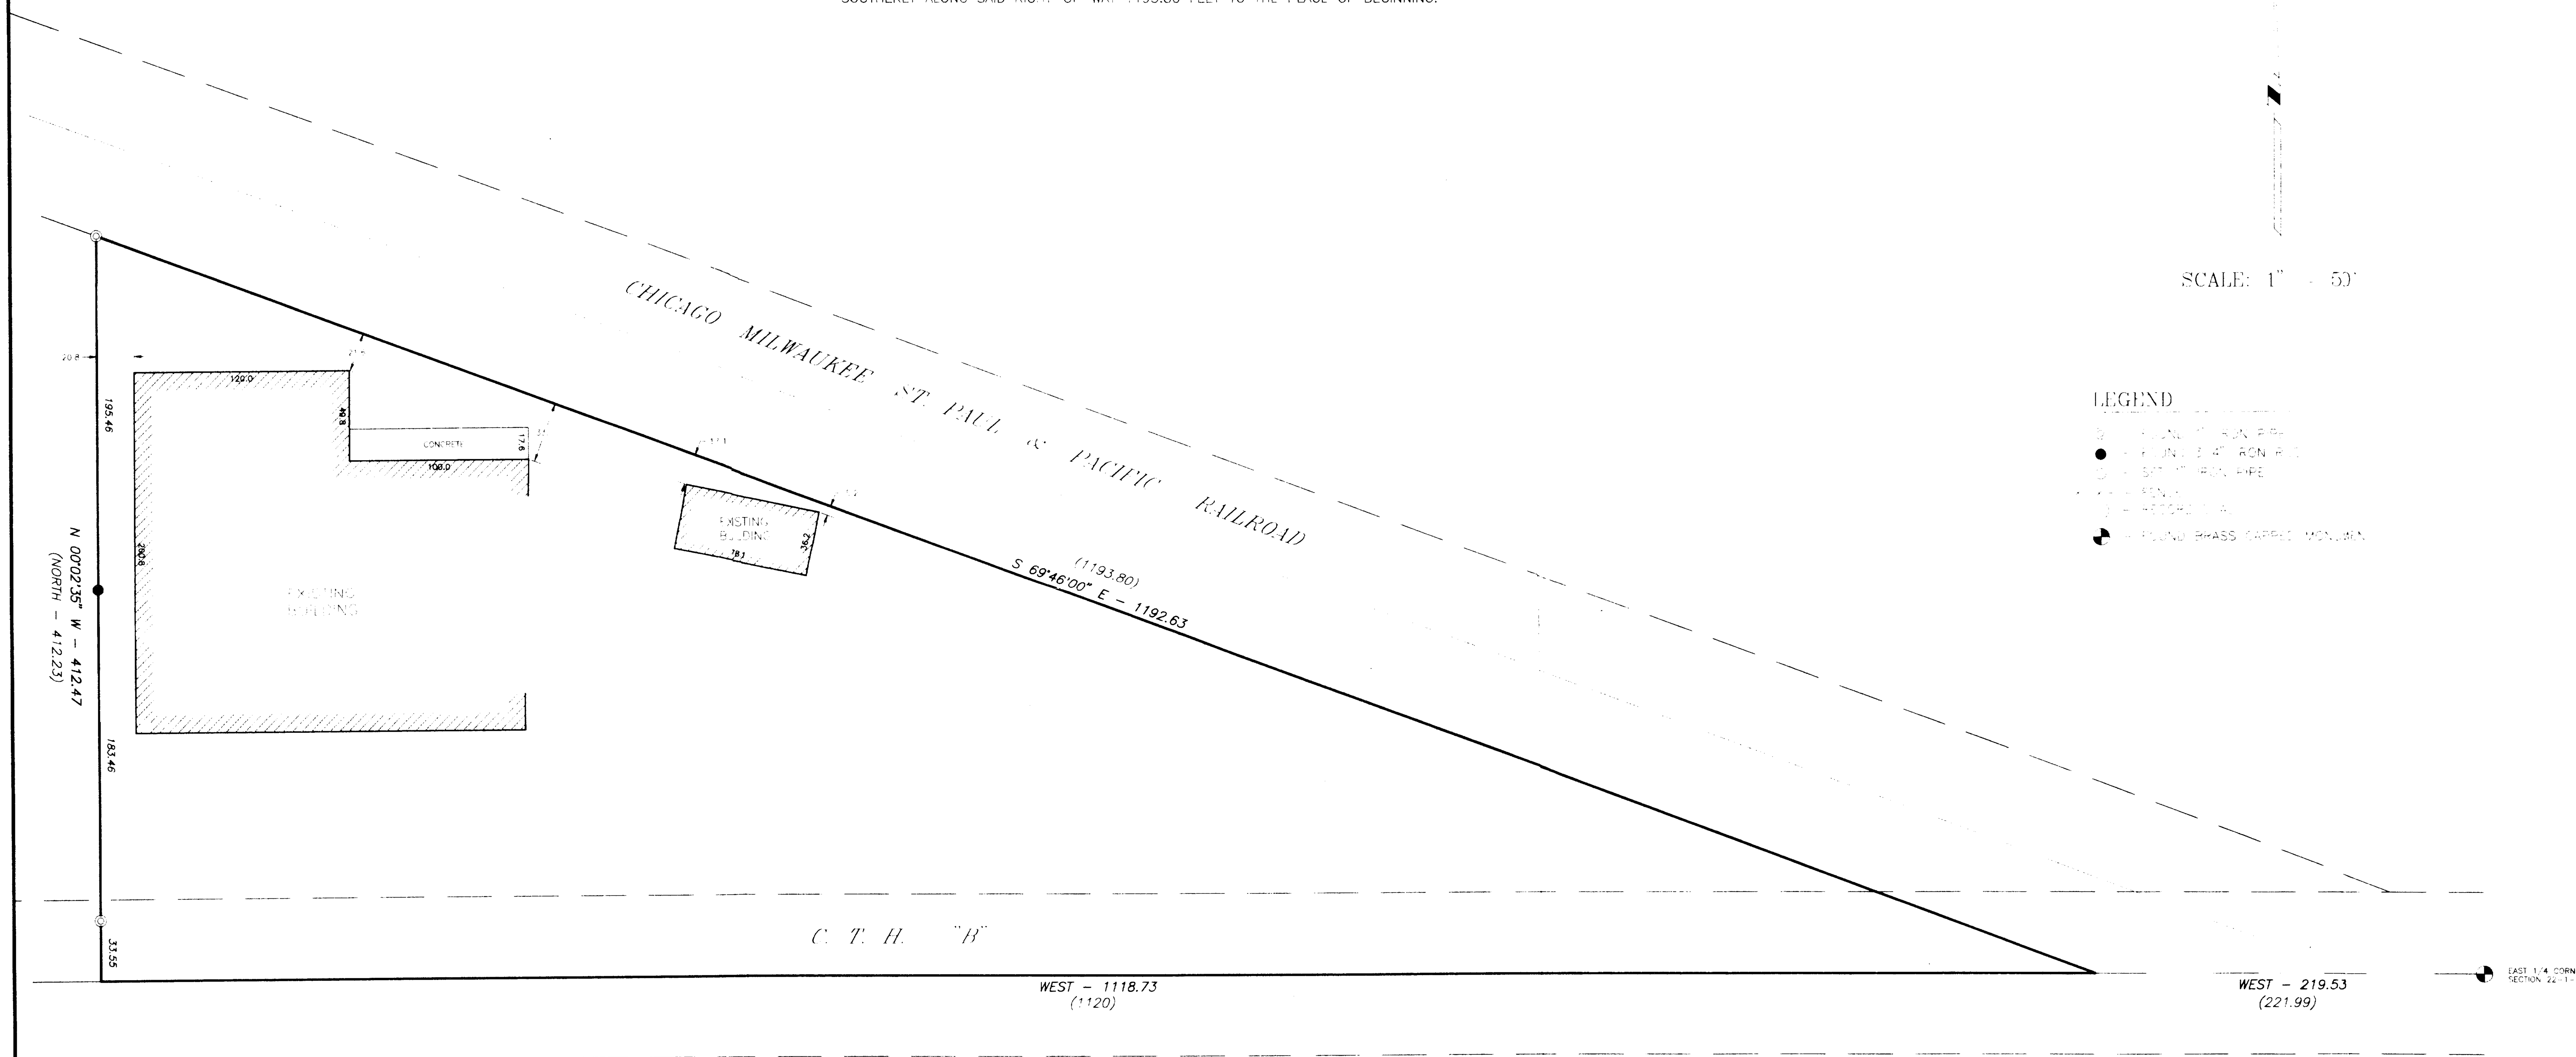

PROJECT

PARTIAL SURVEY
POLYFLEX

PROJECT NO.

982219

DATE

JUNE 3, 1998

REVISIONS

ENGINEER / SURVEYOR

GARY B. FOAT
DEGEN, FOAT SURVEYING ASSOCIATES

PREPARED FOR

BOB HARLOW

DRAWN BY

GBF

CHECKED BY

SCALE

1" =

SHEET TITLE

SHEET NO.

1 OF 1

DEGEN, FOAT SURVEYING ASSOCIATES
100 SOUTH SECOND STREET
WATERFORD, WISCONSIN
(414)534-5404 (FAX)534-2022

RECEIVED
MAR 30 1999

I HEREBY CERTIFY THAT I HAVE SURVEYED THE ABOVE DESCRIBED PROPERTY AND THE ABOVE MAP IS A TRUE REPRESENTATION THEREOF AND SHOWS THE SIZE AND LOCATION OF THE PROPERTY, THE LOCATION OF ALL VISIBLE STRUCTURES AND DIMENSIONS OF ALL PRINCIPAL BUILDINGS THEREON, BOUNDARY FENCES, APPARENT EASEMENTS, ROADWAY AND VISIBLE ENCROACHMENTS, IF ANY.

THIS SURVEY IS MADE FOR THE PRESENT OWNERS OF THE PROPERTY, AND ALSO THOSE WHO PURCHASE, OR GUARANTEE THE TITLE THERETO WITHIN 1 YEAR FROM THE DATE HEREOF.

DATED AT WATERFORD THIS 3RD DAY OF JUNE 19 98

RECERTIFIED________ *Gary B. Foat*

VWUP-13D

009-708

PARTIAL SURVEY

COMMENCING AT THE EAST 1/4 CORNER OF SECTION 22, TOWN 1 NORTH, RANGE 16 EAST, THENCE WEST ALONG THE 1/4 SECTION LINE, 221.99 FEET TO THE PLACE OF BEGINNING; THENCE CONTINUE WEST ALONG THE 1/4 SECTION LINE 1120.00 FEET; THENCE NORTH AT RIGHT ANGLES TO THE 1/4 SECTION LINE 412.23 FEET TO THE SOUTHERLY LINE OF THE RIGHT-OF-WAY OF THE CHICAGO, MILWAUKEE, ST. PAUL AND PACIFIC RAILWAY; THENCE SOUTHERLY ALONG SAID RIGHT-OF-WAT 1193.80 FEET TO THE PLACE OF BEGINNING.

NOTE: THE PURPOSE OF THIS SURVEY IS TO SHOW THE RELATIONSHIP OF THE BUILDING ADDITION UNDER CONSTRUCTION TO THE PROPERTY LINES "ONLY".

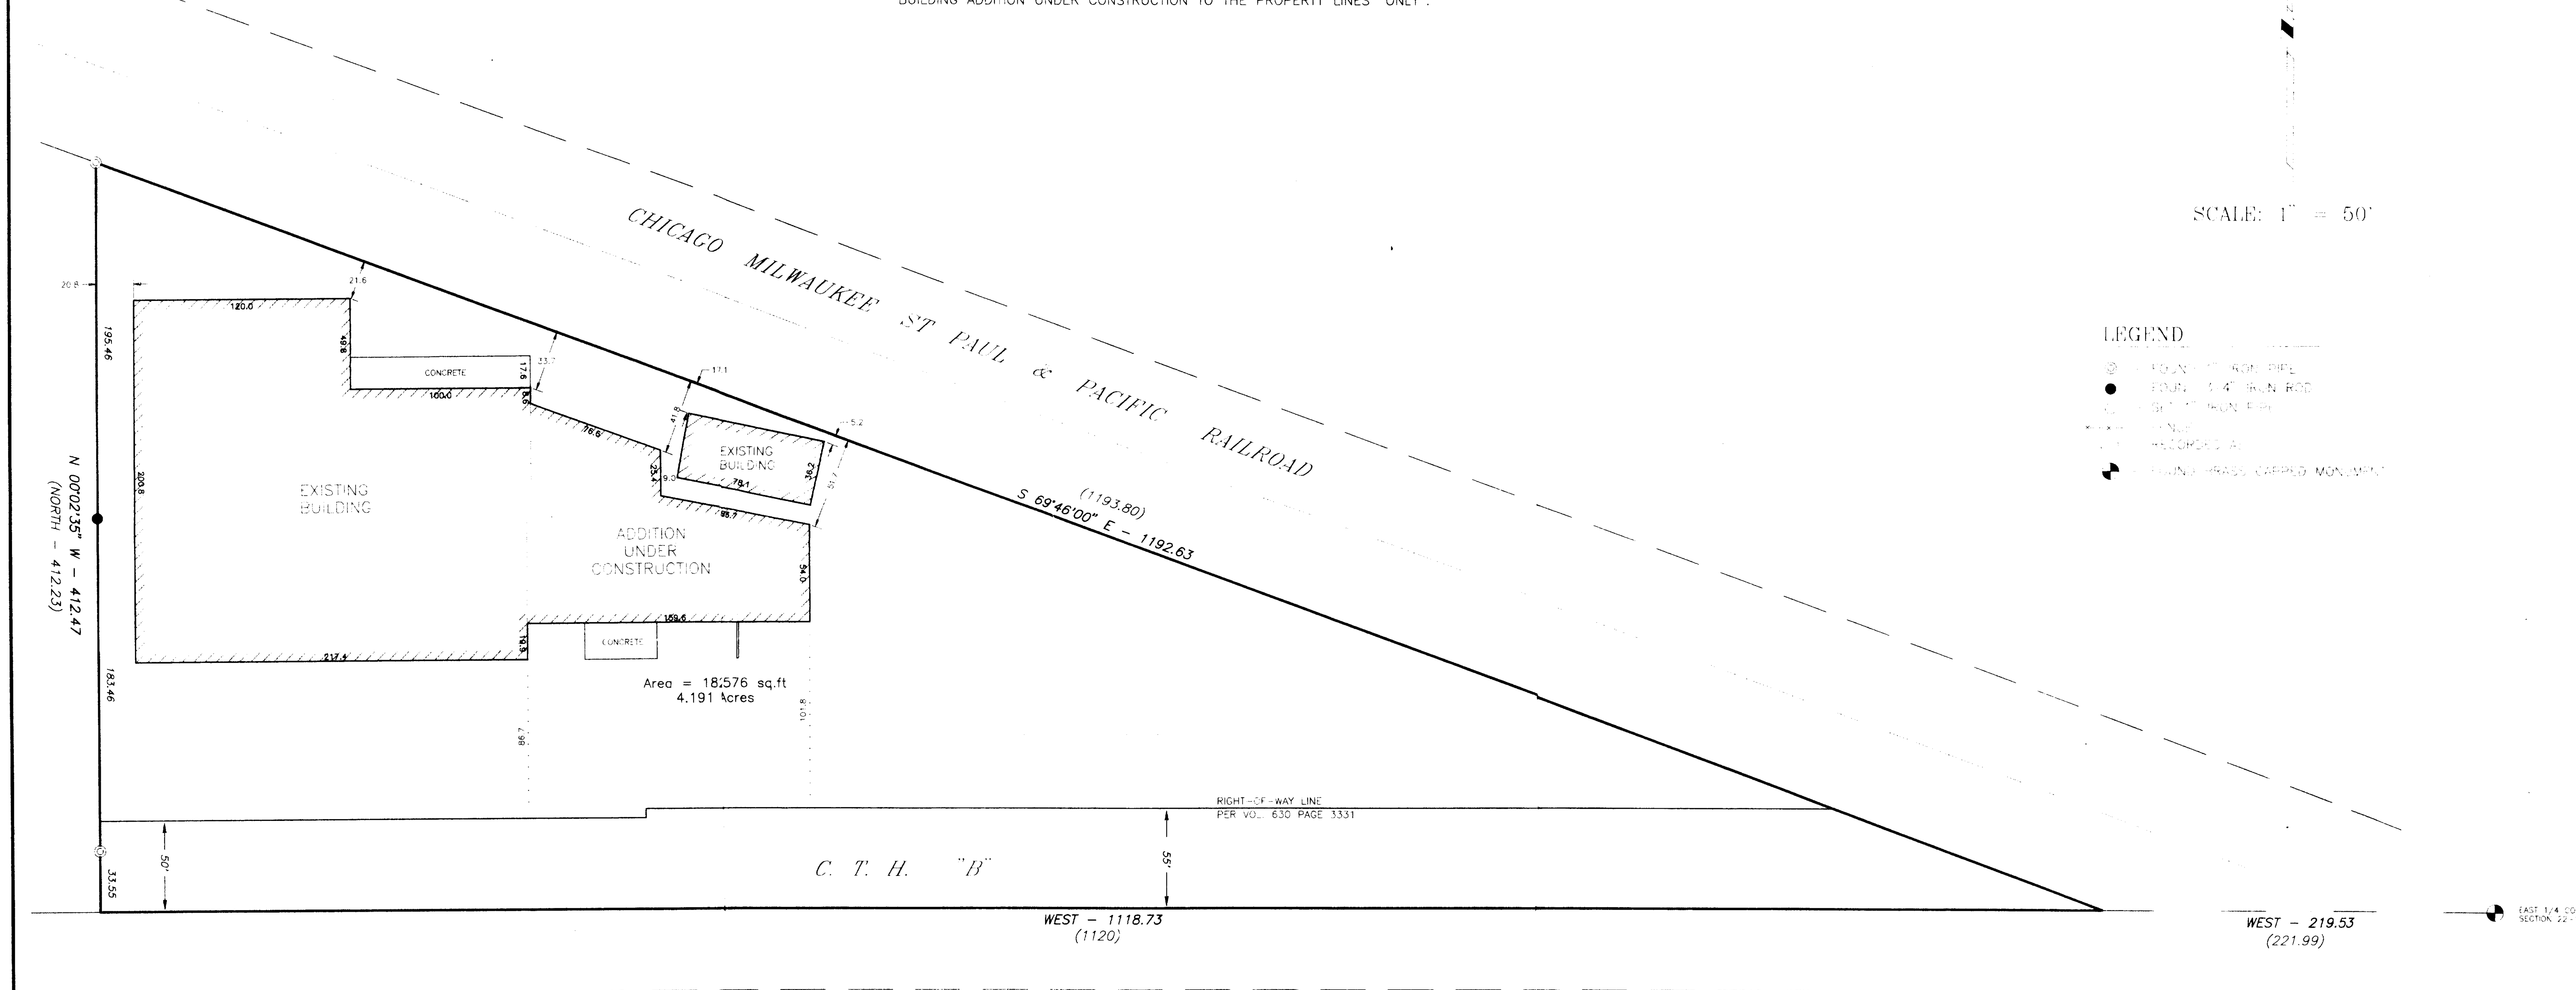

PROJECT

PARTIAL SURVEY
POLYFLEX

PROJECT NO.

993158

DATE

JULY 13, 1999

REVISIONS

ENGINEER / SURVEYOR

GARY B. FOAT
DEGEN, FOAT SURVEYING ASSOCIATES

PREPARED FOR

BOB HARLOW

DRAWN BY

GBF

SCALE

1" = 50'

DEGEN, FOAT SURVEYING ASSOCIATES
100 SOUTH SECOND STREET
WATERFORD, WISCONSIN
(414)534-5404 (FAX)534-2022

RECEIVED SEP 26 1999

I HEREBY CERTIFY THAT I HAVE SURVEYED THE ABOVE DESCRIBED PROPERTY AND THE ABOVE MAP IS A TRUE REPRESENTATION THEREOF AND SHOWS THE SIZE AND LOCATION OF THE PROPERTY, THE LOCATION OF ALL VISIBLE STRUCTURES AND DIMENSIONS OF ALL PRINCIPAL BUILDINGS THEREON, BOUNDARY FENCES, APPARENT EASEMENTS, ROADWAY AND VISIBLE ENCROACHMENTS, IF ANY.

THIS SURVEY IS MADE FOR THE PRESENT OWNERS OF THE PROPERTY, AND ALSO THOSE WHO PURCHASE, OR GUARANTEE THE TITLE THERETO WITHIN (1) YEAR FROM THE DATE HEREOF.

DATED AT WATERFORD, WI THIS 13th DAY OF JULY 1999

RECERTIFIED ______ Gary B. Foat