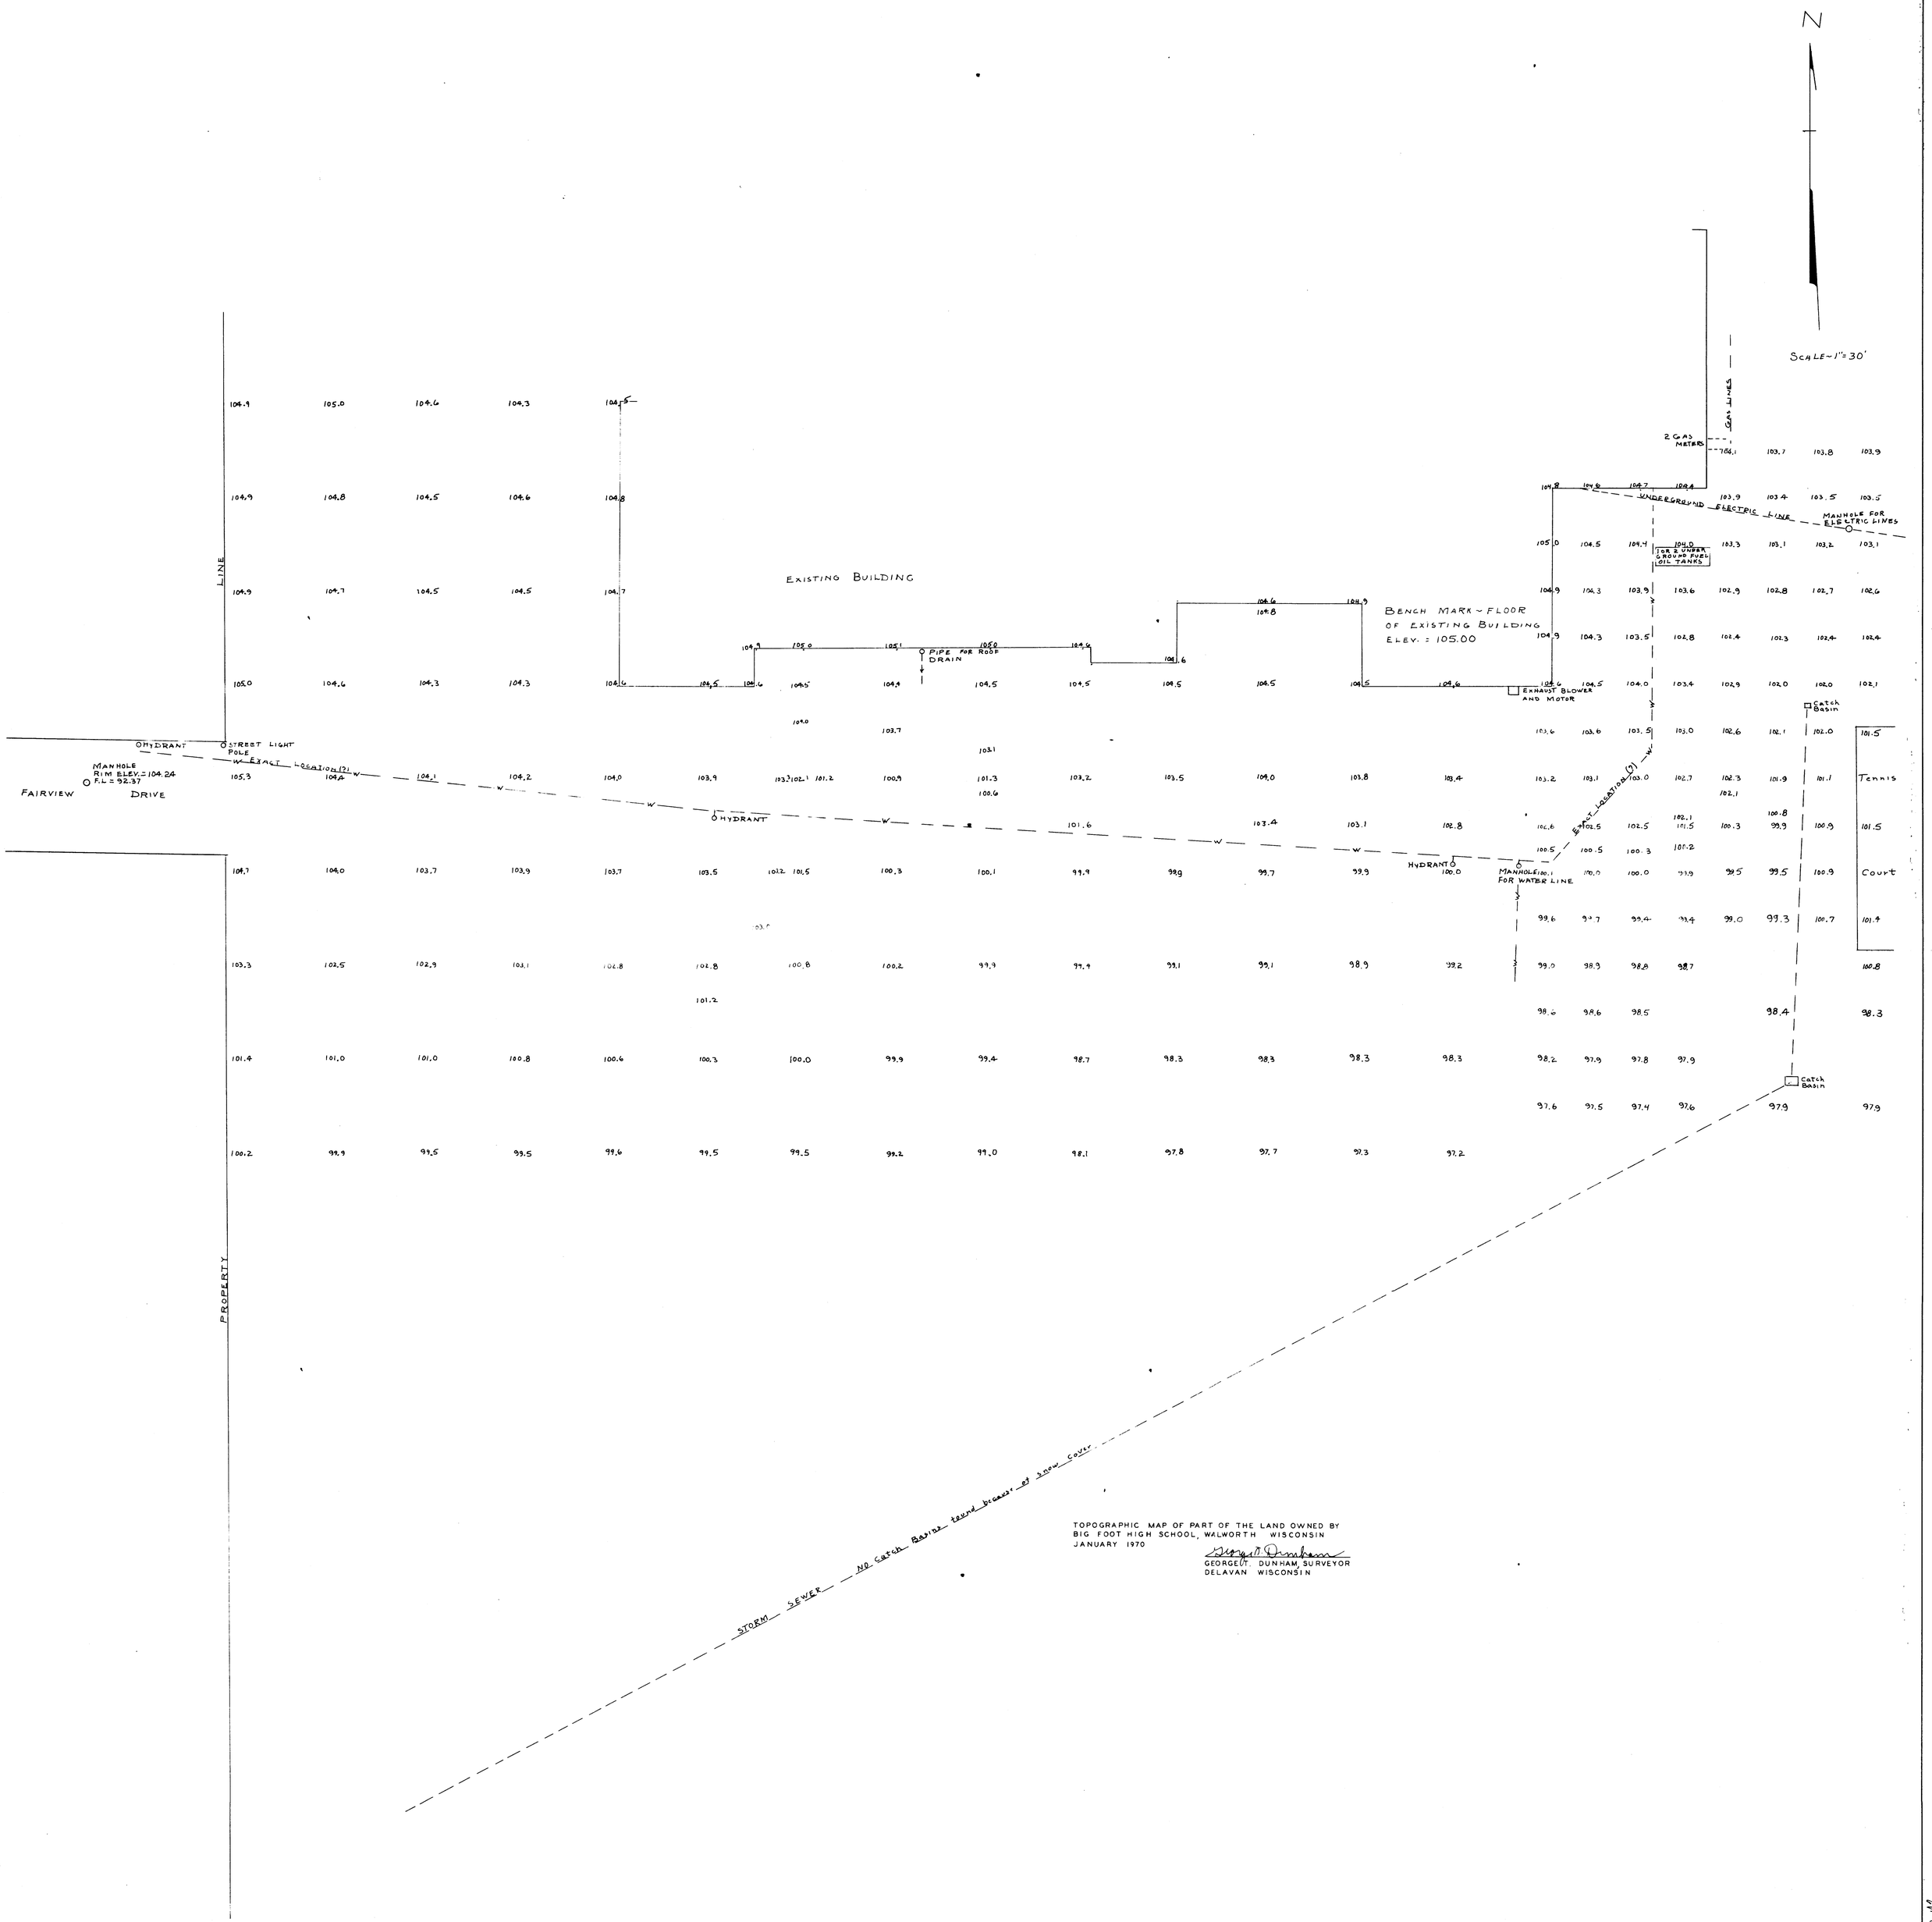

TOPOGRAPHIC MAP OF PART OF THE LAND OWNED BY
BIG FOOT HIGH SCHOOL, WALWORTH WISCONSIN
JANUARY 1970

GEORGE T. DUNHAM, SURVEYOR
DELAVAN WISCONSIN

A-13

UWP-301