DUNHAM SURVEYING, S. C.

SURVEYING & SUBDIVIDING
DELAVAN, WISCONSIN 53115

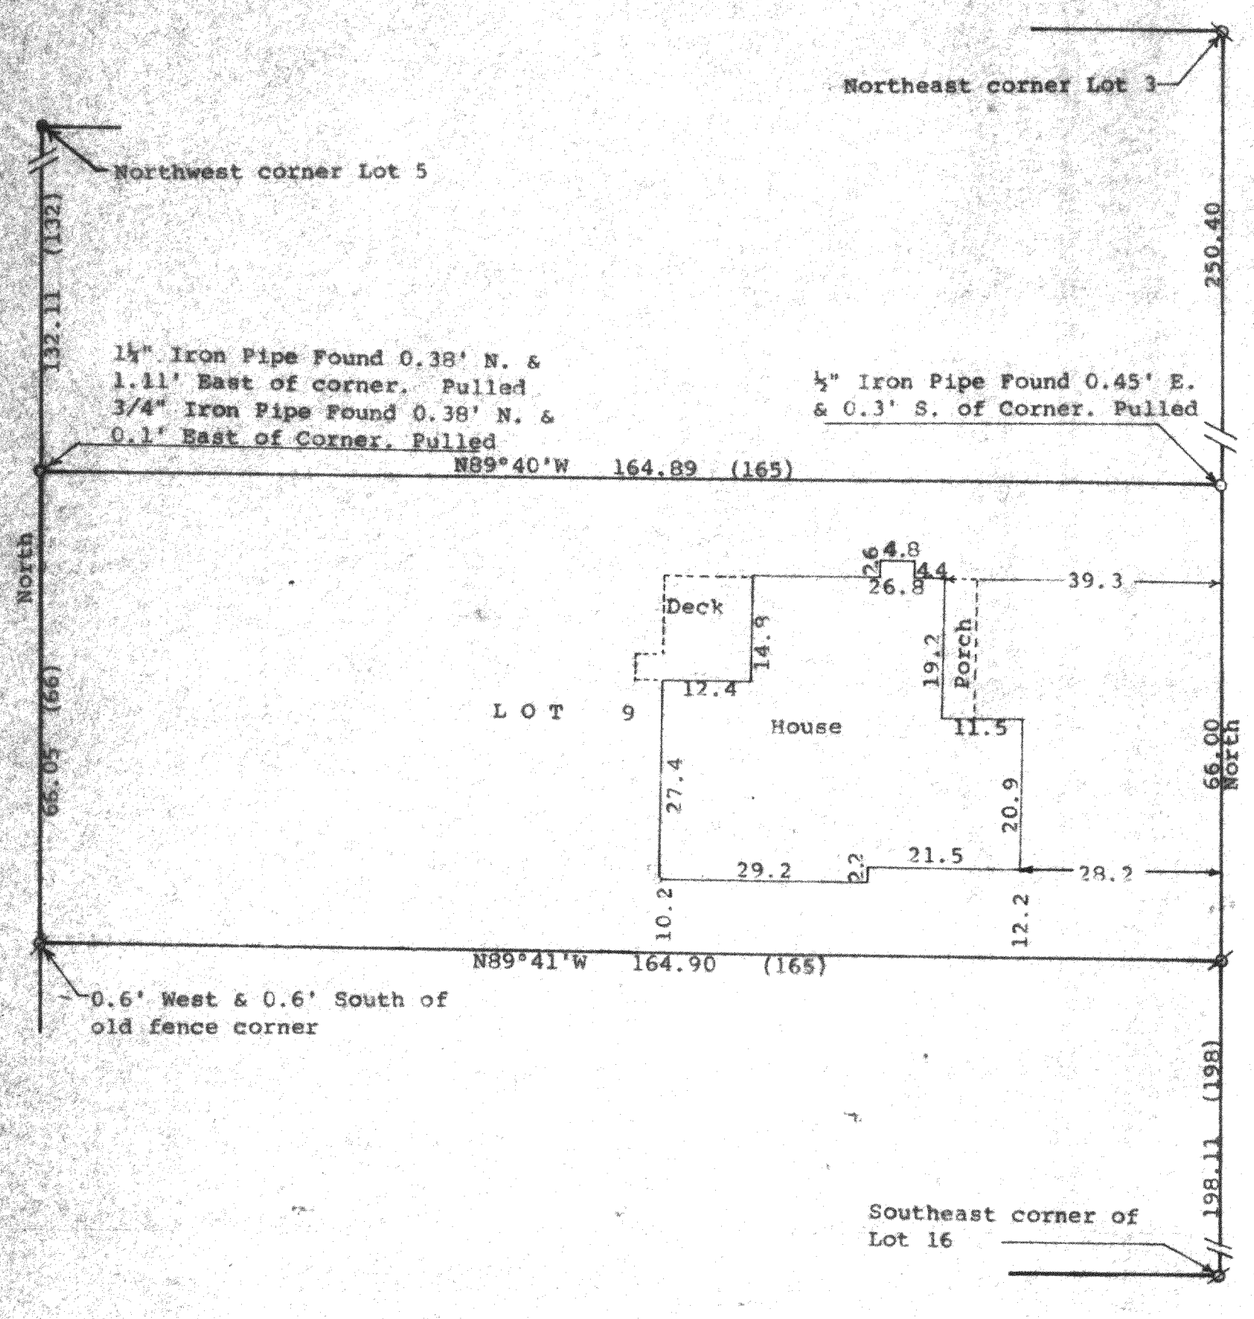

Scale - 1" = 20'
⌀ = 1" Iron Pipe Found
⌀ = 1½" iron Pipe Found
● = 3/4" Iron Pipe Found
-x—— x- = Fence Line
Bearings referenced to the west line of Fifth Street with the assumed bearing of North
Survey ordered by:
Churchill Real Estate
Walworth, WI 53184
o = 3/4" Iron Pipe Set
(0.00) = recorded distance

STATE OF WISCONSIN)
COUNTY OF WALWORTH) SS

I, George T. Dunham, Surveyor, certify that I have surveyed the property described as follows:

Lot 9, Block 1 of E. W. Crumbs Addition to the Village of Walworth, Walworth County, Wisconsin

and that the plat shown hereon is a correct representation thereof and shows the size and location of the property, its exterior boundaries, the location of all visible structures and dimensions of all principal buildings thereon, boundary fences, apparent easements, roadways and visible encroachments, if any, and that I have surveyed the property hereon described, according to the official records, to the best of my knowledge and belief.

June 6, 1995
Updated and recertified to this
18th day of September, 1996

George T. Dunham, Surveyor

RECEIVED
MAY 9 2003
DRP

VECR-6A

009-841