DUNHAM SURVEYING, S.C.

SURVEYING & SUBDIVIDING
DELAVAN, WISCONSIN 53115

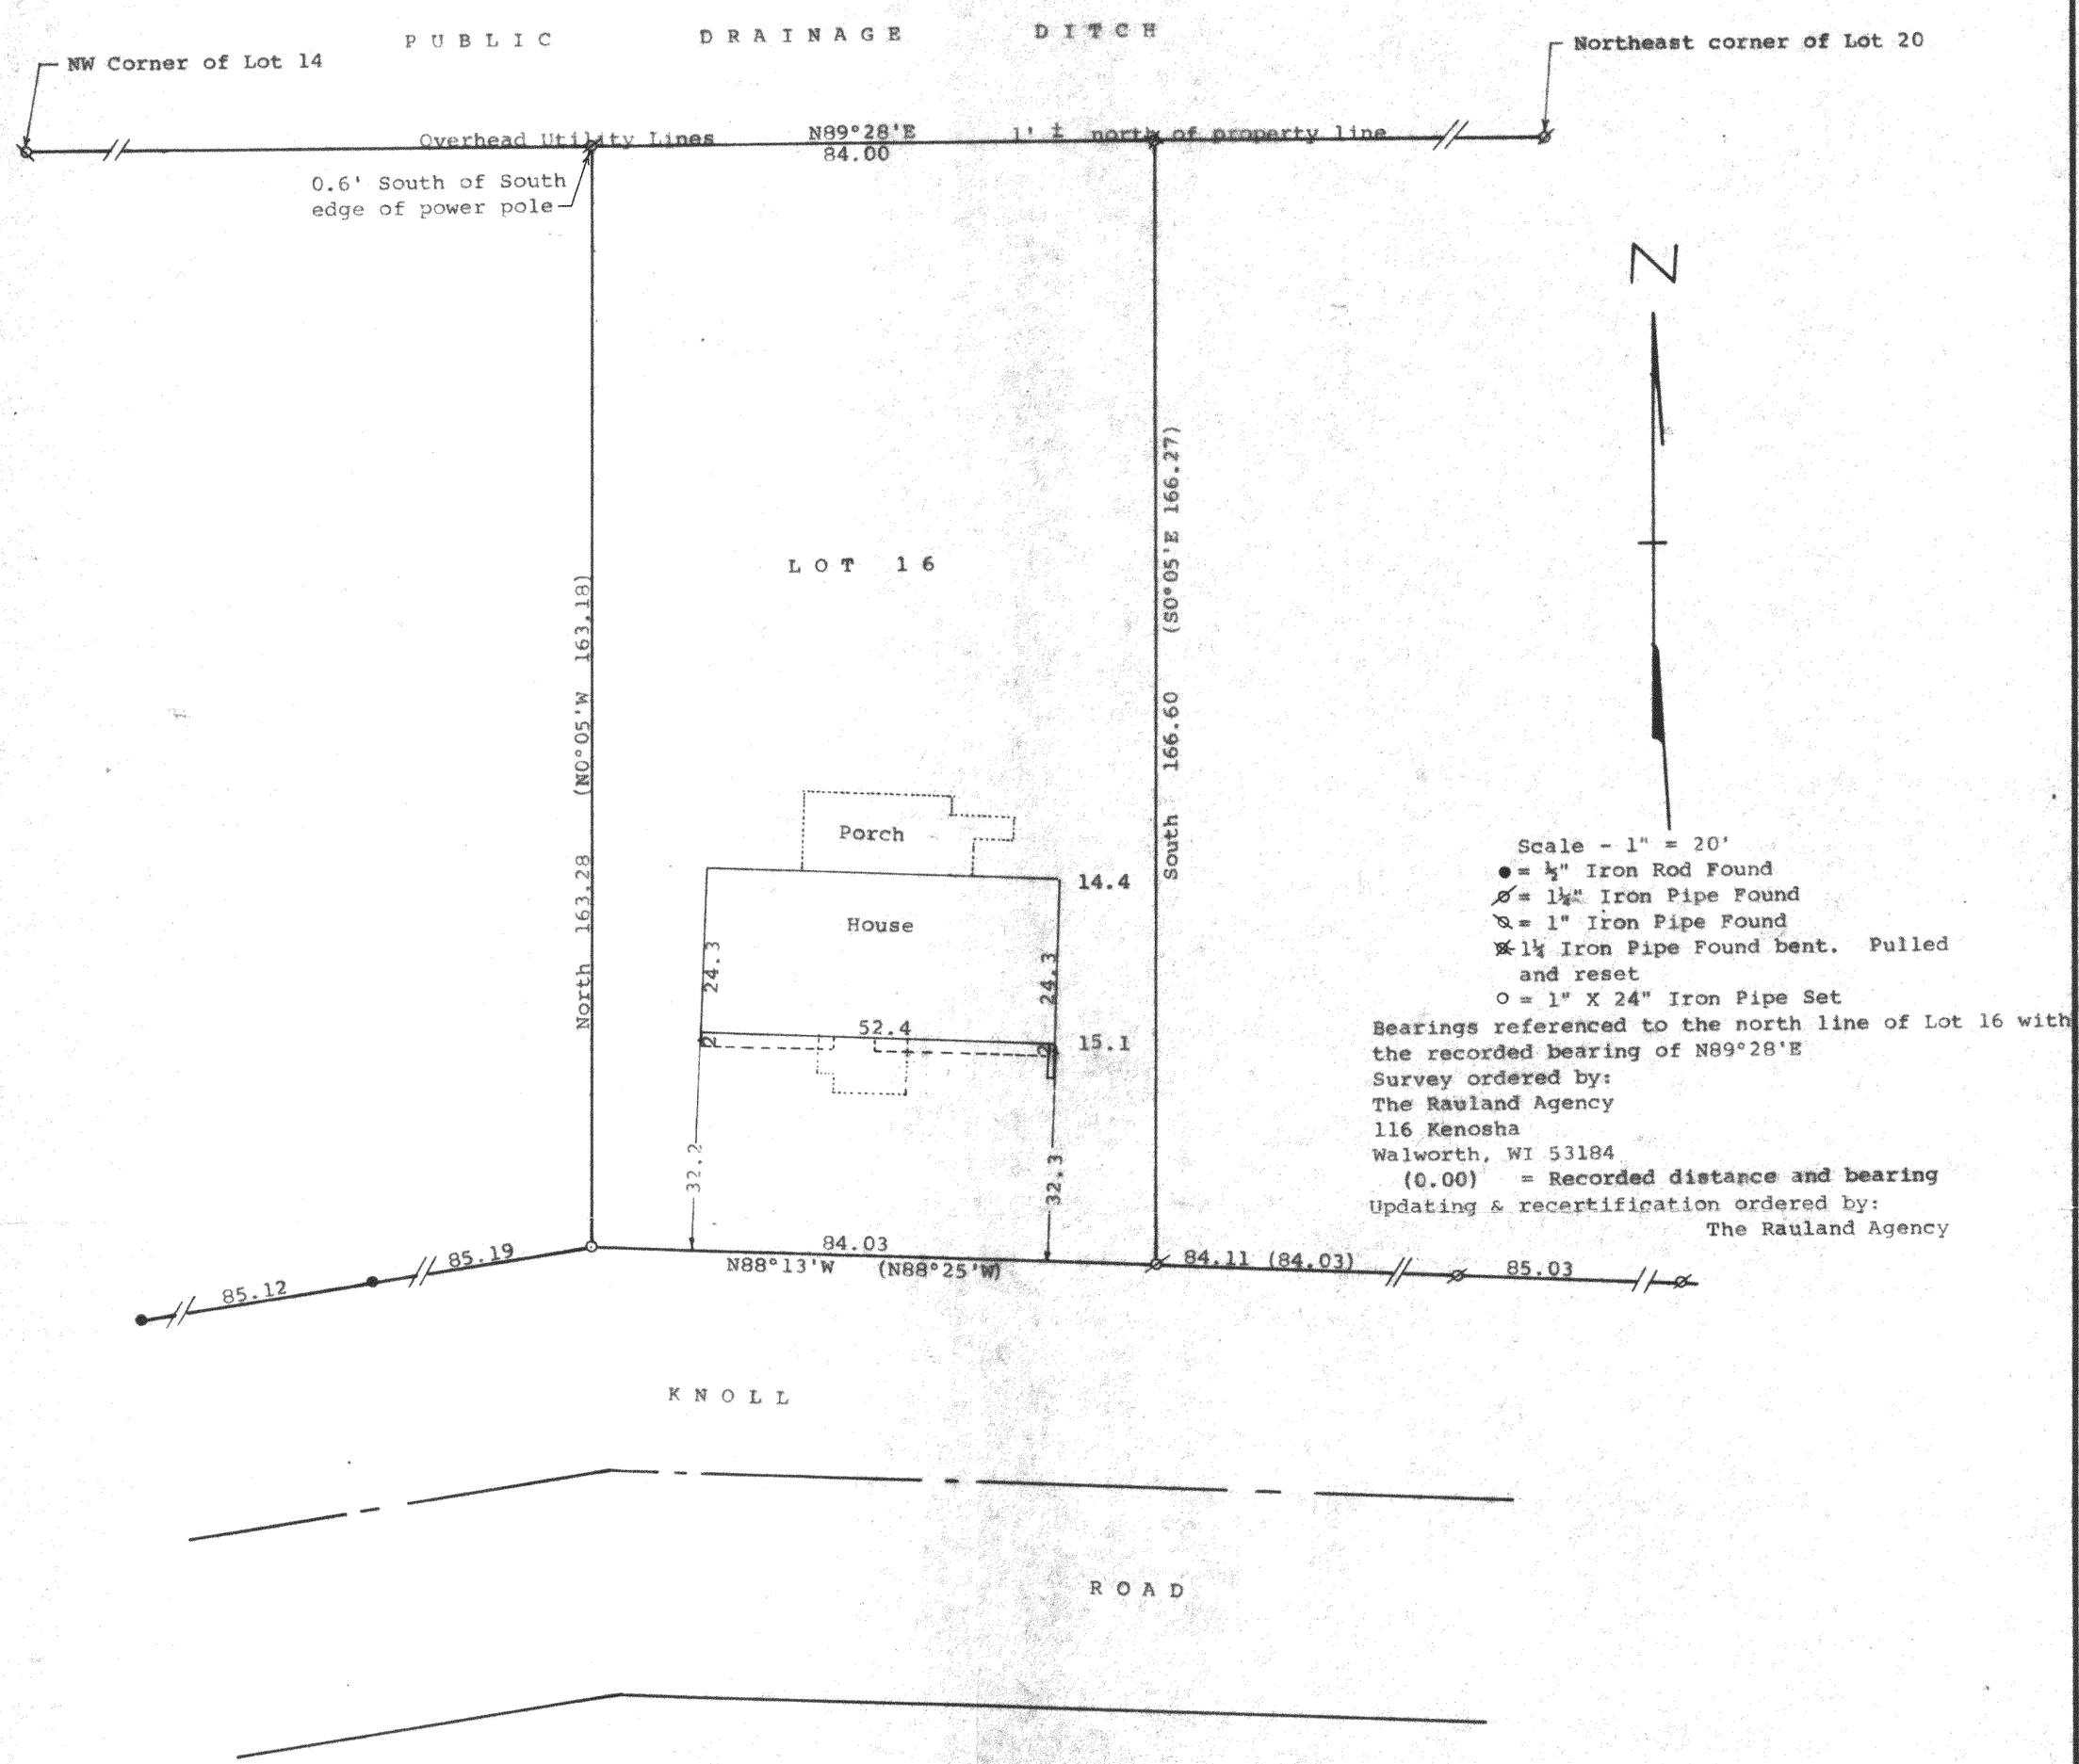

STATE OF WISCONSIN) SS
COUNTY OF WALWORTH)

I, George T. Dunham, Surveyor, certify that I have surveyed the property described as follows:

Lot 16 in Suhr's Subdivision located in the Village of Walworth, Walworth County, Wisconsin

and that the plat shown hereon is a correct representation thereof and shows the size and location of the property, its exterior boundaries, the location of all visible structures and dimensions of all principal buildings thereon, boundary fences, apparent easements, roadways and visible encroachments, if any, and that I have surveyed the property hereon described, according to the official records, to the best of my knowledge and belief.

July 30, 1992
Updated & recertified to this
27th day of February, 1998

George T. Dunham, Surveyor

WISCONSIN GEORGE T. DUNHAM S-306 DELAVAN WIS. LAND SURVEYOR

RECEIVED MAY 9 2008 DRP