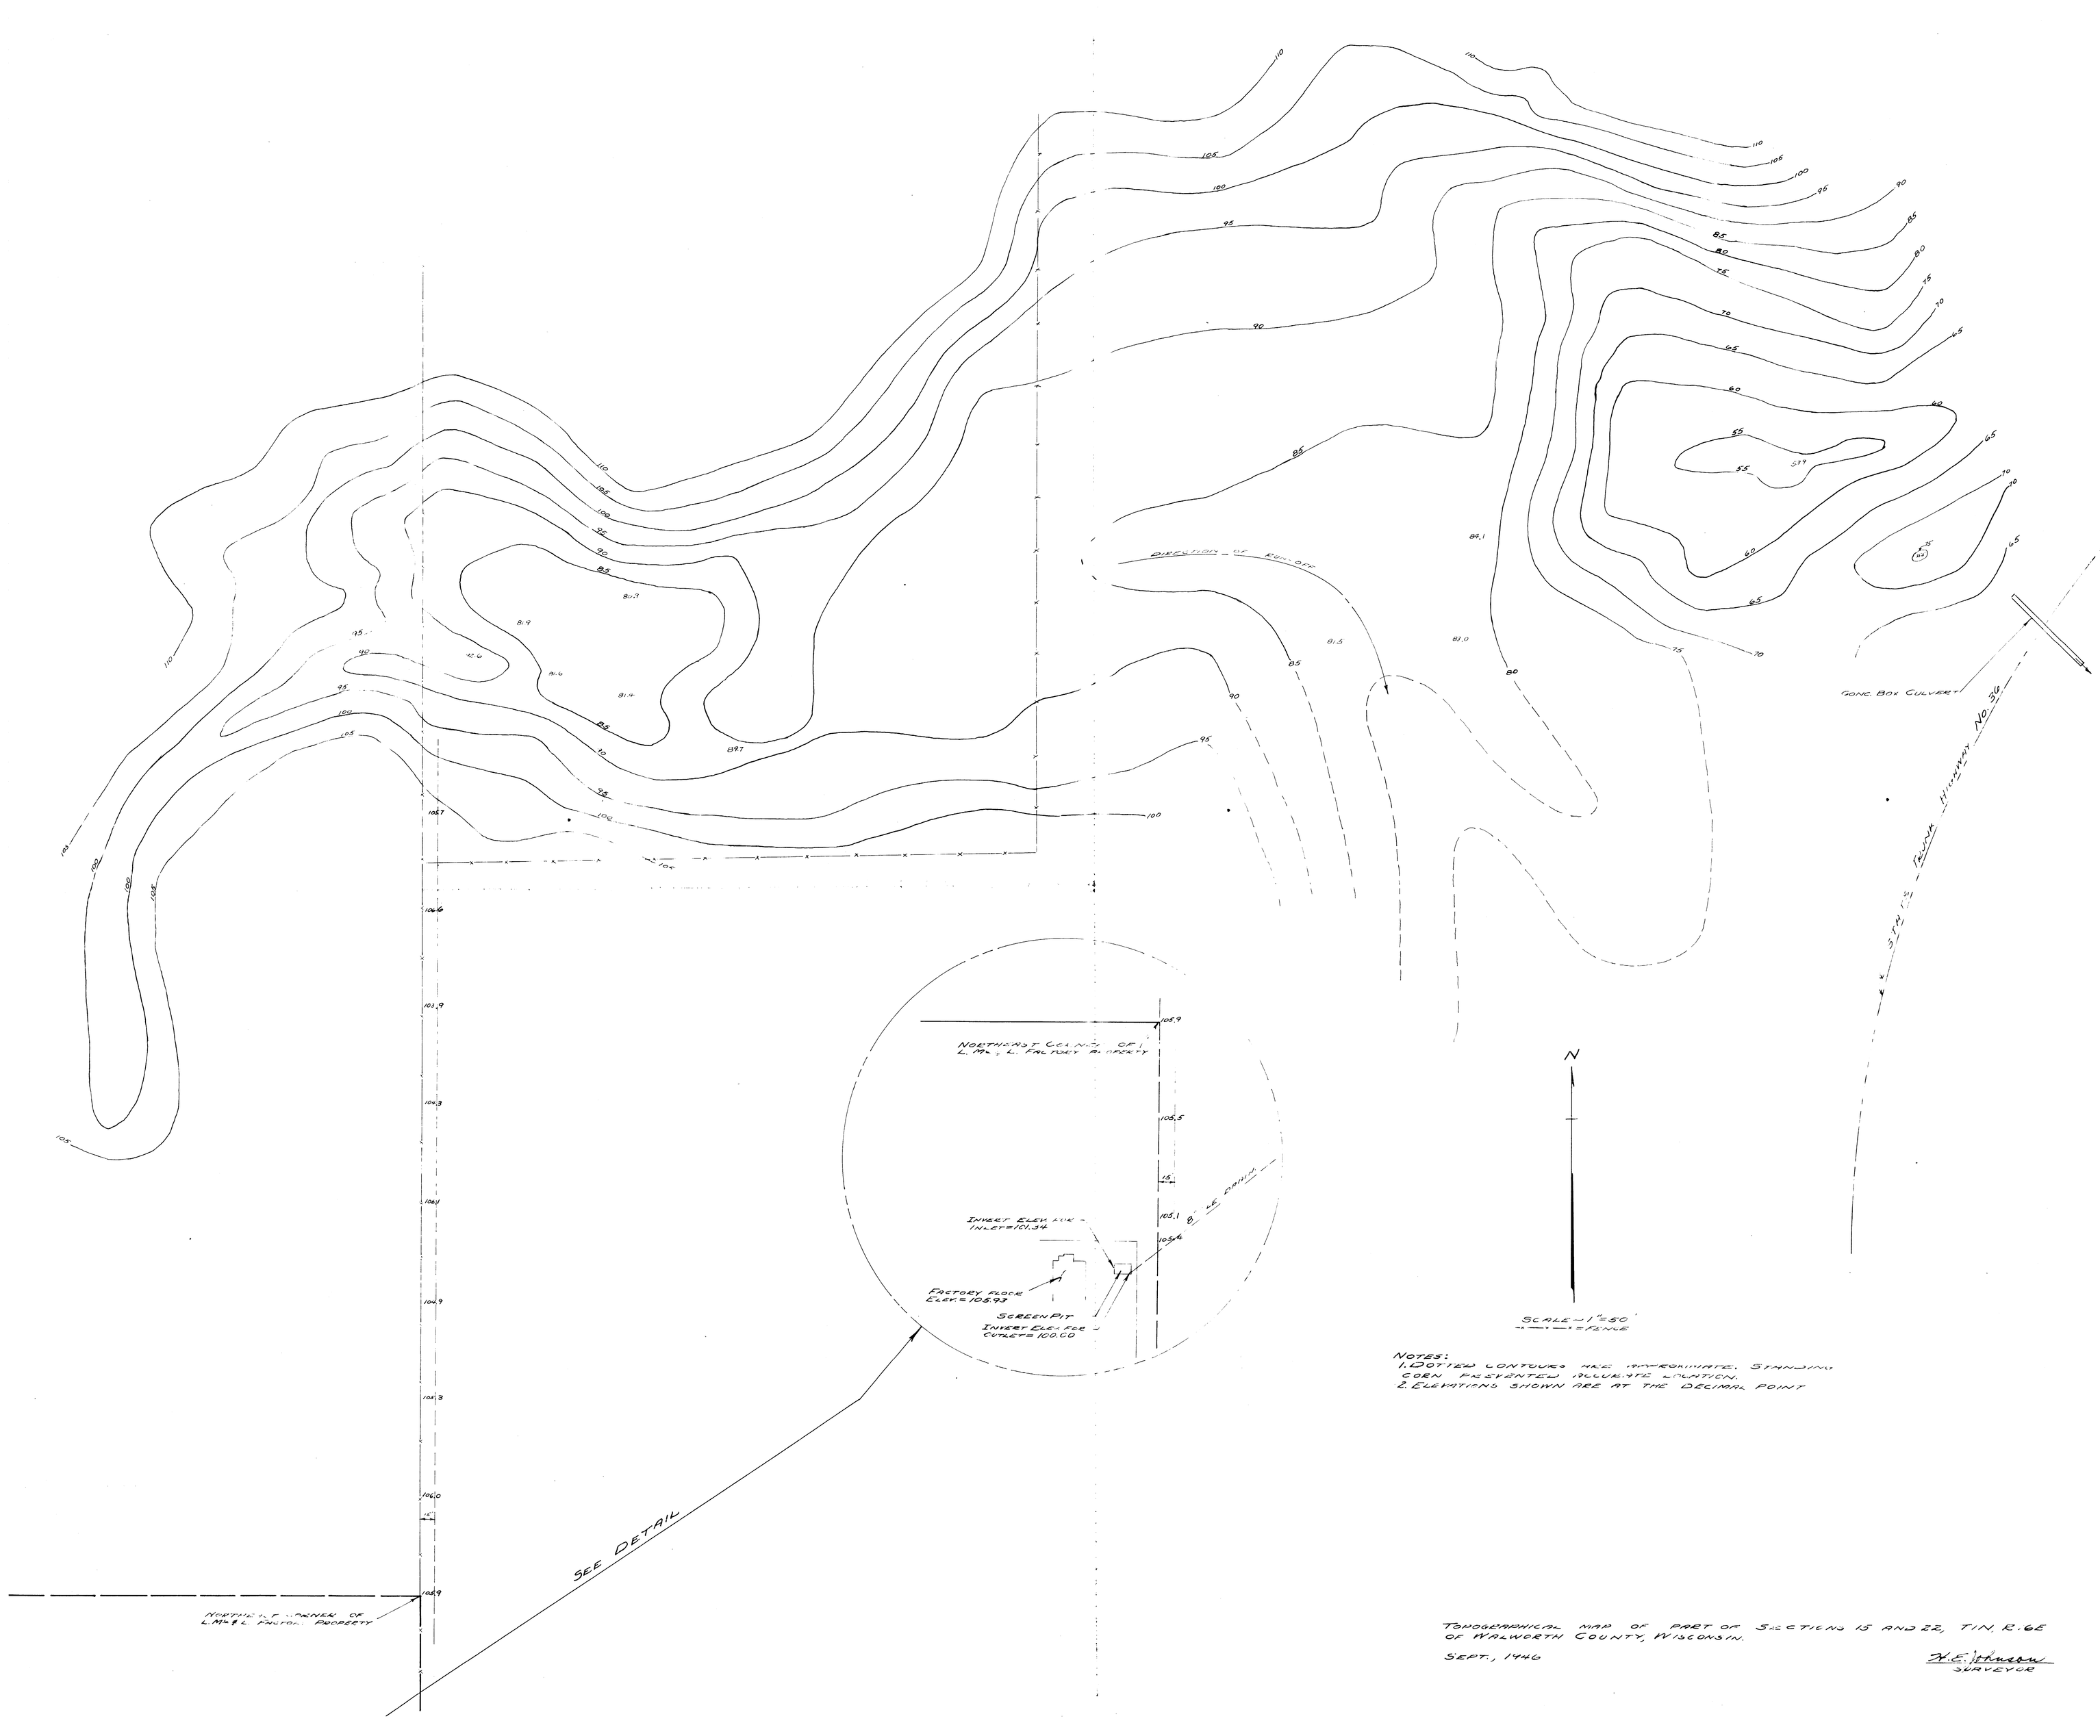


NOTES:
1. DOTTED CONTOURS ARE APPROXIMATE. STANDING CORN PREVENTED ACCURATE LOCATION.
2. ELEVATIONS SHOWN ARE AT THE DECIMAL POINT

TOPOGRAPHICAL MAP OF PART OF SECTIONS 15 AND 22, T1N, R.6E OF WALWORTH COUNTY, WISCONSIN.

SEPT., 1946

H. E. Johnson
SURVEYOR