
#237-71

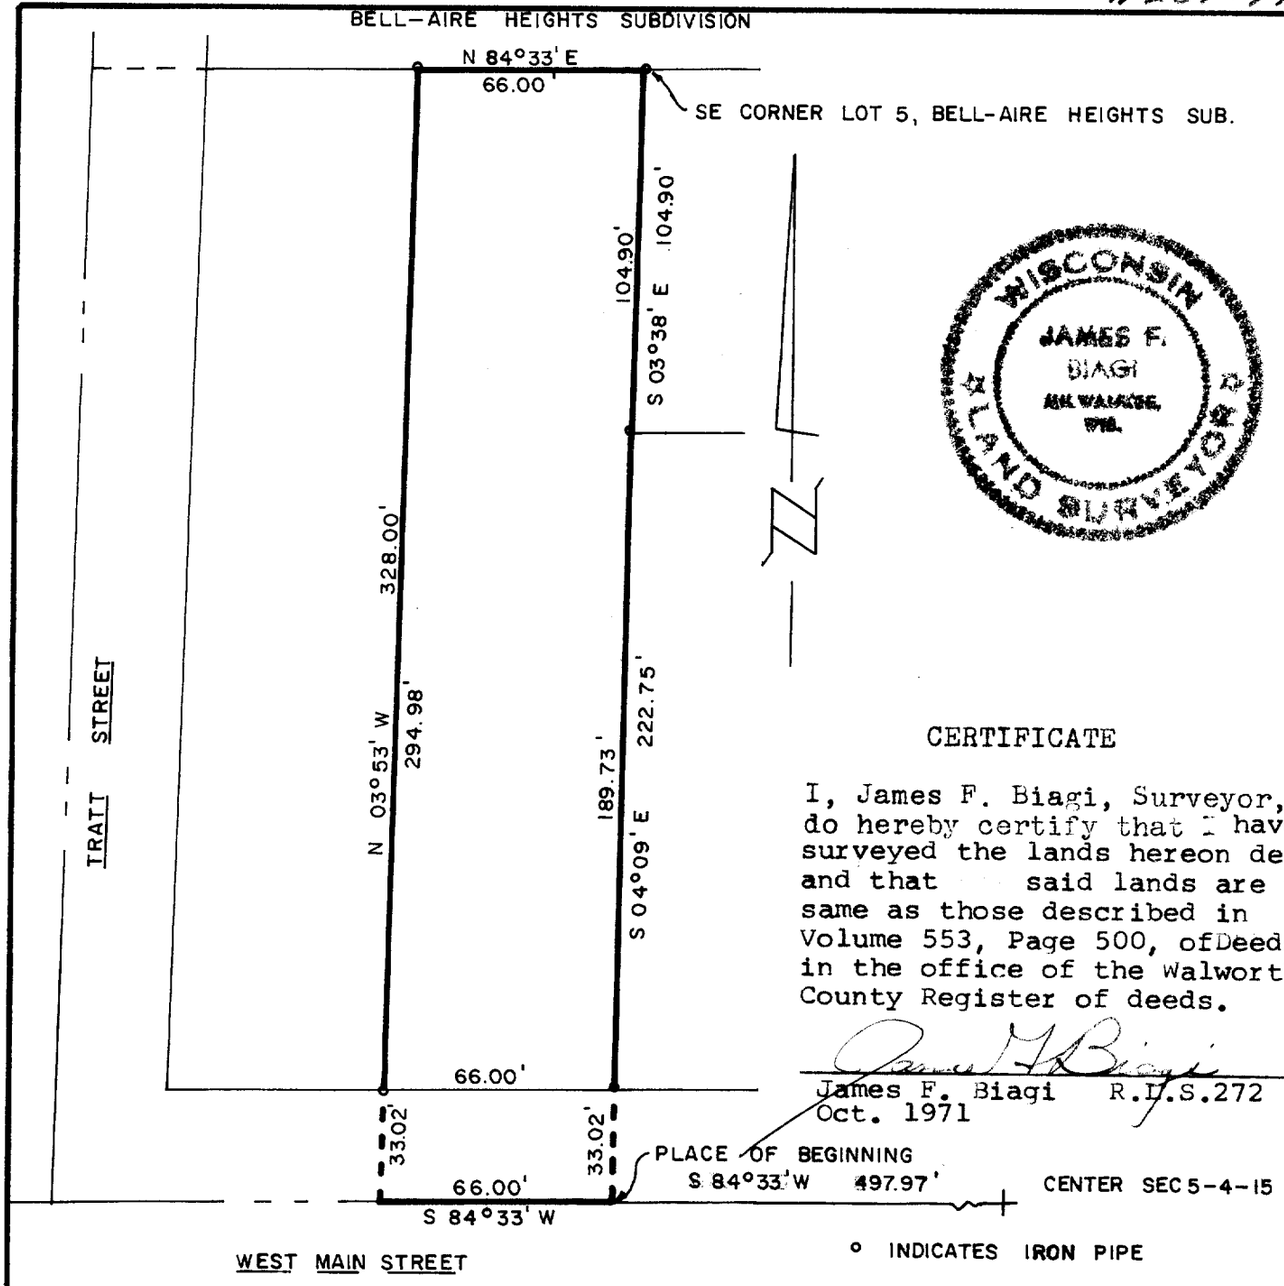

WISCONSIN
JAMES F. BIAGI
MILWAUKEE, WIS.
LAND SURVEYOR

CERTIFICATE

I, James F. Biagi, Surveyor, do hereby certify that I have surveyed the lands hereon described and that said lands are the same as those described in Volume 553, Page 500, of Deeds in the office of the Walworth County Register of deeds.

James F. Biagi R.L.S.272
Oct. 1971

PLAT OF SURVEY OF

A part of the SE¼ of the NW¼ of Section 5, T4N, R15E, City of Whitewater, Walworth County, Wisconsin, described as follows, to-wit:

Commencing at the center of said Section 5; thence S 84°33' W along the East-West ¼ line of said section 5 (also the centerline of Main Street) 497.97 feet to the place of beginning; Thence Continue S 84°33' W along said East-West ¼ line 66.00 feet; Thence N 03°53' W, 328.00 feet to an iron pipe on the South line of Bell-Aire Heights Subdivision; Thence N 84°33' E along said South line of said Bell-Aire Heights Subdivision 66.00 feet to an iron pipe marking the SE corner of Lot 5 of said Bell-aire Heights Subdision; Thence S 03°38' E, 104.90 feet to an iron pipe; Thence S 04°09' E, 222.75 feet to the place of beginning.

UP-168

10-10B