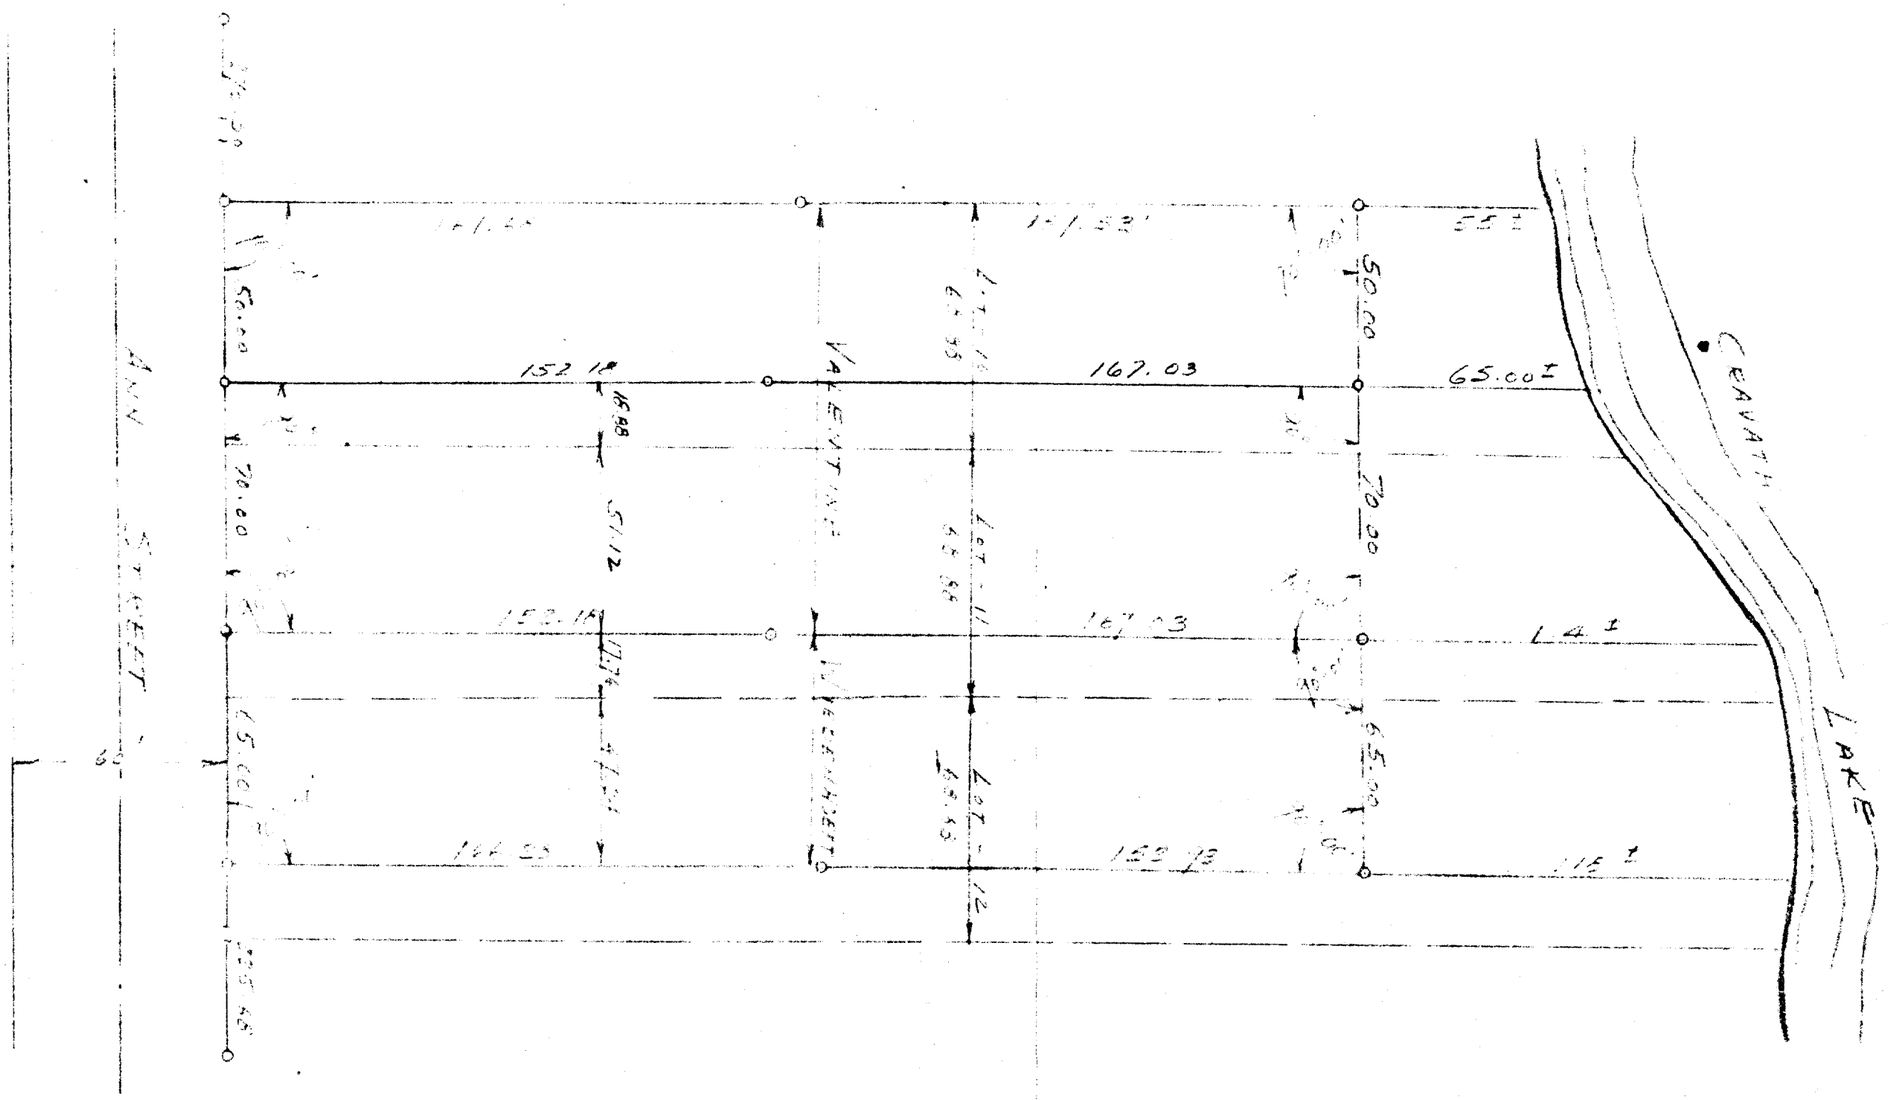

WISCONSIN
GEORGE
BRUCE
WILSON
HARTLAND
WIS.
LAND SURVEYOR

REVISED SEPT. 6 1960
George B. Wilson

TR-36

10-112

PLAT OF SURVEY
OF

LOT 10, LOT 11 AND PART OF LOT 12, BLOCK 5 - TRIPP'S ADDITION TO THE CITY OF WHITEWATER.

George B. Wilson
SURVEYOR

SCALE 1" = 40'

DATE OCT 20, 1964