PLAT OF SURVEY

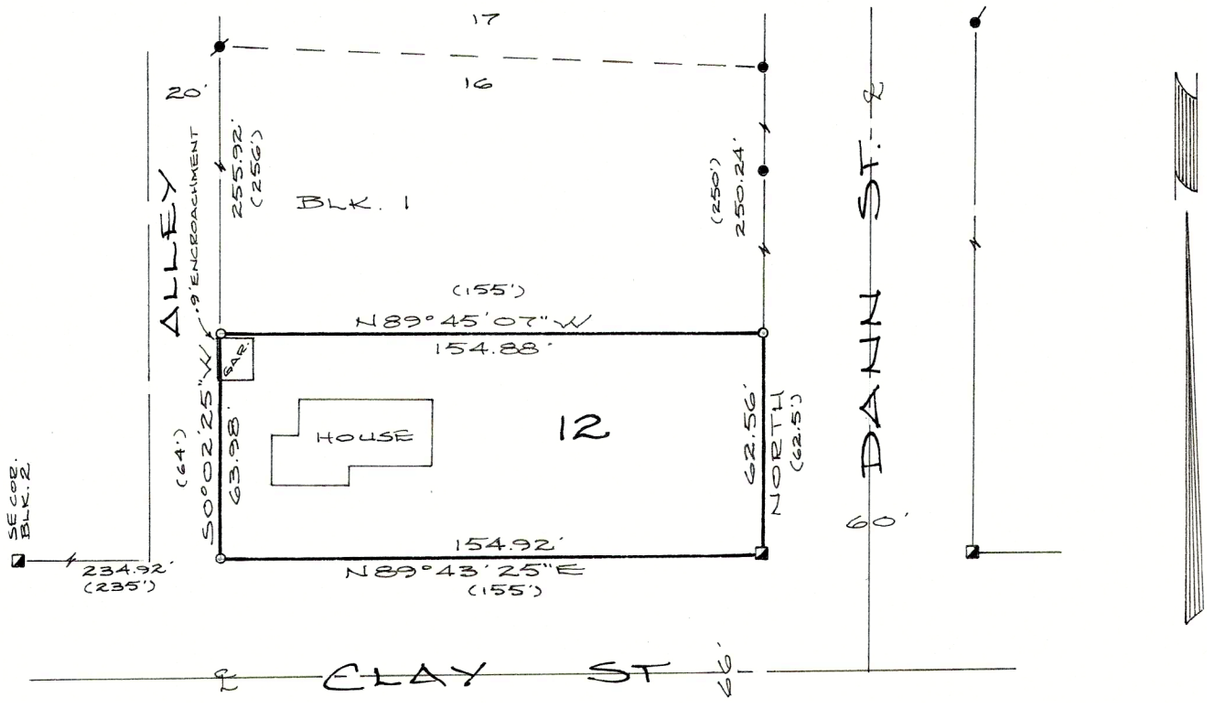

- ◪ Found 4" Diameter Concrete Monument
- ⦿ Found 1¼" Iron Pipe
- ● Found 1" Iron Pipe
- ○ Set 1"x24" Iron Pipe

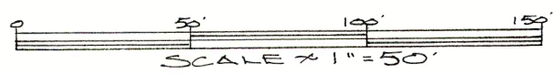

DESCRIPTION
Lot 12, Block 1, TRIPPE AND POSEY'S SUBDIVISION of Block 10 of TRIPPE'S SECOND ADDITION TO THE VILLAGE (NOW CITY) OF WHITEWATER in the SE¼ of Section 4, T4N, R15E, City of Whitewater, Walworth County, Wisconsin.

CERTIFICATION
I hereby certify that the property described above has been surveyed under my responsible direction and supervision and that this map is an accurate representation of the lot lines and dimensions.

Date 6-1-92

James B. Woodman
Registered Land Surveyor, S-1239

WISCONSIN
JAMES B. WOODMAN
S-1239
FORT ATKINSON, WIS.
LAND SURVEYOR

Prepared for: Laurie Butler, Owner
P.O. Box 274
Whitewater, WI 53190

010-1160 ITRP-11 Sheet 1 of 1 JN 92S-90

WOODMAN, ANDERSON & ASSOCIATES **Registered Land Surveyors**
210 Madison Avenue, Fort Atkinson, WI 53538 Phone (414) 563-8162