


PLAT OF SURVEY

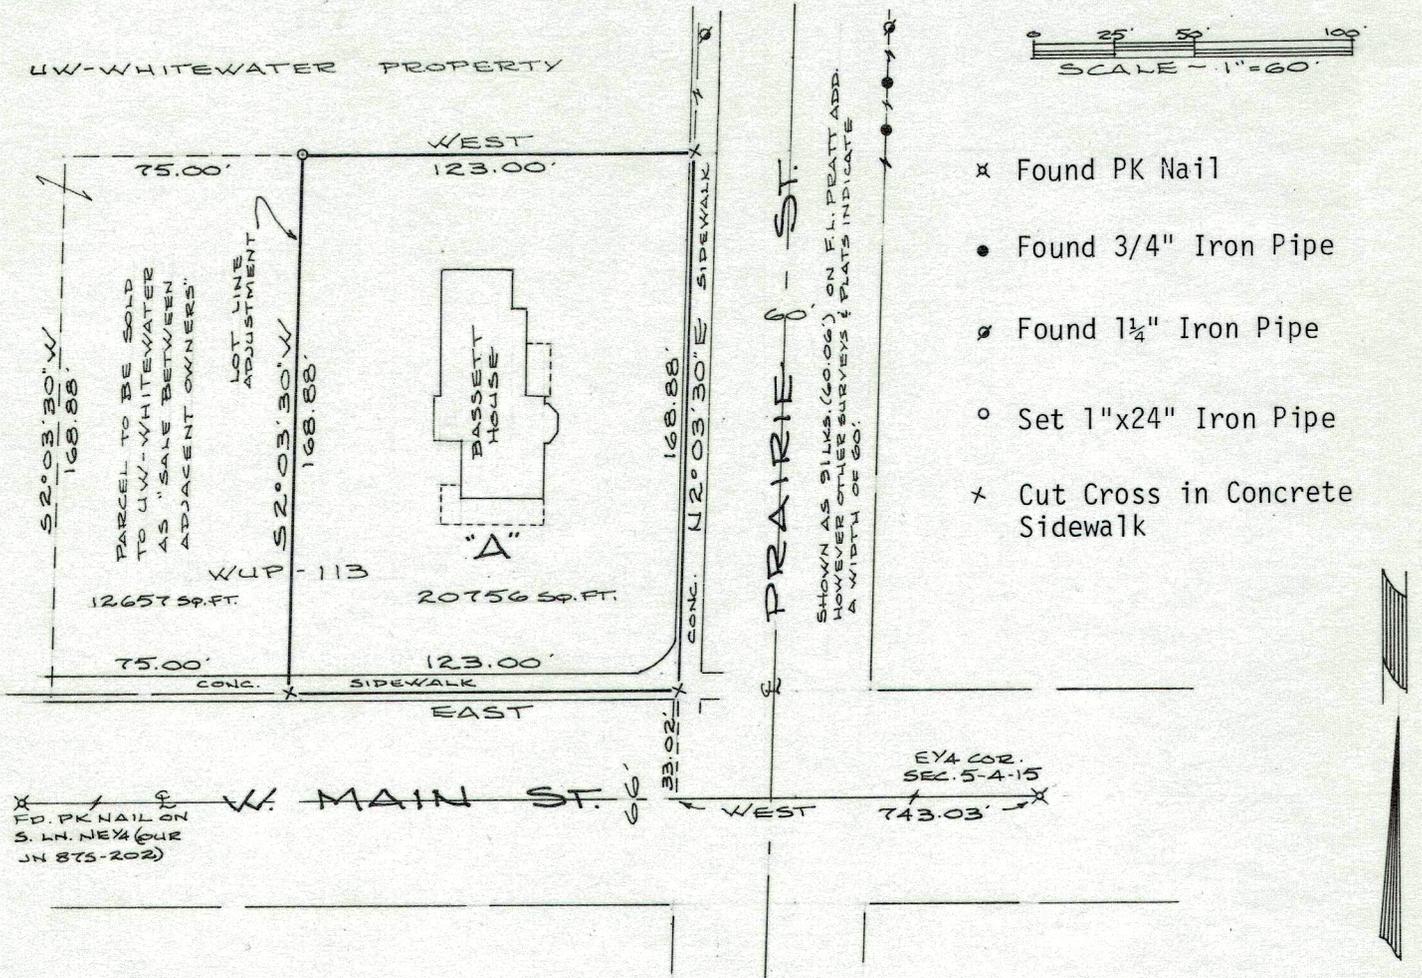

DESCRIPTION Parcel "A"


A part of the SE $\frac{1}{4}$ of the NE $\frac{1}{4}$ of Section 5, T4N, R15E, City of Whitewater, Walworth County, Wisconsin, to-wit:

Commencing at the E $\frac{1}{4}$ corner of said Section 5; thence WEST, along the south line of said NE $\frac{1}{4}$, also being the centerline of W. Main Street, 743.03 feet; thence N02 $^{\circ}$ 03'30"E, along the extension of the west line of Prairie Street, 33.02 feet to a cross cut in concrete on the north line of said W. Main Street and the point of beginning; thence continue N02 $^{\circ}$ 03'30"E, along said west line, 168.88 feet to a cross cut in concrete; thence WEST, 123.00 feet to a 1" iron pipe; thence S02 $^{\circ}$ 03'30"W, 168.88 feet to a cross cut in concrete on said north line of W. Main Street; thence EAST, along said north line, 123.00 feet to the point of beginning, containing 20756 square feet.

CERTIFICATION

I hereby certify that the property described above has been surveyed under my responsible direction and supervision and that this map is a correct representation of the lot lines and dimensions and the principle lines of the permanent structures thereon.

Date 12-23-88

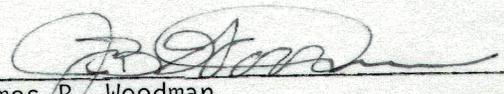
James B. Woodman
Registered Land Surveyor, S-1239

Prepared for: Dr. James Colmey
UW-Whitewater
Whitewater, WI 53190

