PLAT OF SURVEY

BEING ALL OF LOT 33 AND LOT 34 OF THE RE-PLAT OF MOUND MEADOWS,
LOCATED IN THE NW 1/4 AND NE 1/4 OF THE SE 1/4,
SECTION 6, TOWNSHIP 4 NORTH, RANGE 15 EAST,
CITY OF WHITEWATER, WALWORTH COUNTY, WISCONSIN

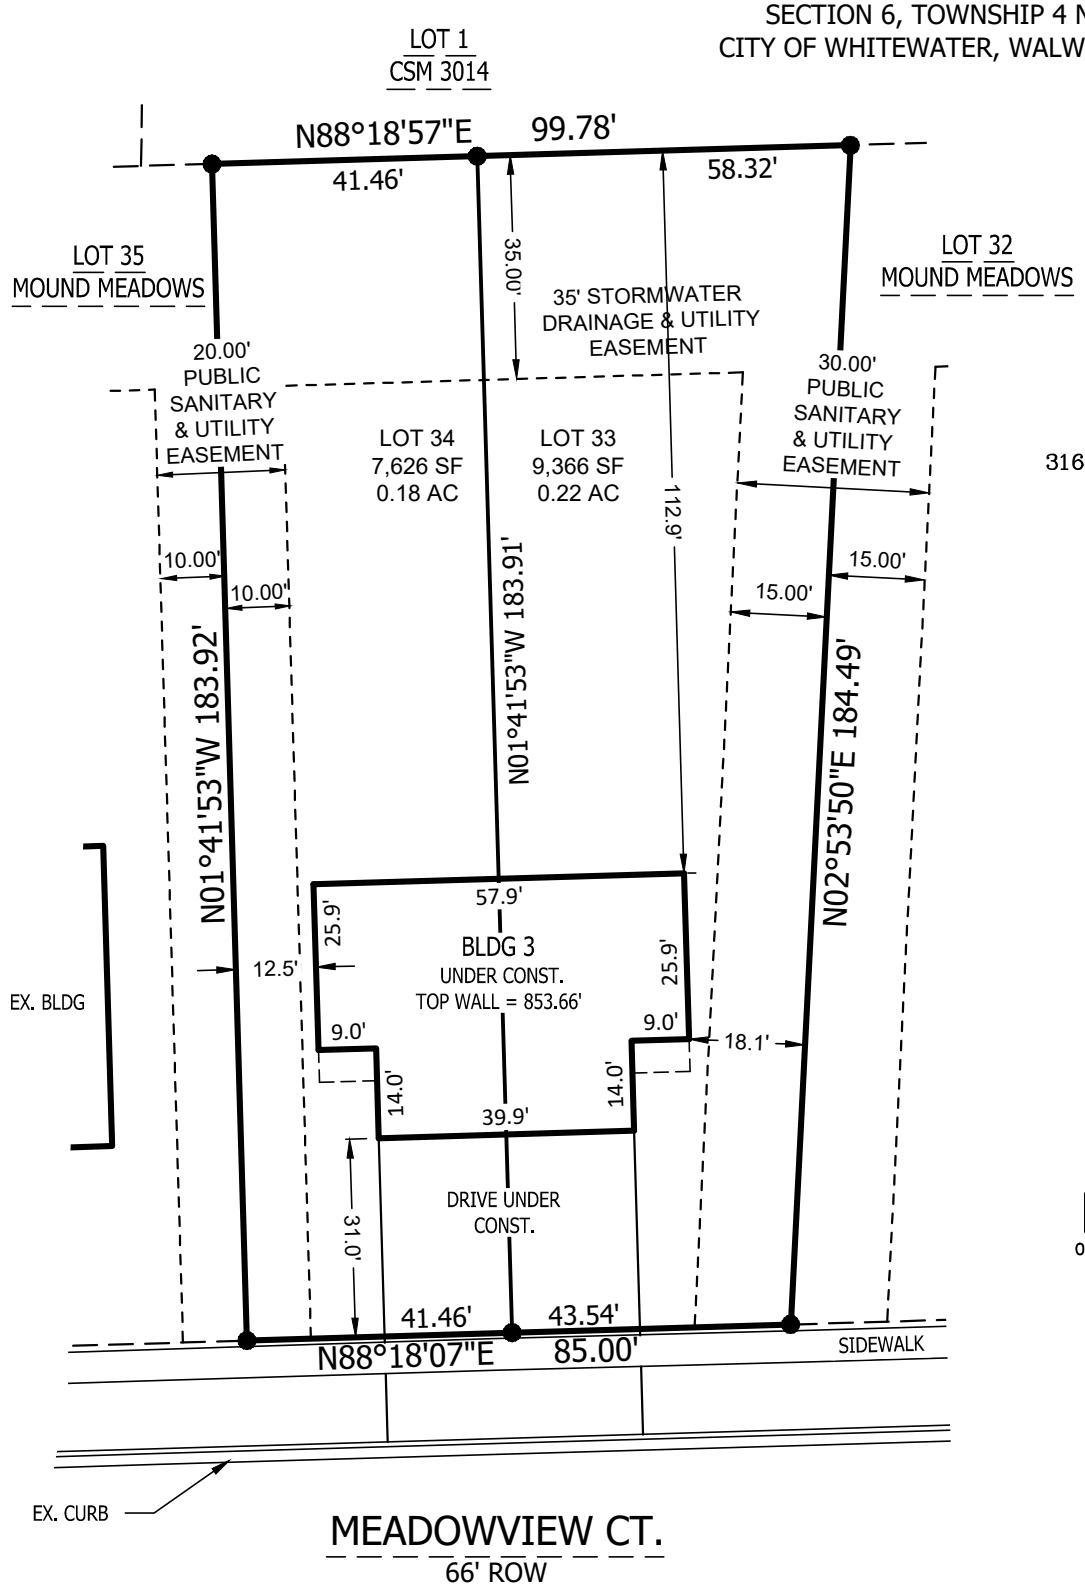

SURVEYOR:
KEITH A. KINDRED, RLS S-2082
SEH
501 MAPLE AVE
DELAFIELD, WI 53018
(414) 949-8919
KKINDRED@SEHINC.COM

SURVEY FOR:
U.S. SHELTER HOMES LLC
31632 NORTH ELLIS DRIVE, UNIT 213
VOLO, ILLINOIS, 60073

LEGEND

● – 3/4" IRON PIPE FOUND (UNLESS OTHERWISE STATED)

SCALE: 1" = 30'

0 15' 30' 60'

WISCONSIN
KEITH A. KINDRED
S-2082
OSHKOSH, WI
LAND SURVEYOR

JULY 26, 2024

SURVEYOR'S CERTIFICATE:

I HEREBY CERTIFY THAT I HAVE SURVEYED THE ABOVE DESCRIBED PROPERTY AND THAT THE ABOVE MAP IS A TRUE REPRESENTATION THEREOF AND SHOWS THE SIZE AND LOCATION OF THE PROPERTY, ITS EXTERIOR BOUNDARIES, THE LOCATION OF ALL VISIBLE STRUCTURES AND DIMENSIONS OF ALL PRINCIPAL BUILDINGS THEREON, BOUNDARY FENCES, APPARENT EASEMENTS, ROADWAYS, AND VISIBLE ENCROACHMENTS, IF ANY.

THIS SURVEY IS MADE FOR THE USE OF THE PRESENT OWNERS OF THE PROPERTY, AND ALSO THOSE WHO PURCHASE, MORTGAGE, OR GUARANTEE THE TITLE THERETO WITHIN ONE (1) YEAR FROM DATE HEREOF.

SEH
PHONE: 262.646.6855
501 MAPLE AVENUE
DELAFIELD, WI 53018
www.sehinc.com

PATH: X:\UZ\U\USSHE\175452\9-SURVEY\92-CAD\10-C3D\USSHE 175452 BSO.DWG