PLAT OF SURVEY

LOTS 37 AND 38 OF THE RE-PLAT OF MOUND MEADOWS, LOCATED IN THE NW 1/4 AND NE 1/4 OF THE SE 1/4 OF SECTION 6, T4N, R15E, CITY OF WHITEWATER, WALWORTH COUNTY, WISCONSIN.

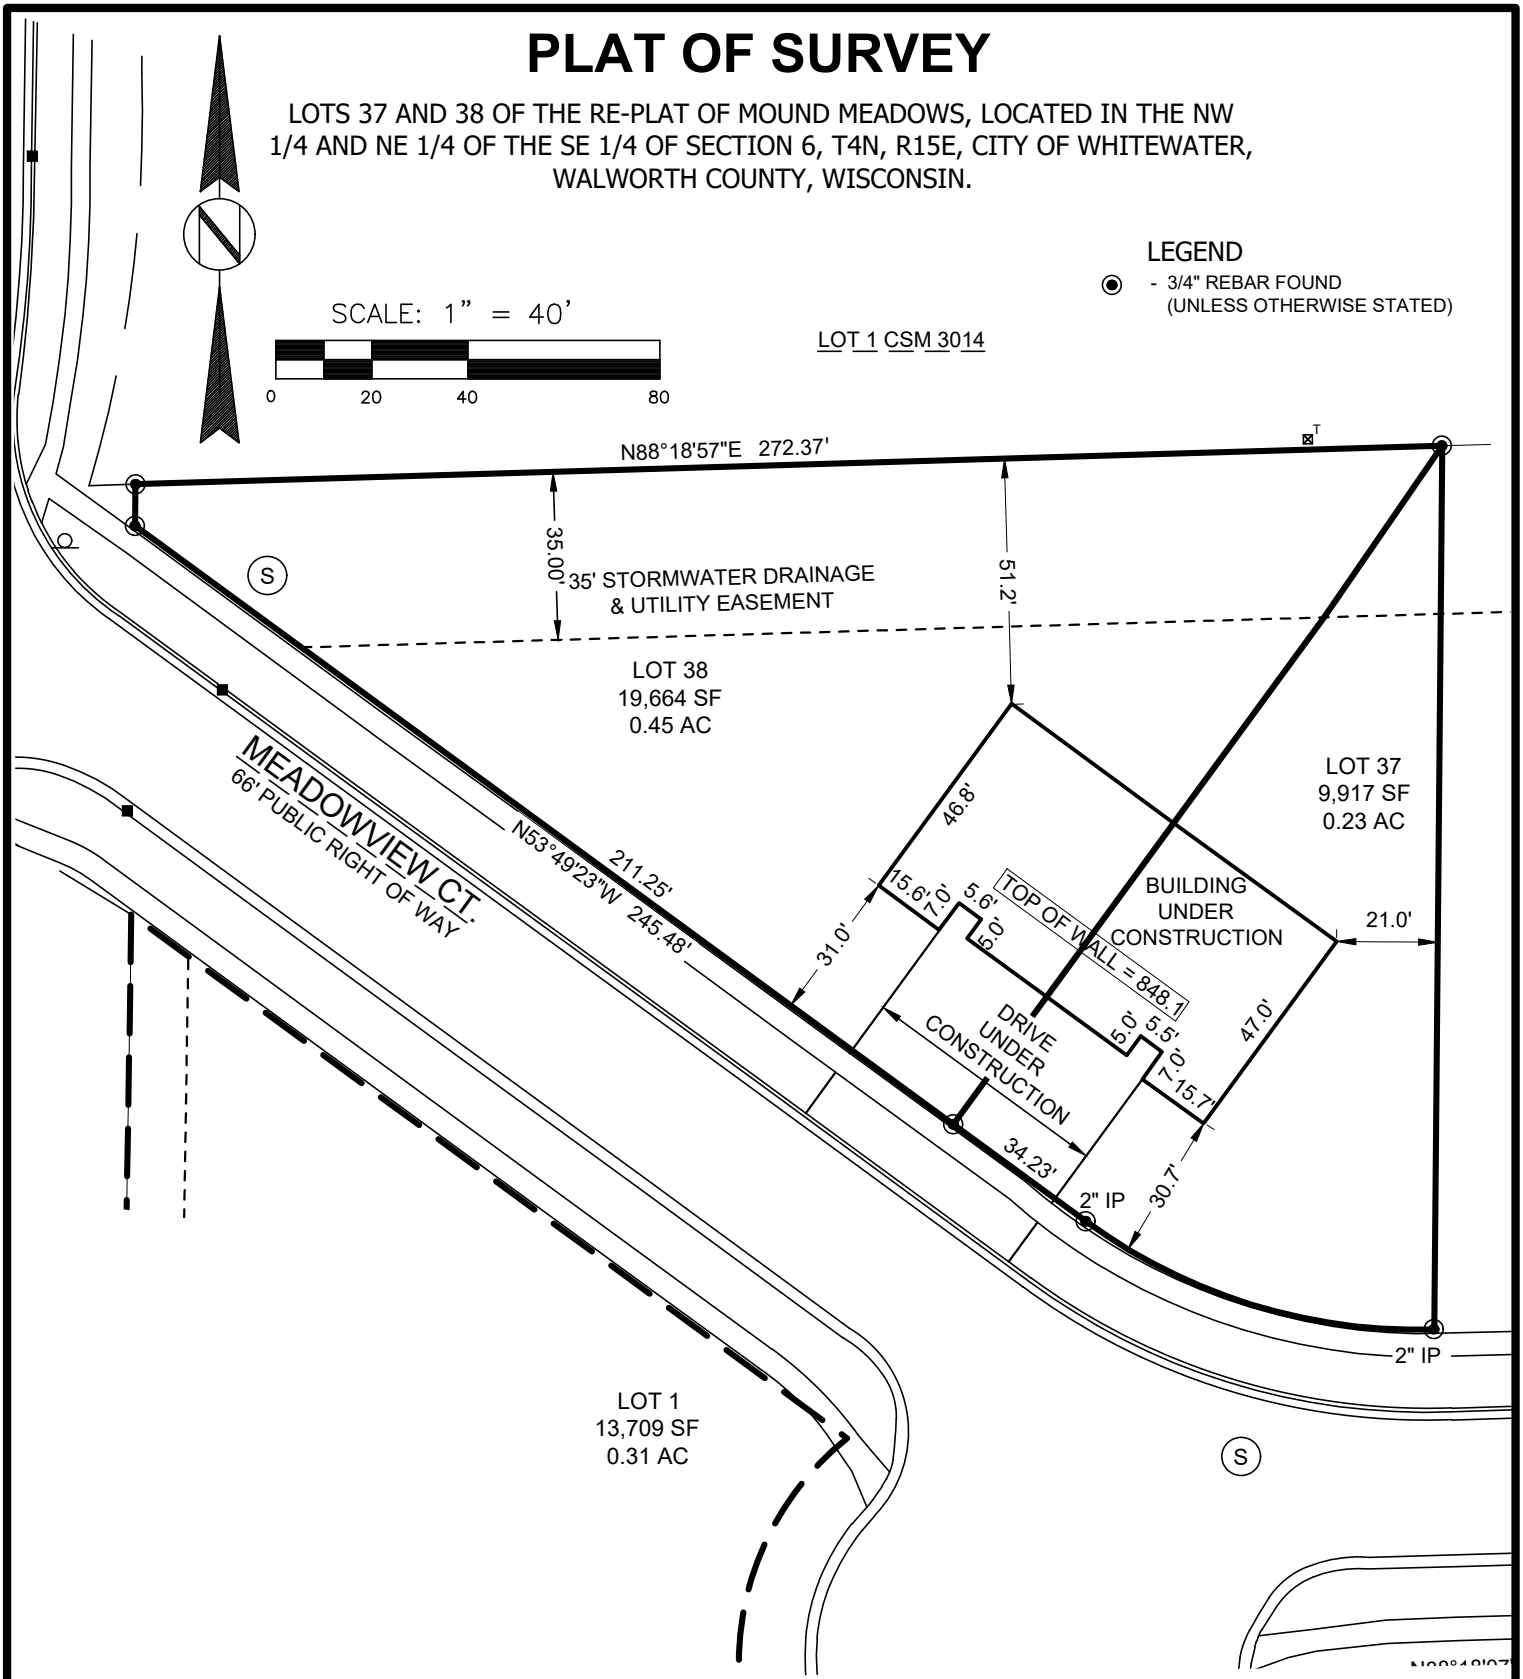

DATED THIS 29TH DAY OF APRIL, 2024.

SURVEYOR'S CERTIFICATE

I HEREBY CERTIFY THAT I HAVE SURVEYED THE ABOVE DESCRIBED PROPERTY AND THAT THE ABOVE MAP IS A TRUE REPRESENTATION THEREOF AND SHOWS THE SIZE AND LOCATION OF THE PROPERTY, ITS EXTERIOR BOUNDARIES, THE LOCATION OF ALL VISIBLE STRUCTURES AND DIMENSIONS OF ALL PRINCIPAL BUILDINGS THEREON, BOUNDARY FENCES, APPARENT EASEMENTS, ROADWAYS, AND VISIBLE ENCROACHMENTS, IF ANY. THIS SURVEY IS MADE FOR THE USE OF THE PRESENT OWNERS OF THE PROPERTY, AND ALSO THOSE WHO PURCHASE, MORTGAGE, OR GUARANTEE THE TITLE THERETO WITHIN ONE (1) YEAR FROM DATE HEREOF.

SEH

SEH PROJECT: USSHE 175452

PATH: X:\UZ\U\USSHE\175452\9-SURVEY\92-CAD\10-C3D\USSHE 175452 BSO BLD 1_BLD 2.DWG