
PLAT OF SURVEY

Lots 12, 13, and 14, Block 8, in S.C. Hall's Addition to the Village of Whitewater, as City of Whitewater, being part of the Northwest 1/4 and Southwest 1/4 of the Southwest 1/4 of Section 3, Township 4 North, Range 15 East, in the City of Whitewater, Walworth County, Wisconsin.

Together with the South 1/2 of Vacated Alley, as vacated and described in Volume 556 of Records, Page 15, as Document No. 227880.
Excepting therefrom portion set forth in the Warranty Deed, dated July 6, 1987 and recorded July 13, 1987 in Volume 406 of Records, Page 921, as Document No. 149926.

Prepared for: Tanis Construction
Survey No: 169891-KAC

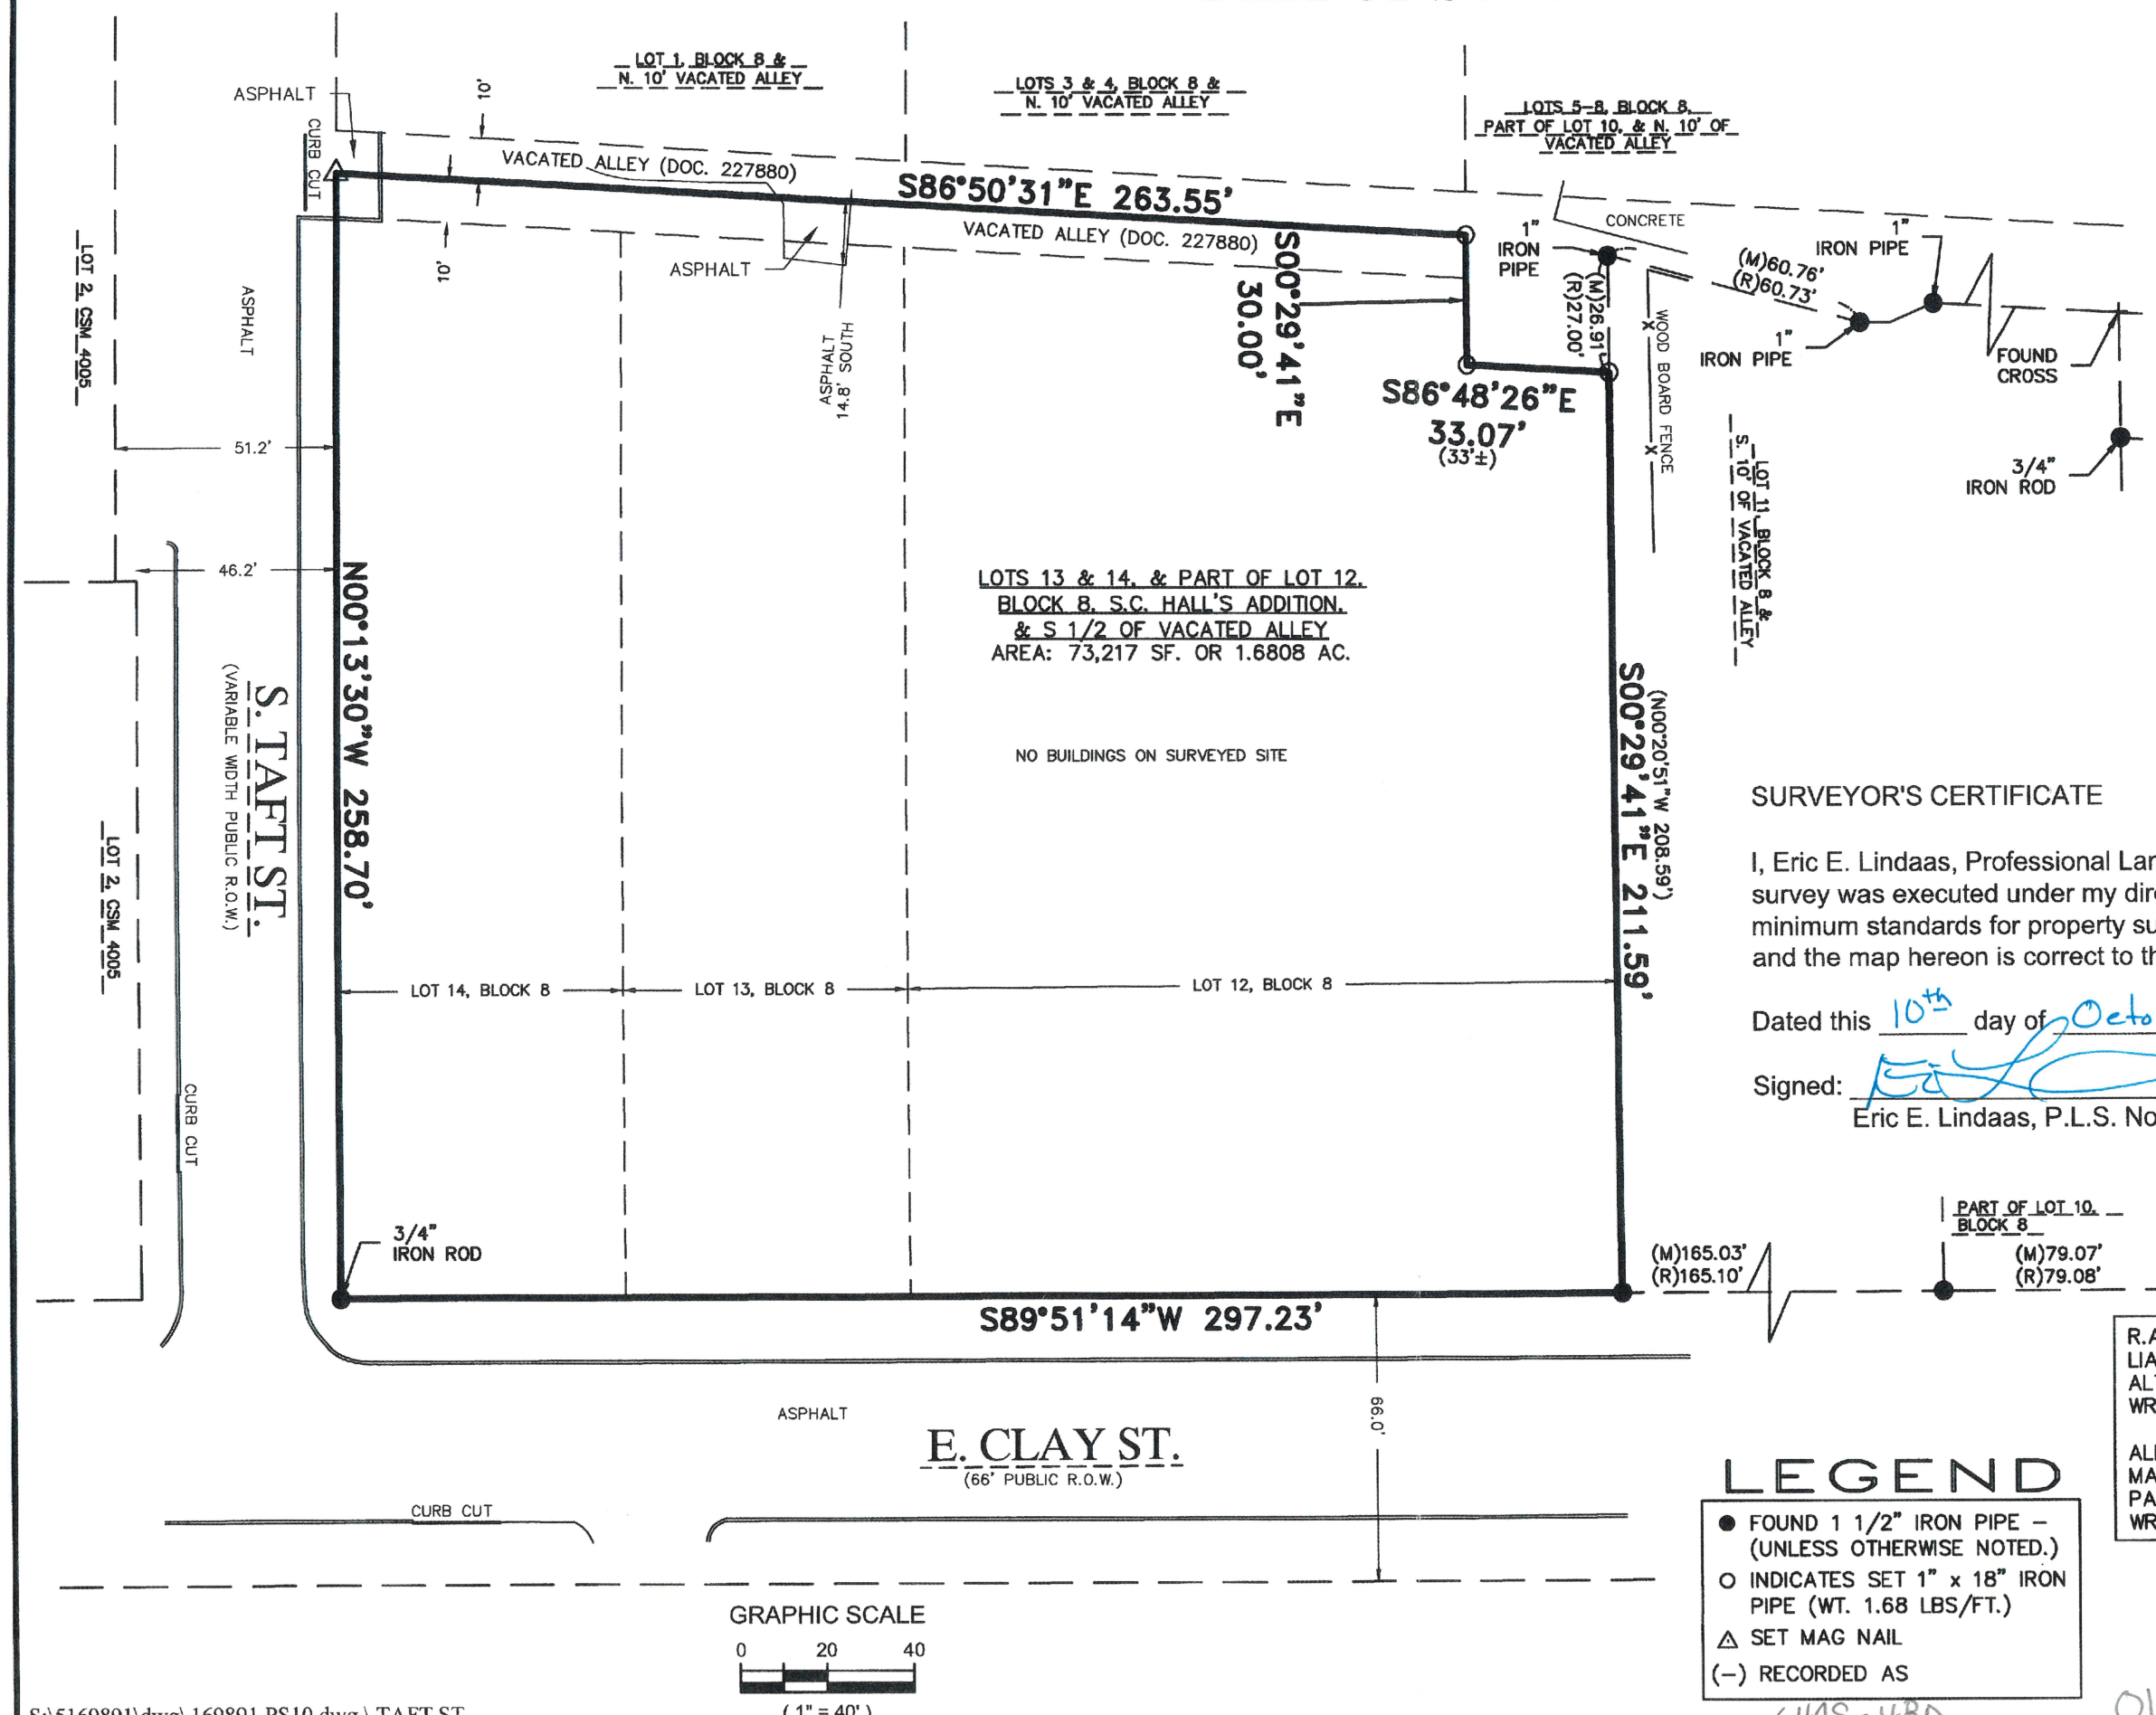

SURVEYOR'S CERTIFICATE

I, Eric E. Lindaas, Professional Land Surveyor, hereby certify that the foregoing survey was executed under my direction and control and that said survey meets the minimum standards for property surveys of the Wisconsin Administrative Code (A-E7) and the map hereon is correct to the best of my knowledge and belief.

Dated this 10th day of October, 2025.

Signed: _____
Eric E. Lindaas, P.L.S. No. 2919

WISCONSIN
ERIC E LINDAAS S-2919 McFARLAND WI
LAND SURVEYOR

LEGEND

- ● FOUND 1 1/2" IRON PIPE – (UNLESS OTHERWISE NOTED.)
- O INDICATES SET 1" x 18" IRON PIPE (WT. 1.68 LBS/FT.)
- △ SET MAG NAIL
- (–) RECORDED AS

R.A.SMITH, INC. ASSUMES NO RESPONSIBILITY FOR DAMAGES, LIABILITY OR COSTS RESULTING FROM CHANGES OR ALTERATIONS MADE TO THIS PLAN WITHOUT THE EXPRESSED WRITTEN CONSENT OF R.A.SMITH, INC.

ALL COPYRIGHTS TO THESE DRAWINGS ARE RESERVED. THEY MAY NOT BE COPIED, CHANGED, OR ASSIGNED TO ANY THIRD PARTY IN ANY MANNER WITHOUT OBTAINING THE EXPRESSED WRITTEN PERMISSION OF R.A.SMITH, INC.

raSmith
CREATIVITY BEYOND ENGINEERING
16745 W. Bluemound Road
Brookfield, WI 53005-5938
(262) 781-1000
rasmith.com

S:\5169891\dwg\ 169891 PS10.dwg \ TAFT ST

HAS-480

010-1194