CERTIFIED SURVEY # 29

CERTIFIED SURVEY OF

Lot 7, Block 1 of Dann's Addition, City of Whitewater and described as follows; towit: Commencing at the North ¼ corner of Section 4, T 4 N, R 15 E, City of Whitewater, Walworth County, Wisconsin; thence S 3°56' E 2750.01 feet; thence N 84°42' E, 291.06 feet; thence N 4°07' W, 498.58 feet to a concrete monument; thence S 87°12' E, 396.00 feet to a cross cut in concrete; thence S 3°58' W, 60.07 feet to a cross cut in concrete and the place of beginning; thence continue S 3°58' W, 211.20 feet to a cross cut in concrete; thence N 87°12' W, 66.00 feet to an iron pipe; thence N 3°58' E, 211.20 feet to an iron pipe; thence S 87°12' E, 66.00 feet to the place of beginning.

LEGEND

- ø Iron Pipe found
- o Iron Pipe placed 1"x24" Min. Wt. 1.13 lb. per lineal ft.
- ● Concrete Monument found

OWNER: Clarence Wagen

SCALE: 1" = 60'

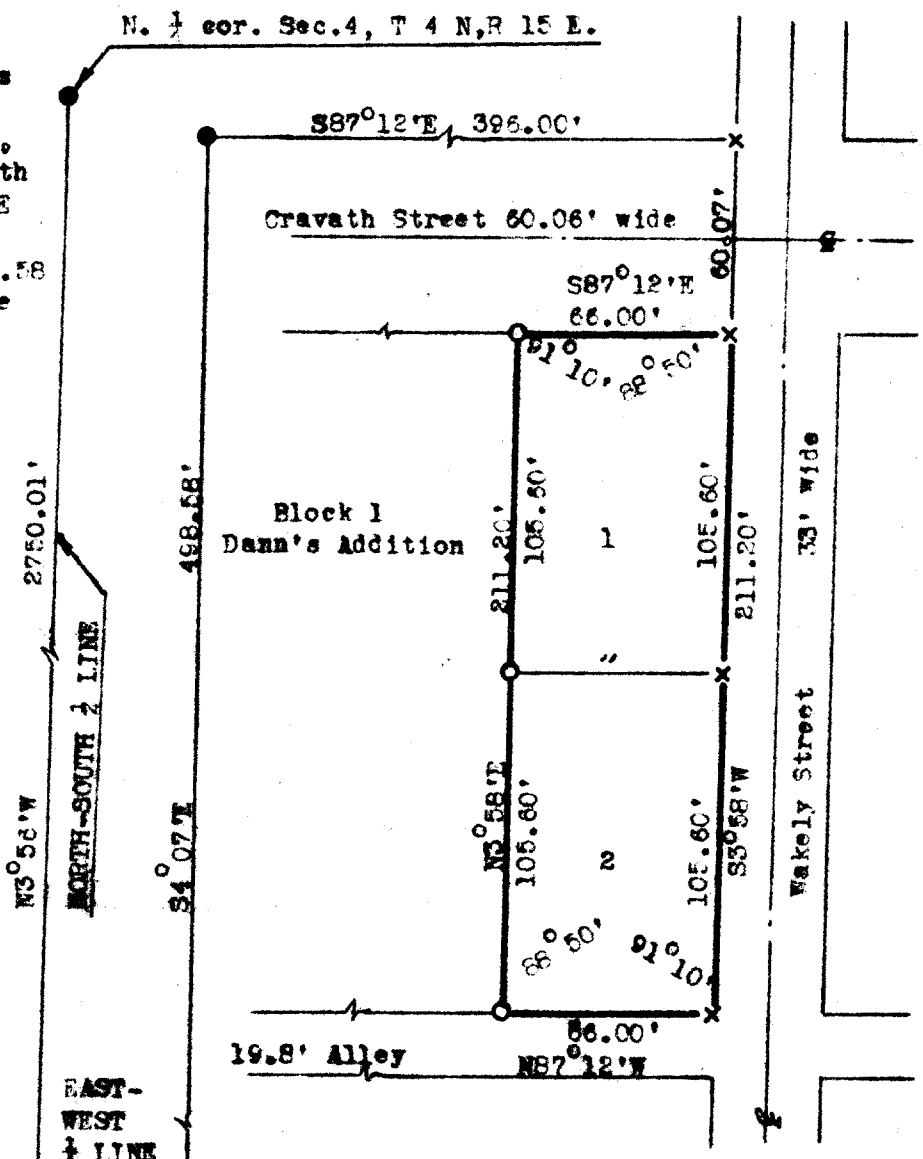

N

I, Harold W. Kolb, do hereby certify that I have Surveyed the property hereon described according to the official records, and that the plat hereon is a correct representation of the lot lines, and that I have fully complied with Chapter 236.34 of the Wisconsin Statutes.

Harold W. Kolb

Harold W. Kolb, Wisconsin Surveyor, S-187

Date: October 10, 1967

Lake Geneva, Wisconsin

Revised Nov. 22, 1967 to correct Certified Survey #28.

Cert Survey #29

10-124