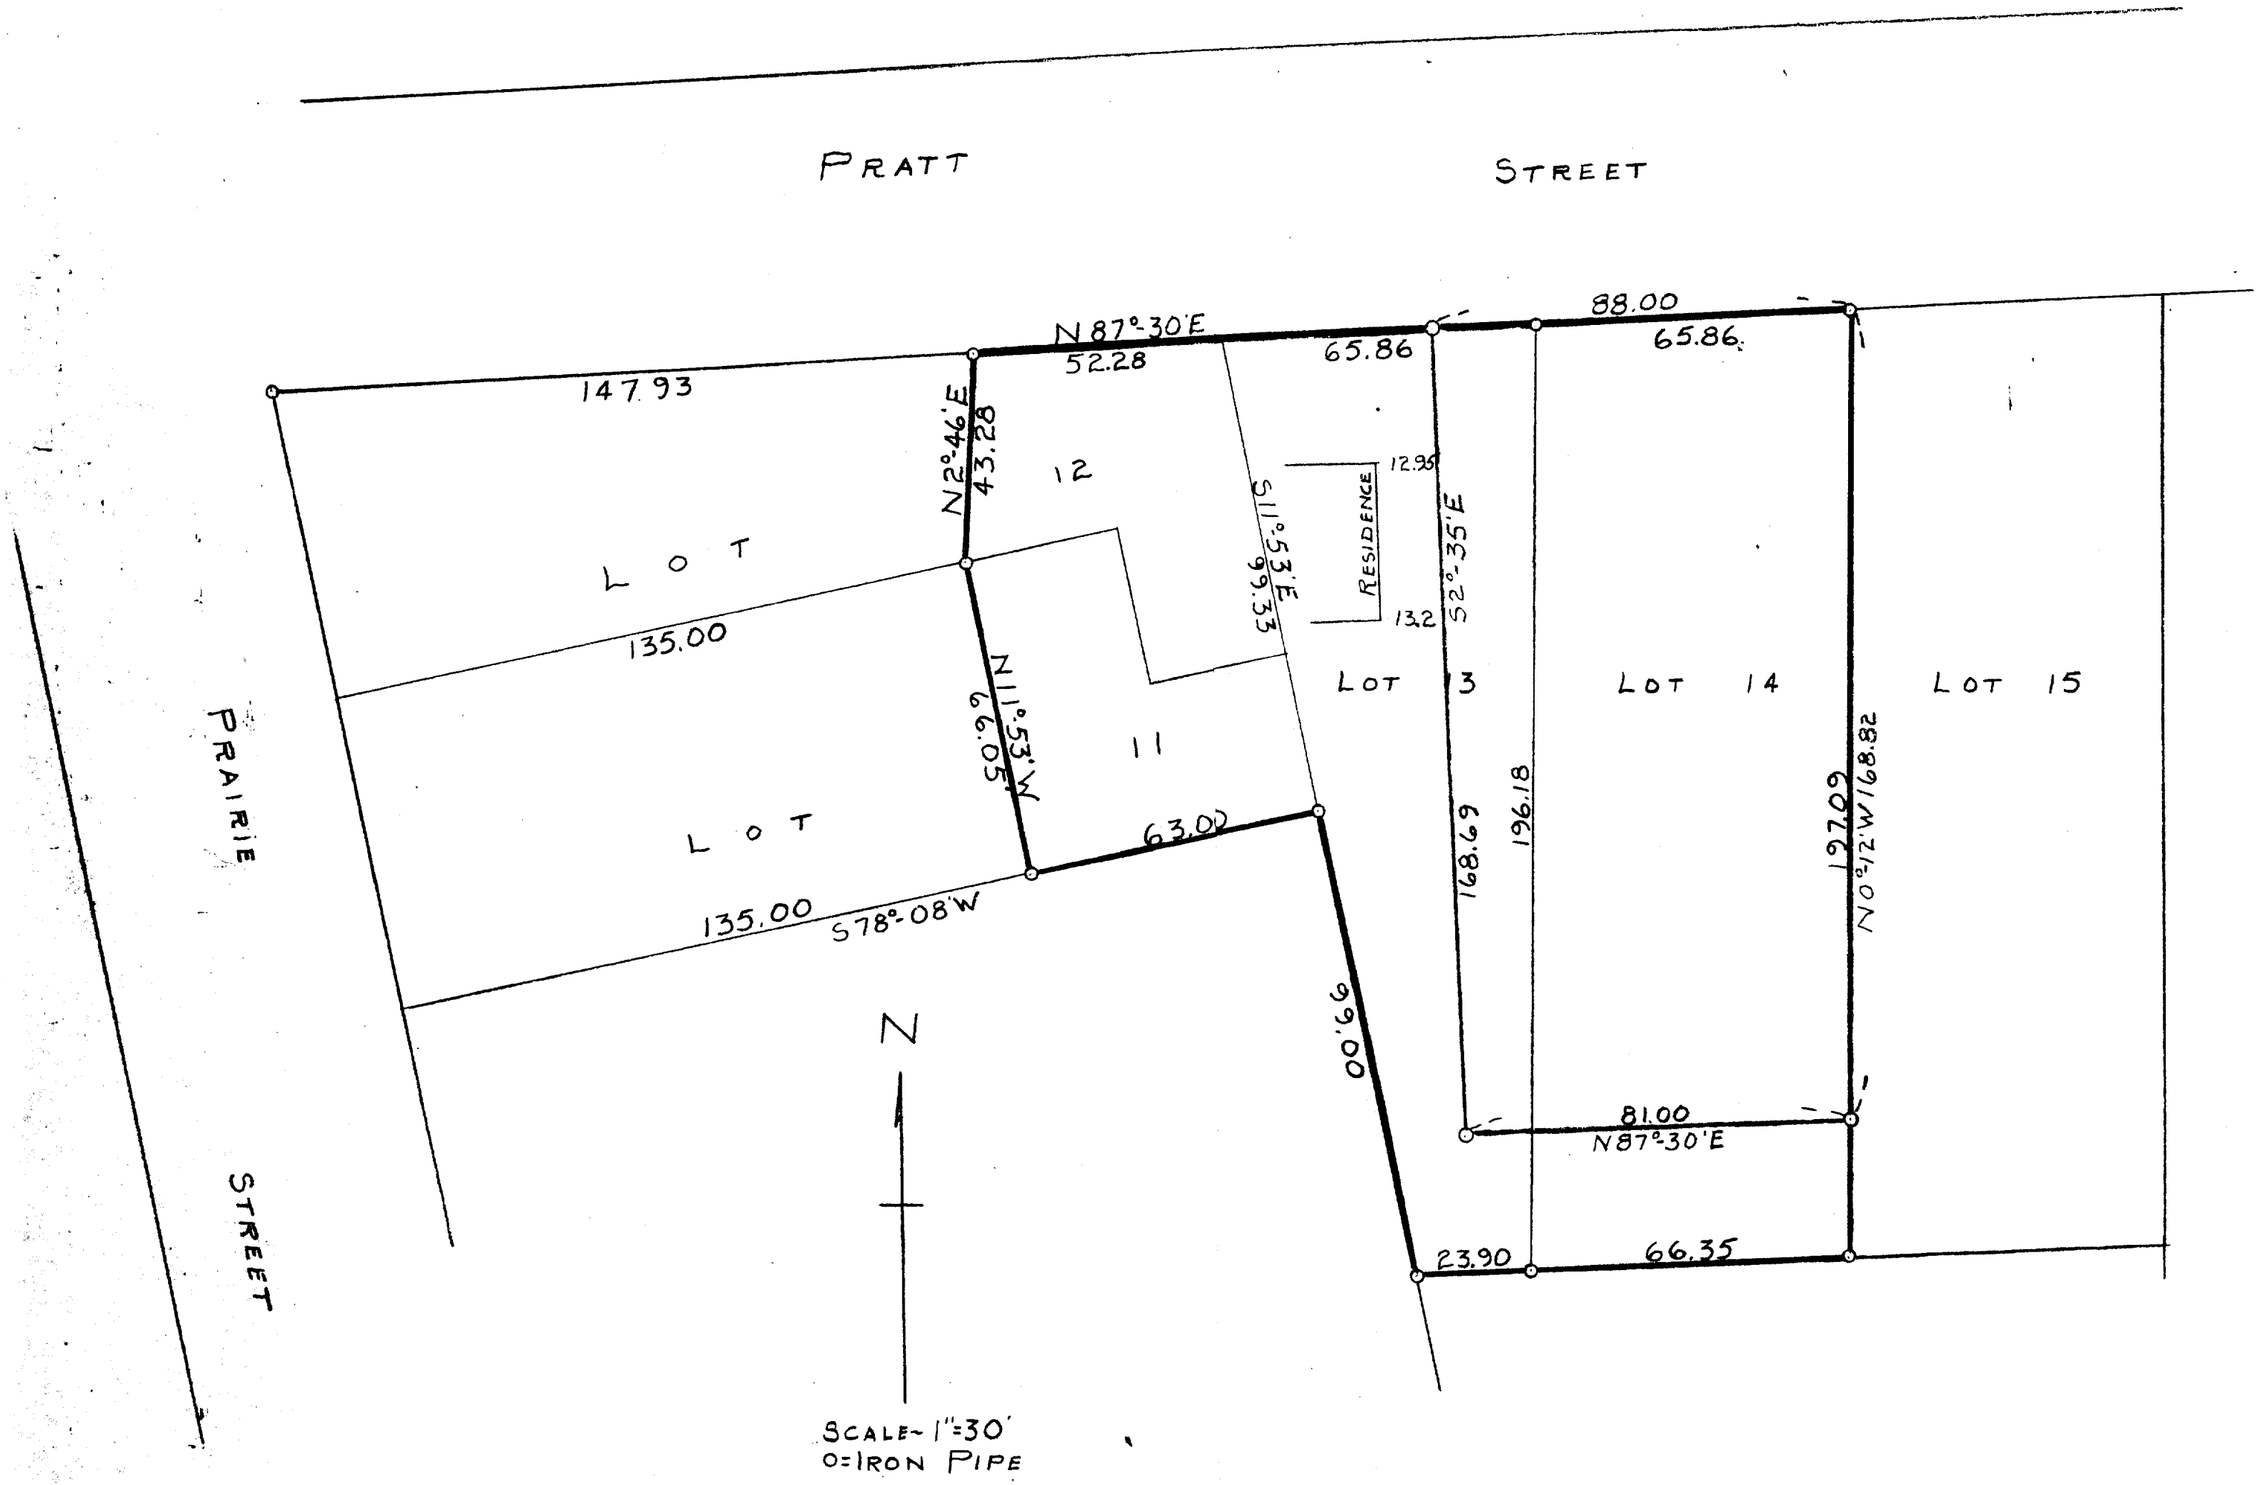

PLAT OF SURVEY OF PART OF LOTS 11 AND 12, LOT 13 AND LOT 14 OF BULKLEY AND TRATTS ADDITION, CITY OF WHITEWATER, WALWORTH COUNTY, WISCONSIN.
OCT. 1955
REVISED MAY 9, 1958

George T. Dunham
GEORGE T. DUNHAM, SURVEYOR
DELAVAN, WISCONSIN

10-15

BUL-12B