WATERMAN, FUGE & ASSOCIATES, INC.

ARCHITECTS - ENGINEERS - SURVEYORS

FORT ATKINSON, WISCONSIN


Client– Fred Kraege

Address– 529 S. Gault St., Whitewater, Wis.

WHITEWATER, City of

Sec. 8 T 4N R 15E

Description– Lots 14, 15, 16, Blk. 2, Caines Addition, being part of the N. W. 1/4 of Section 8, T4N, R15E, City of Whitewater, Wisconsin

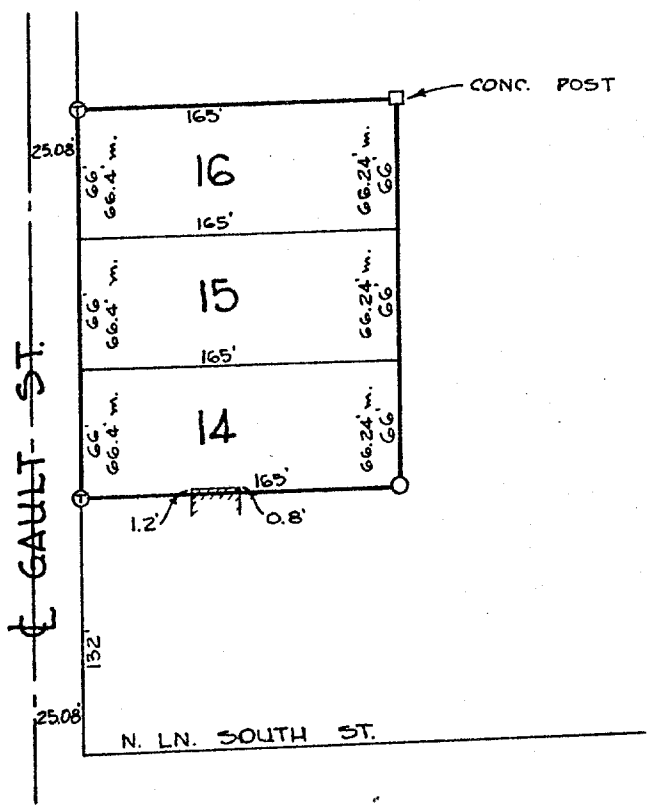

WISCONSIN
PAUL E. MEVES
MILWAUKEE, WISCONSIN
LAND SURVEYOR

Scale of Map: 1 inch= 100 feet.

LEGEND

—○— Iron Pipes Found —X—X—X—X— Fences

—●— Iron Pipes Set —Ⓣ— T-Bar Stake Set

—•— Reference Points

STATE OF WISCONSIN } SS.
COUNTY OF JEFFERSON }

I, Paul E. Meves a registered surveyor of the State of Wisconsin, do hereby certify that on June 5, 1961 I surveyed the above described property according to official records and that the accompanying map is a correctly dimensioned representation to the scale of the boundaries, that all buildings and improvements lie wholly within the boundary lines, and that ■ encroachments by adjacent property owners appear from said survey.

Paul E. Meves

SIGNATURE

Field Book XXVII Page 6658

Map No. 983

10-204-W