WATERMAN, FUGE & ASSOCIATES, INC.

ARCHITECTS - ENGINEERS - SURVEYORS

FORT ATKINSON, WISCONSIN

Walworth County
Whitewater, City of


Client– Mr. Spencer Findlay

Address– Milwaukee St., Whitewater, Wis.

Sec. 4 **T** 4 N **R** 15 E

Description–

Lot 1, Block 1, Esterley's addition to the City of Whitewater, Wisconsin.

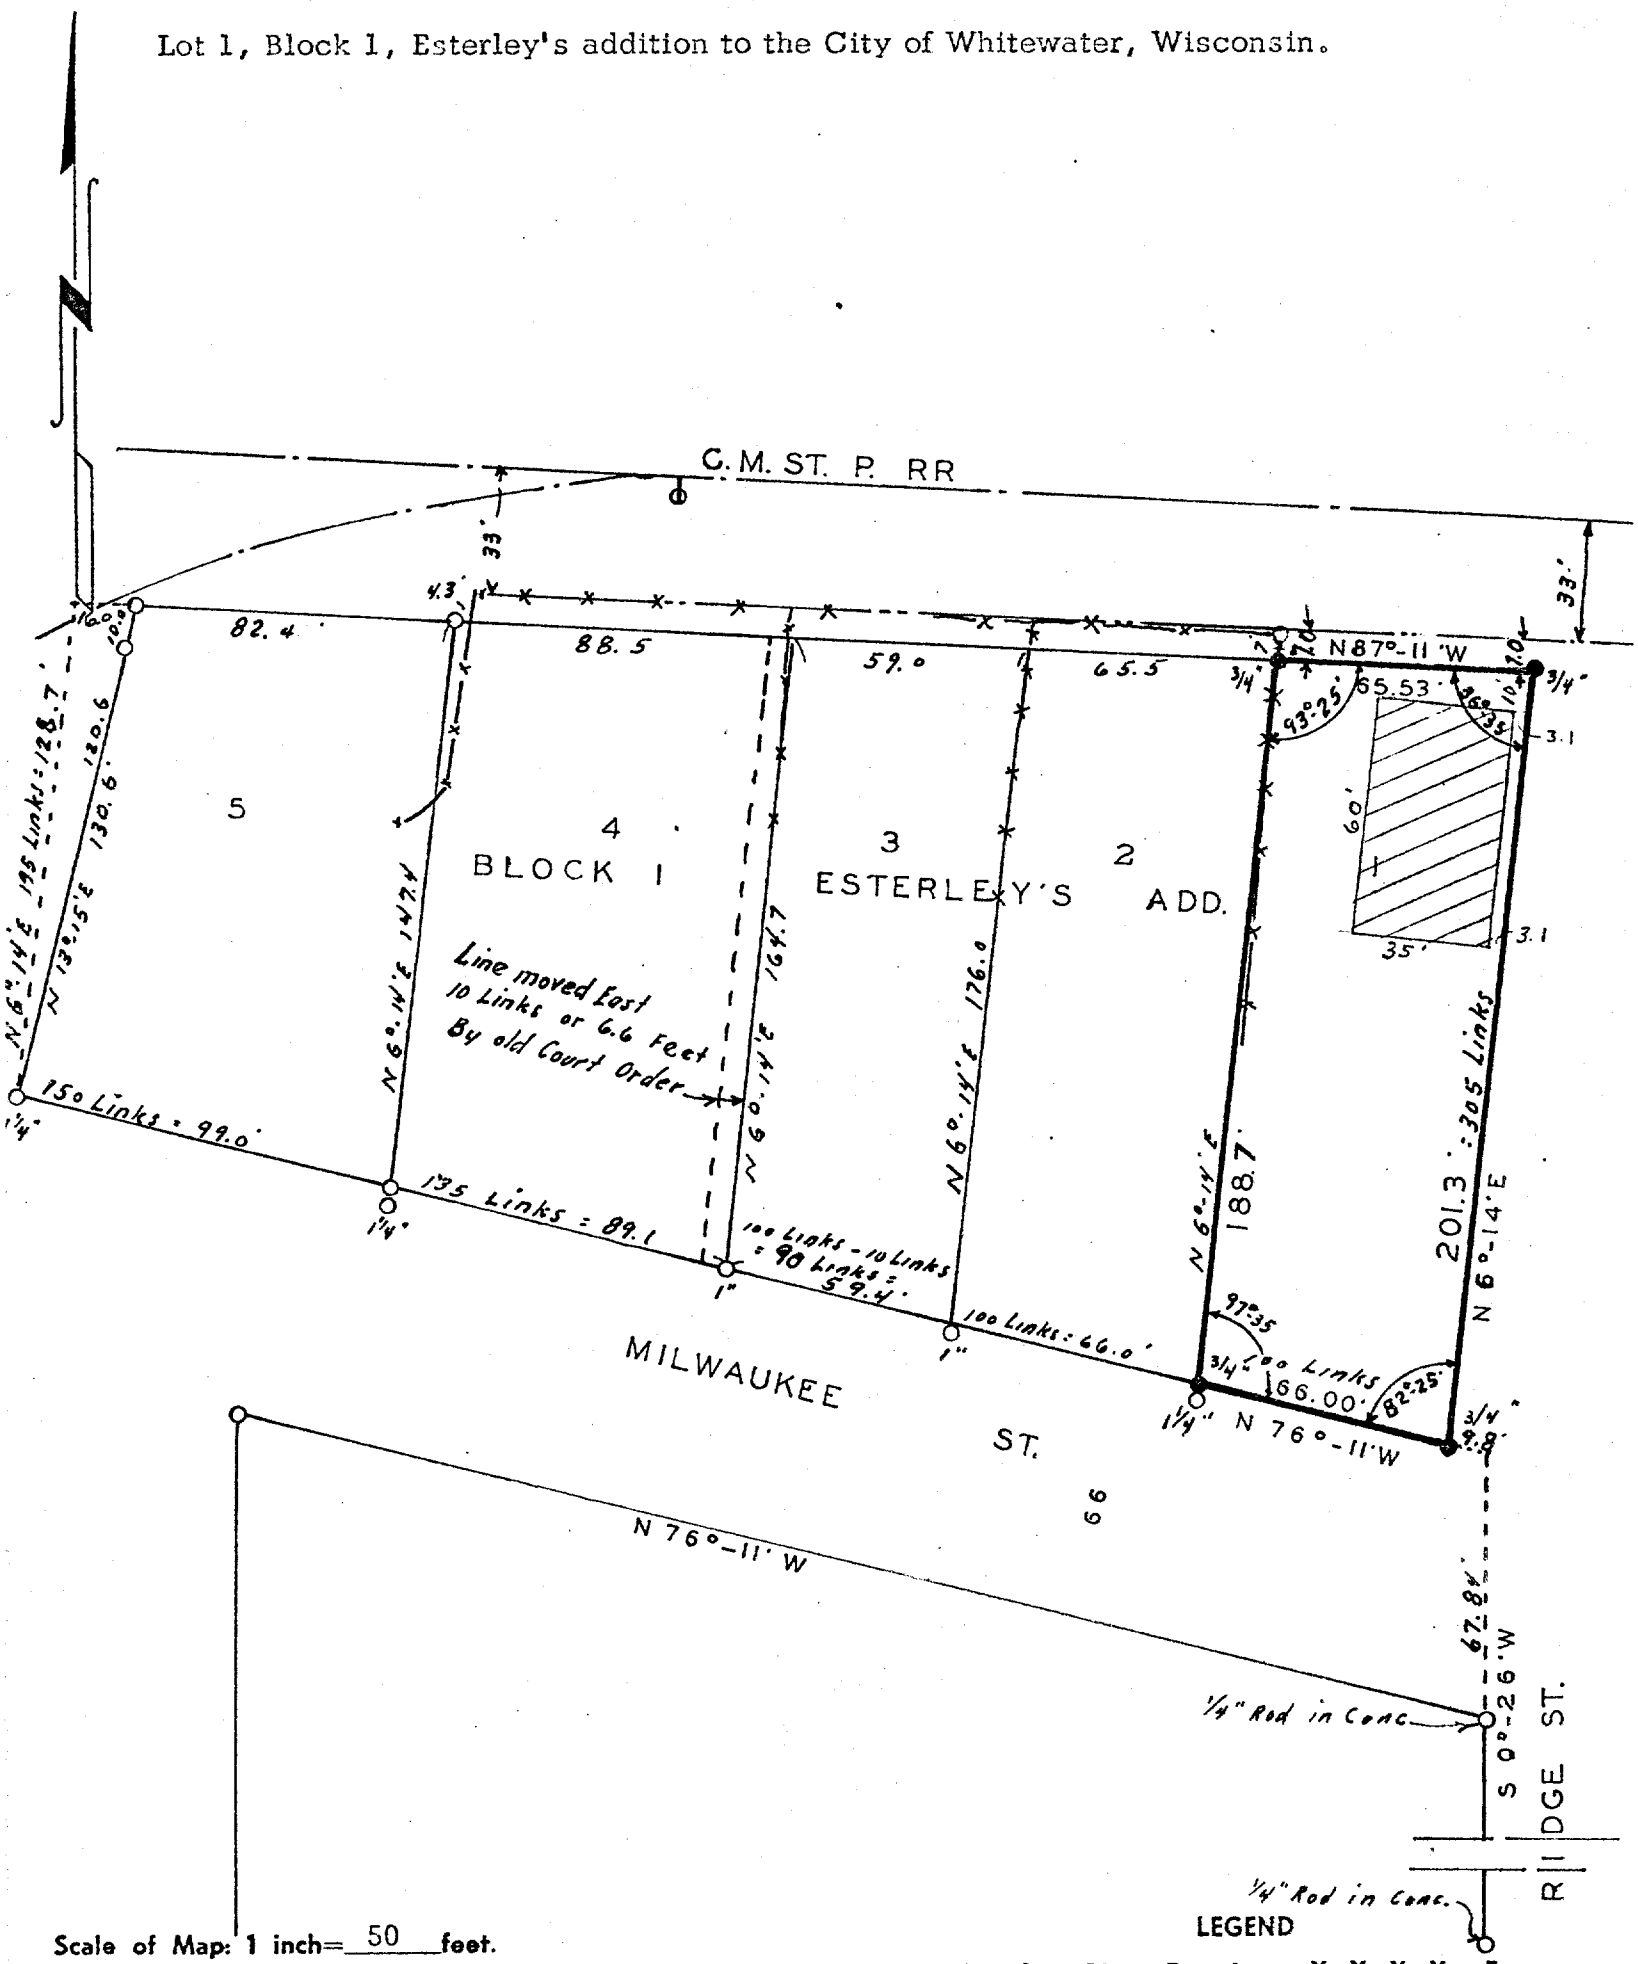

Scale of Map: 1 inch= 50 **feet.**

LEGEND

- —○— Iron Pipes Found
- —X—X—X—X— Fences
- 3/4" —●— Iron Pipes Set
- —Ⓣ— T-Bar Stake Set
- —•— Reference Points

STATE OF WISCONSIN } SS.
COUNTY OF JEFFERSON }

I, David C. Knoerr a registered surveyor of the State of Wisconsin, do hereby certify that on 3-26-59 I surveyed the above described property according to official records and that the accompanying map is a correctly dimensioned representation to the scale of the boundaries, that all buildings and improvements lie wholly within the boundary lines, and that no encroachments by adjacent property owners appear from said survey.

David C. Knoerr
SIGNATURE

Field Book XX Page 5031

Map No. 805
10-205-W