WATERMAN, FUGE & ASSOCIATES, INC.

ARCHITECTS - ENGINEERS - SURVEYORS

FORT ATKINSON, WISCONSIN


Walworth Co.
Whitewater, City of
S.C.Hall's Addition
Sec. 3 T 4N R 15 E
S W 1/4

Client–Mr. Glen Durfey

Address– 712 E. Main Street, Whitewater, Wis.

Description–

Lot 2, Block 1 of S. C. Hall's Addition to Whitewater, Wis. Walworth Co.

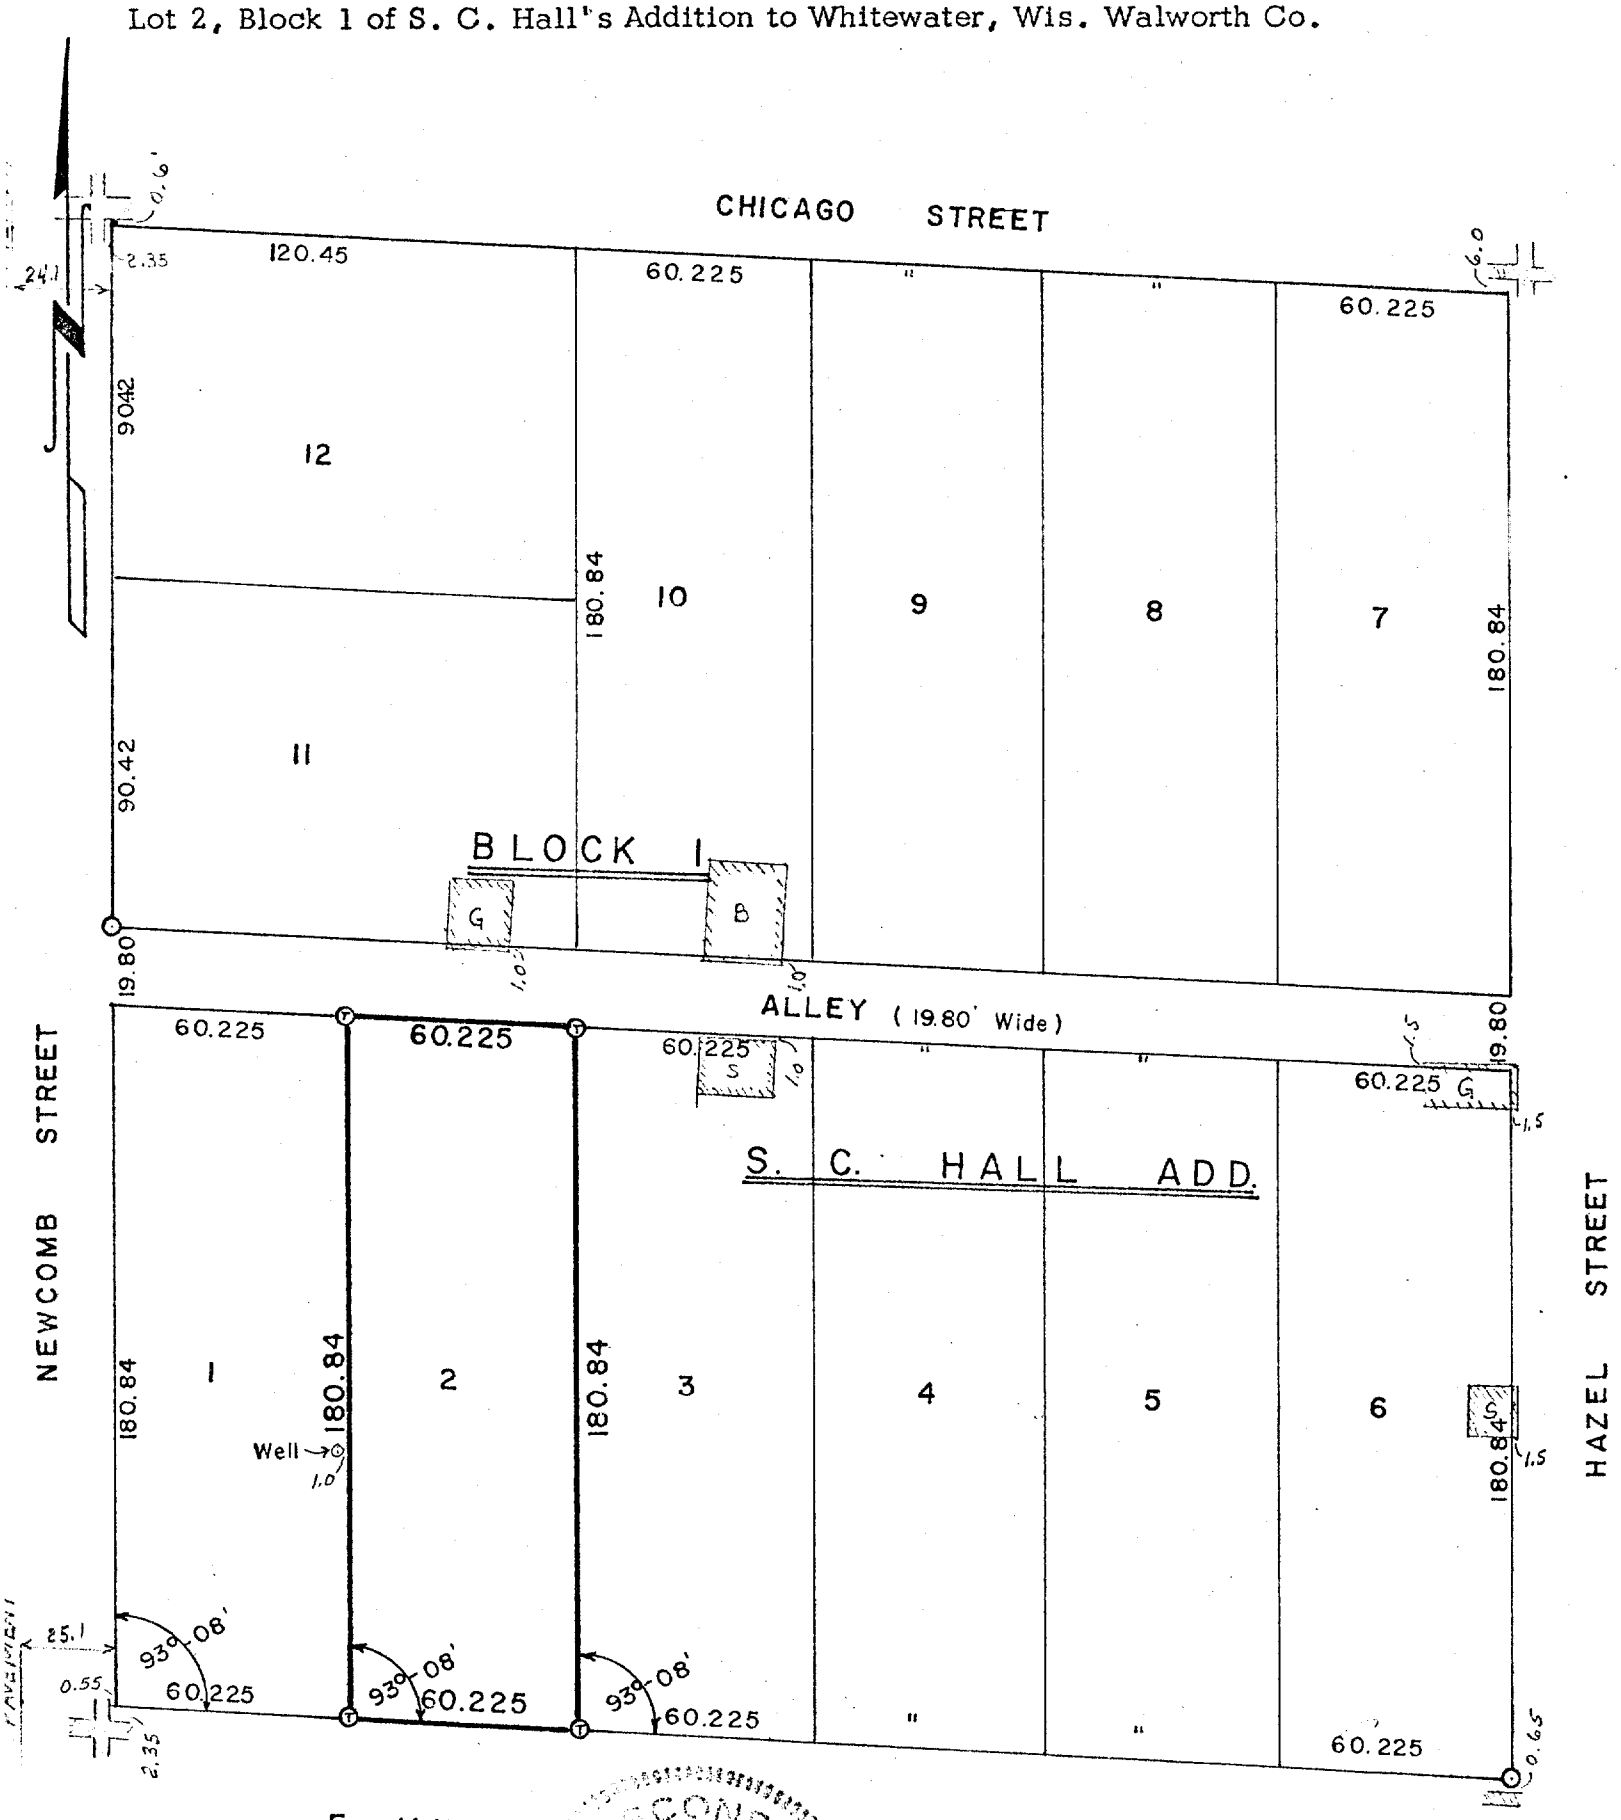

Scale of Map: 1 inch= 50 feet.

LEGEND

—○— Iron Pipes Found —X—X—X—X— Fences
—●— Iron Pipes Set —Ⓣ— T-Bar Stake Set
—•— Reference Points

STATE OF WISCONSIN } SS.
COUNTY OF JEFFERSON }

I, D. C. Knoerr a registered surveyor of the State of Wisconsin, do hereby certify that on 4-13-60 I surveyed the above described property according to official records and that the accompanying map is a correctly dimensioned representation to the scale of the boundaries, that all buildings and improvements lie wholly within the boundary lines, and that no encroachments by adjacent property owners appear from said survey.

10-207-W

David C. Knoerr
SIGNATURE

MEMBER
WISCONSIN SOCIETY OF LAND SURVEYORS
AFFILIATED WITH
AMERICAN CONGRESS OF SURVEYING AND MAPPING

HA 5-2

Field Book XXIV Page 5921 Map No. 909