WATERMAN, FUGE & ASSOCIATES, INC.

ARCHITECTS - ENGINEERS - SURVEYORS

FORT ATKINSON, WISCONSIN


Client– Mr. Henry A. DeWind

Address– 152 S. Franklin, Whitewater, Wisconsin

Whitewater, city of
Walworth Co.

Sec. 5 **T** 4 N. **R** 15 E.

Description– The North 10 feet of Lot 19, all of Lot 20 and the South 44 feet of Lot 21, all in Block 1 of Fish and Johnson's Addition to the City of Whitewater, also a strip of land 120 feet North and South and three and one half rods East and West situated immediately East and adjacent to the above described lands.

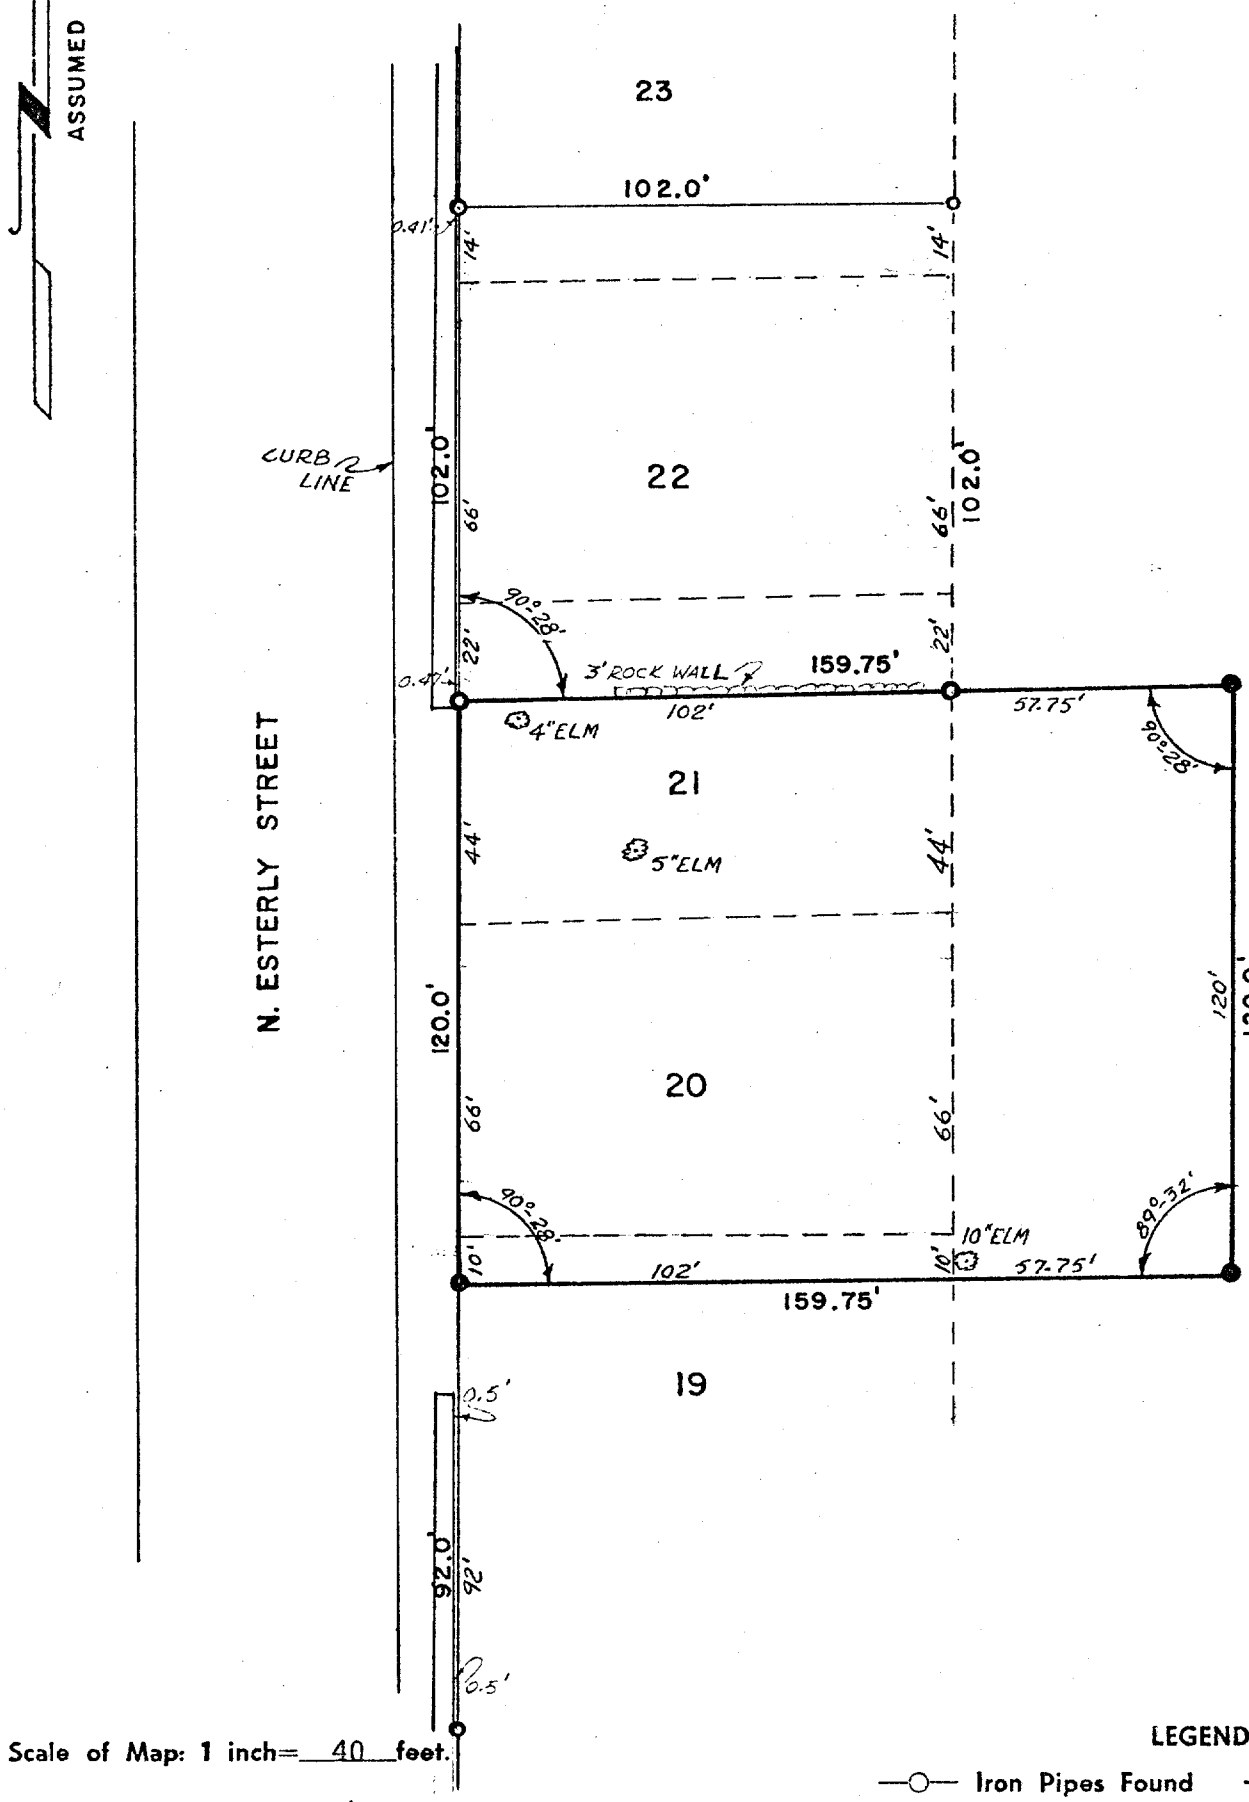

Scale of Map: 1 inch= 40 feet.

LEGEND

—○— Iron Pipes Found —X—X—X—X— Fences
—●— Iron Pipes Set —Ⓣ— T-Bar Stake Set
—•— Reference Points

STATE OF WISCONSIN } SS.
COUNTY OF JEFFERSON }

I, Karl W. Fuge a registered surveyor of the State of Wisconsin, do hereby certify that on 8-20-58 I surveyed the above described property according to official records and that the accompanying map is a correctly dimensioned representation to the scale of the boundaries, that all buildings and improvements lie wholly within the boundary lines, and that no encroachments by adjacent property owners appear from said survey.

Lots 19 & 20 + UP-100 C

Karl W. Fuge
SIGNATURE

Field Book XIX Page 4749

10-2 10 W
Map No. XXX 771