WATERMAN, FUGE & ASSOCIATES, INC.

ARCHITECTS - ENGINEERS - SURVEYORS


FORT ATKINSON, WISCONSIN

Whitewater, City of
Lawndale Addition
Lots 11 & 12
Sec._____ T_____ R_____

Client– Creeko Oil Co.

Address– Johnson Creek, Wis.

Description– A 18,400 square foot parcel in the City of Whitewater, County of Walworth, State of Wisconsin, described from an actual field survey by Karl W. Fuge, September 14, 1960, as follows: All of lots 11 and 12 in Lawndale Addition to said City of Whitewater.

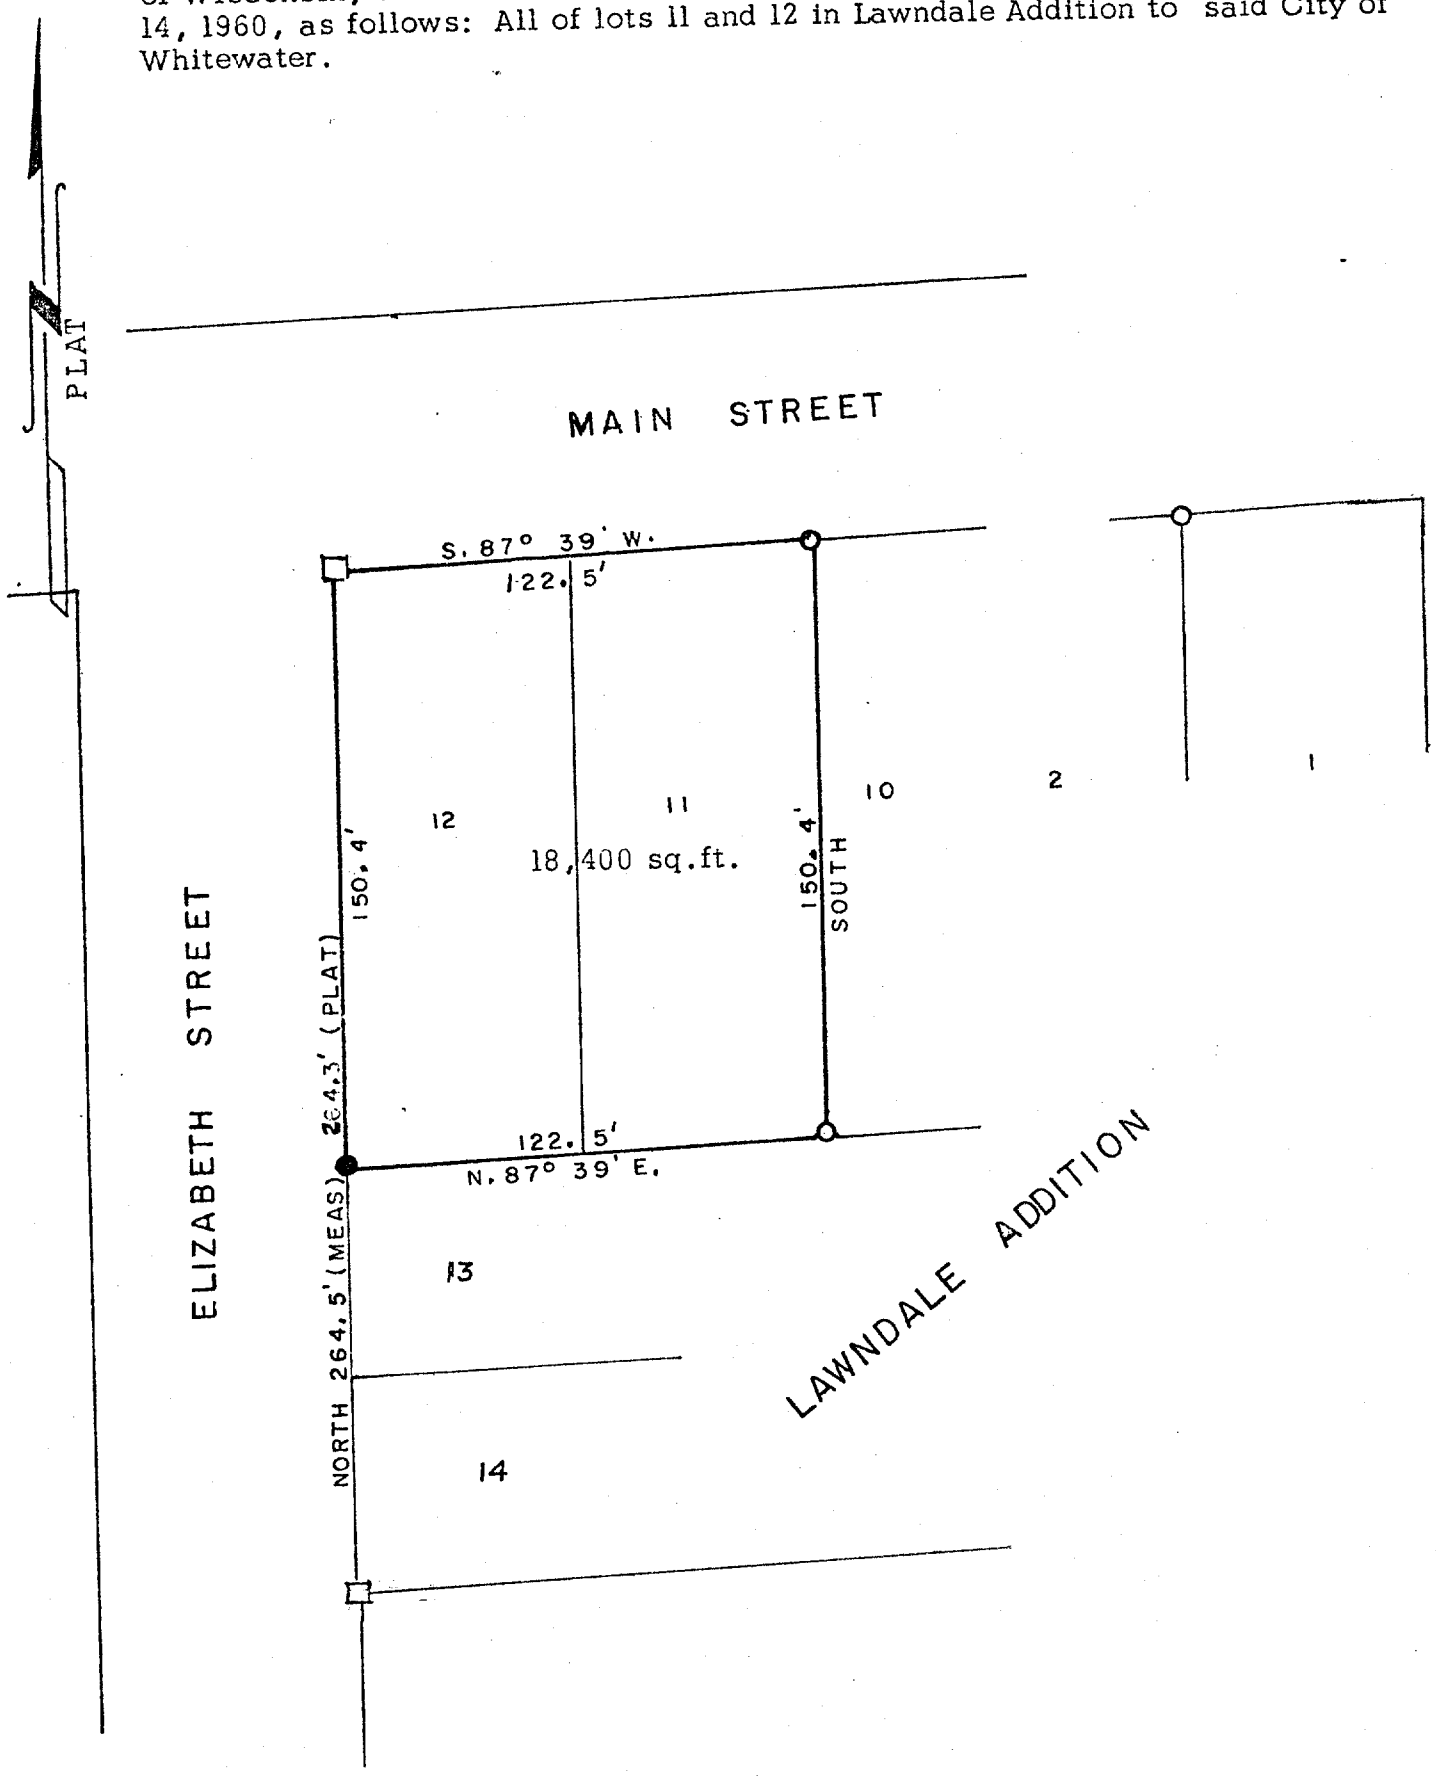

Scale of Map: 1 inch= 50' feet.

LEGEND

—○— Iron Pipes Found —X—X—X—X— Fences
—●— Iron Pipes Set —Ⓣ— T-Bar Stake Set
—•— Reference Points —□— Concrete Mon. found.

STATE OF WISCONSIN } SS.
COUNTY OF JEFFERSON }

I, Karl W. Fuge a registered surveyor of the State of Wisconsin, do hereby certify that on 9-14-60 I surveyed the above described property according to official records and that the accompanying map is a correctly dimensioned representation to the scale of the boundaries, that all buildings and improvements lie wholly within the boundary lines, and that no encroachments by adjacent property owners appear from said survey.

Karl W. Fuge
SIGNATURE

Field Book XXV Page 6209

Map No. 945
10-211-W