HAROLD H. KOLB

REGISTERED PROFESSIONAL LAND SURVEYOR
LAKE GENEVA, WISCONSIN

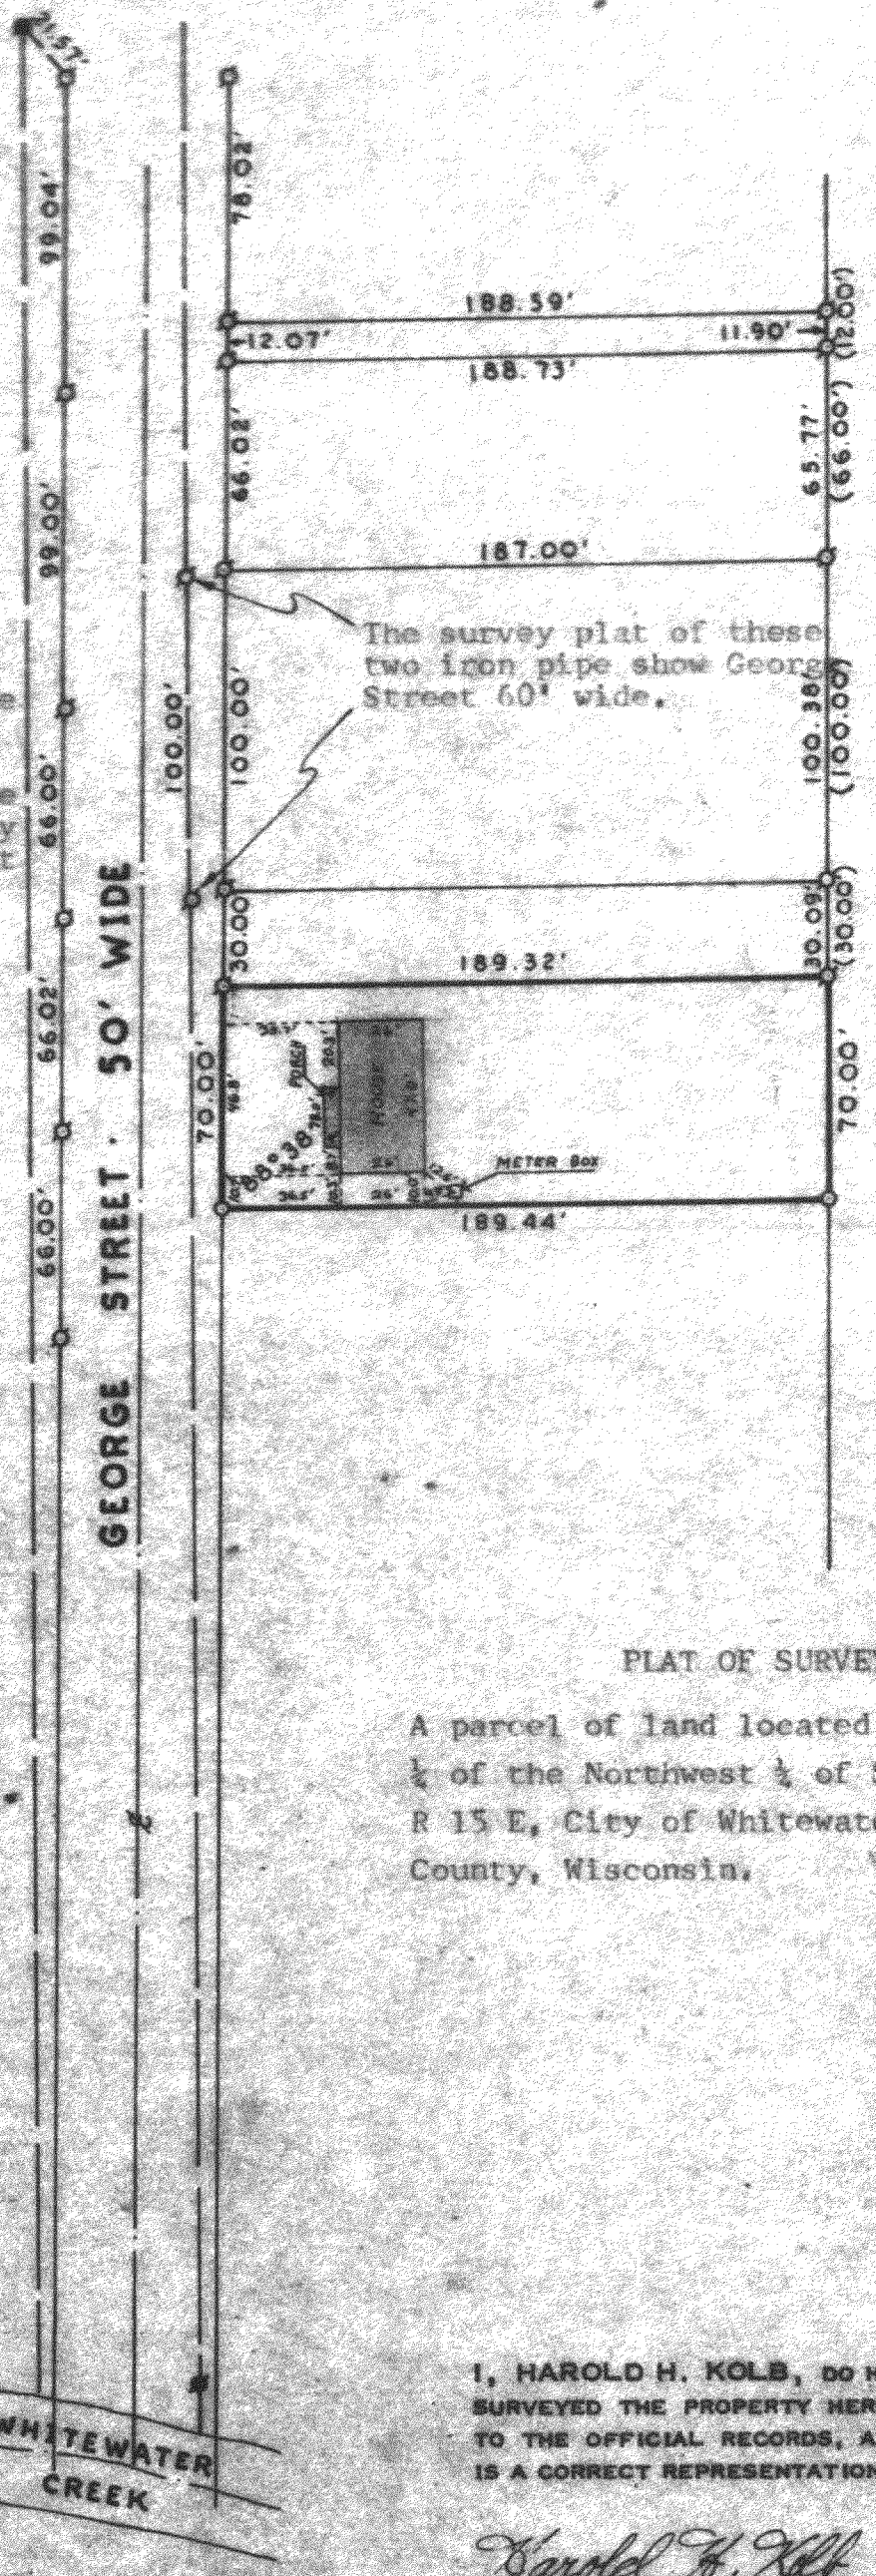

Note: We have found two locations for George Street staked in the field. We have used the location where we found the majority of stakes and those that appear to have been there the longest. City records and the original plat show George Street to be 50' wide.

The survey plat of these two iron pipe show George Street 60' wide.

WISCONSIN
HAROLD H. KOLB
S-187
LAKE GENEVA, WIS.
LAND SURVEYOR

N

SCALE: 1"=60'

LEGEND

- ⌀ — IRON PIPE FOUND
- O — IRON PIPE PLACED
- ▮ — CONCRETE MONUMENT FOUND
- ‡ — SPIKE
- ( ) — AS RECORDED

PLAT OF SURVEY OF

A parcel of land located in the Southeast ¼ of the Northwest ¼ of Section 4, T 4 N, R 15 E, City of Whitewater, Walworth County, Wisconsin.

I, HAROLD H. KOLB, DO HEREBY CERTIFY THAT I HAVE SURVEYED THE PROPERTY HEREON DESCRIBED ACCORDING TO THE OFFICIAL RECORDS, AND THAT THE PLAT HEREON IS A CORRECT REPRESENTATION OF THE LOT LINES.

Harold H. Kolb
HAROLD H. KOLB
WISCONSIN REGISTERED LAND SURVEYOR, S-187
DATE August 17, 1972

REVISED DATE: Feb. 16, 1973

10-220

WSS-61E, 61F, 61G (RVD)