WATERMAN, FUGE & ASSOCIATES, INC.

ARCHITECTS - ENGINEERS - SURVEYORS

FORT ATKINSON, WISCONSIN


Client— A. H. Mackie

Address— 251 George Street, Whitewater, Wis.

Whitewater, City of

Sec. 4 T 4N R 15E

Description— That part of the Southeast 1/4 of the Northwest 1/4 of Section 4, Town 4 North, Range 15 East, City of Whitewater, Walworth County, Wisconsin, as described in Deed Volume 570, Page 441 of said County, and more particularly described as follows: Commencing at a chisel mark in the concrete pavement indicating the West 1/4 corner of said Section 4; thence, N. 88° 38' E., along the South line of the Northwest 1/4 of said Section 4, 1527.74 feet to the centerline of George Street; thence N0°-00' E., along the centerline of George Street, and parallel to the West line of Jefferson Street, 878.00 feet to a point lying on an extension of the South line of this parcel; thence N. 88°-38' E., parallel to the South line of said Northwest 1/4, 30.00 feet to a 1 1/4" iron pipe on the East line of George Street, and the point of beginning of this description; thence continue N.88°-38' E., 198.55 feet to a 1 1/4" iron pipe on a line lying 626 feet West of the West line of Jefferson Street and parallel thereto; thence, N. 0°-00' E., along said line lying 626 feet West of the West line of Jefferson Street and parallel thereto, 100.00 feet to a 1 1/4" iron pipe; thence S. 88°-38' W., parallel to the South line of said Northwest 1/4 Section, 198.55 feet to a 1 1/4" iron pipe in the East line of George Street; thence S. 0°-00' W., along the East line of George Street, 100.00 feet to the point of beginning.

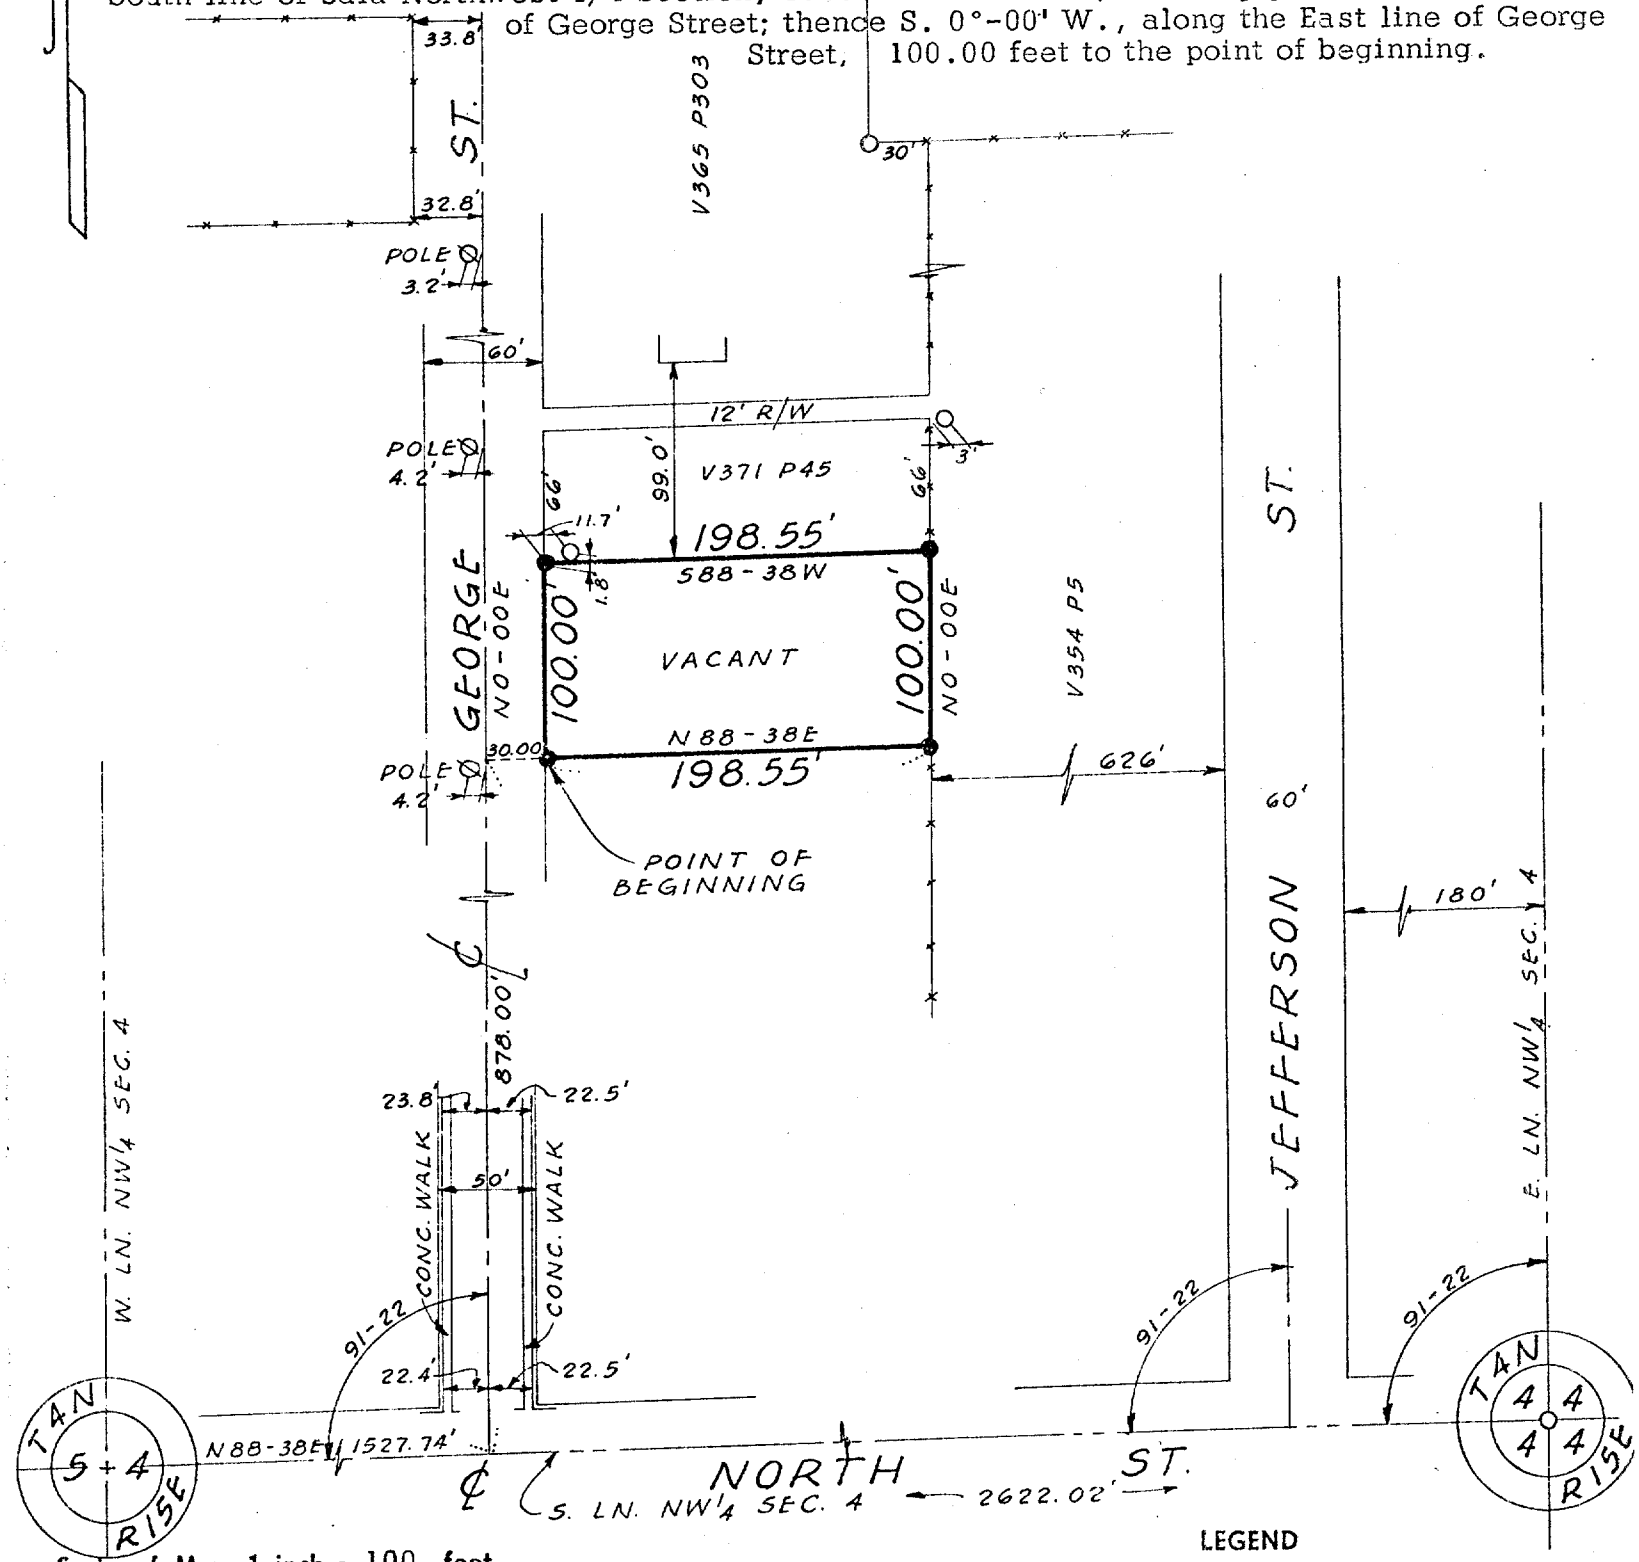

Scale of Map: 1 inch= 100 feet.

LEGEND

—○— Iron Pipes Found —X—X—X—X— Fences

—●— Iron Pipes Set —Ⓣ— T-Bar Stake Set

—•— Reference Points

STATE OF WISCONSIN } SS.
COUNTY OF JEFFERSON }

I, Paul E. Meves a registered surveyor of the State of Wisconsin, do hereby certify that on March 15, 196[illegible] I surveyed the above described property according to official records and that the accompanying map is a correctly dimensioned representation to the scale of the boundaries, that all buildings and improvements lie wholly within the boundary lines, and that no encroachments by adjacent property owners appear from said survey.

WISCONSIN PAUL E. LAND SURVEYOR

Paul E. Meves

SIGNATURE

W 55-61-F

Field Book XXIX Page 7095

Map No. 1040
62-10

10-233-WV