
#130-66

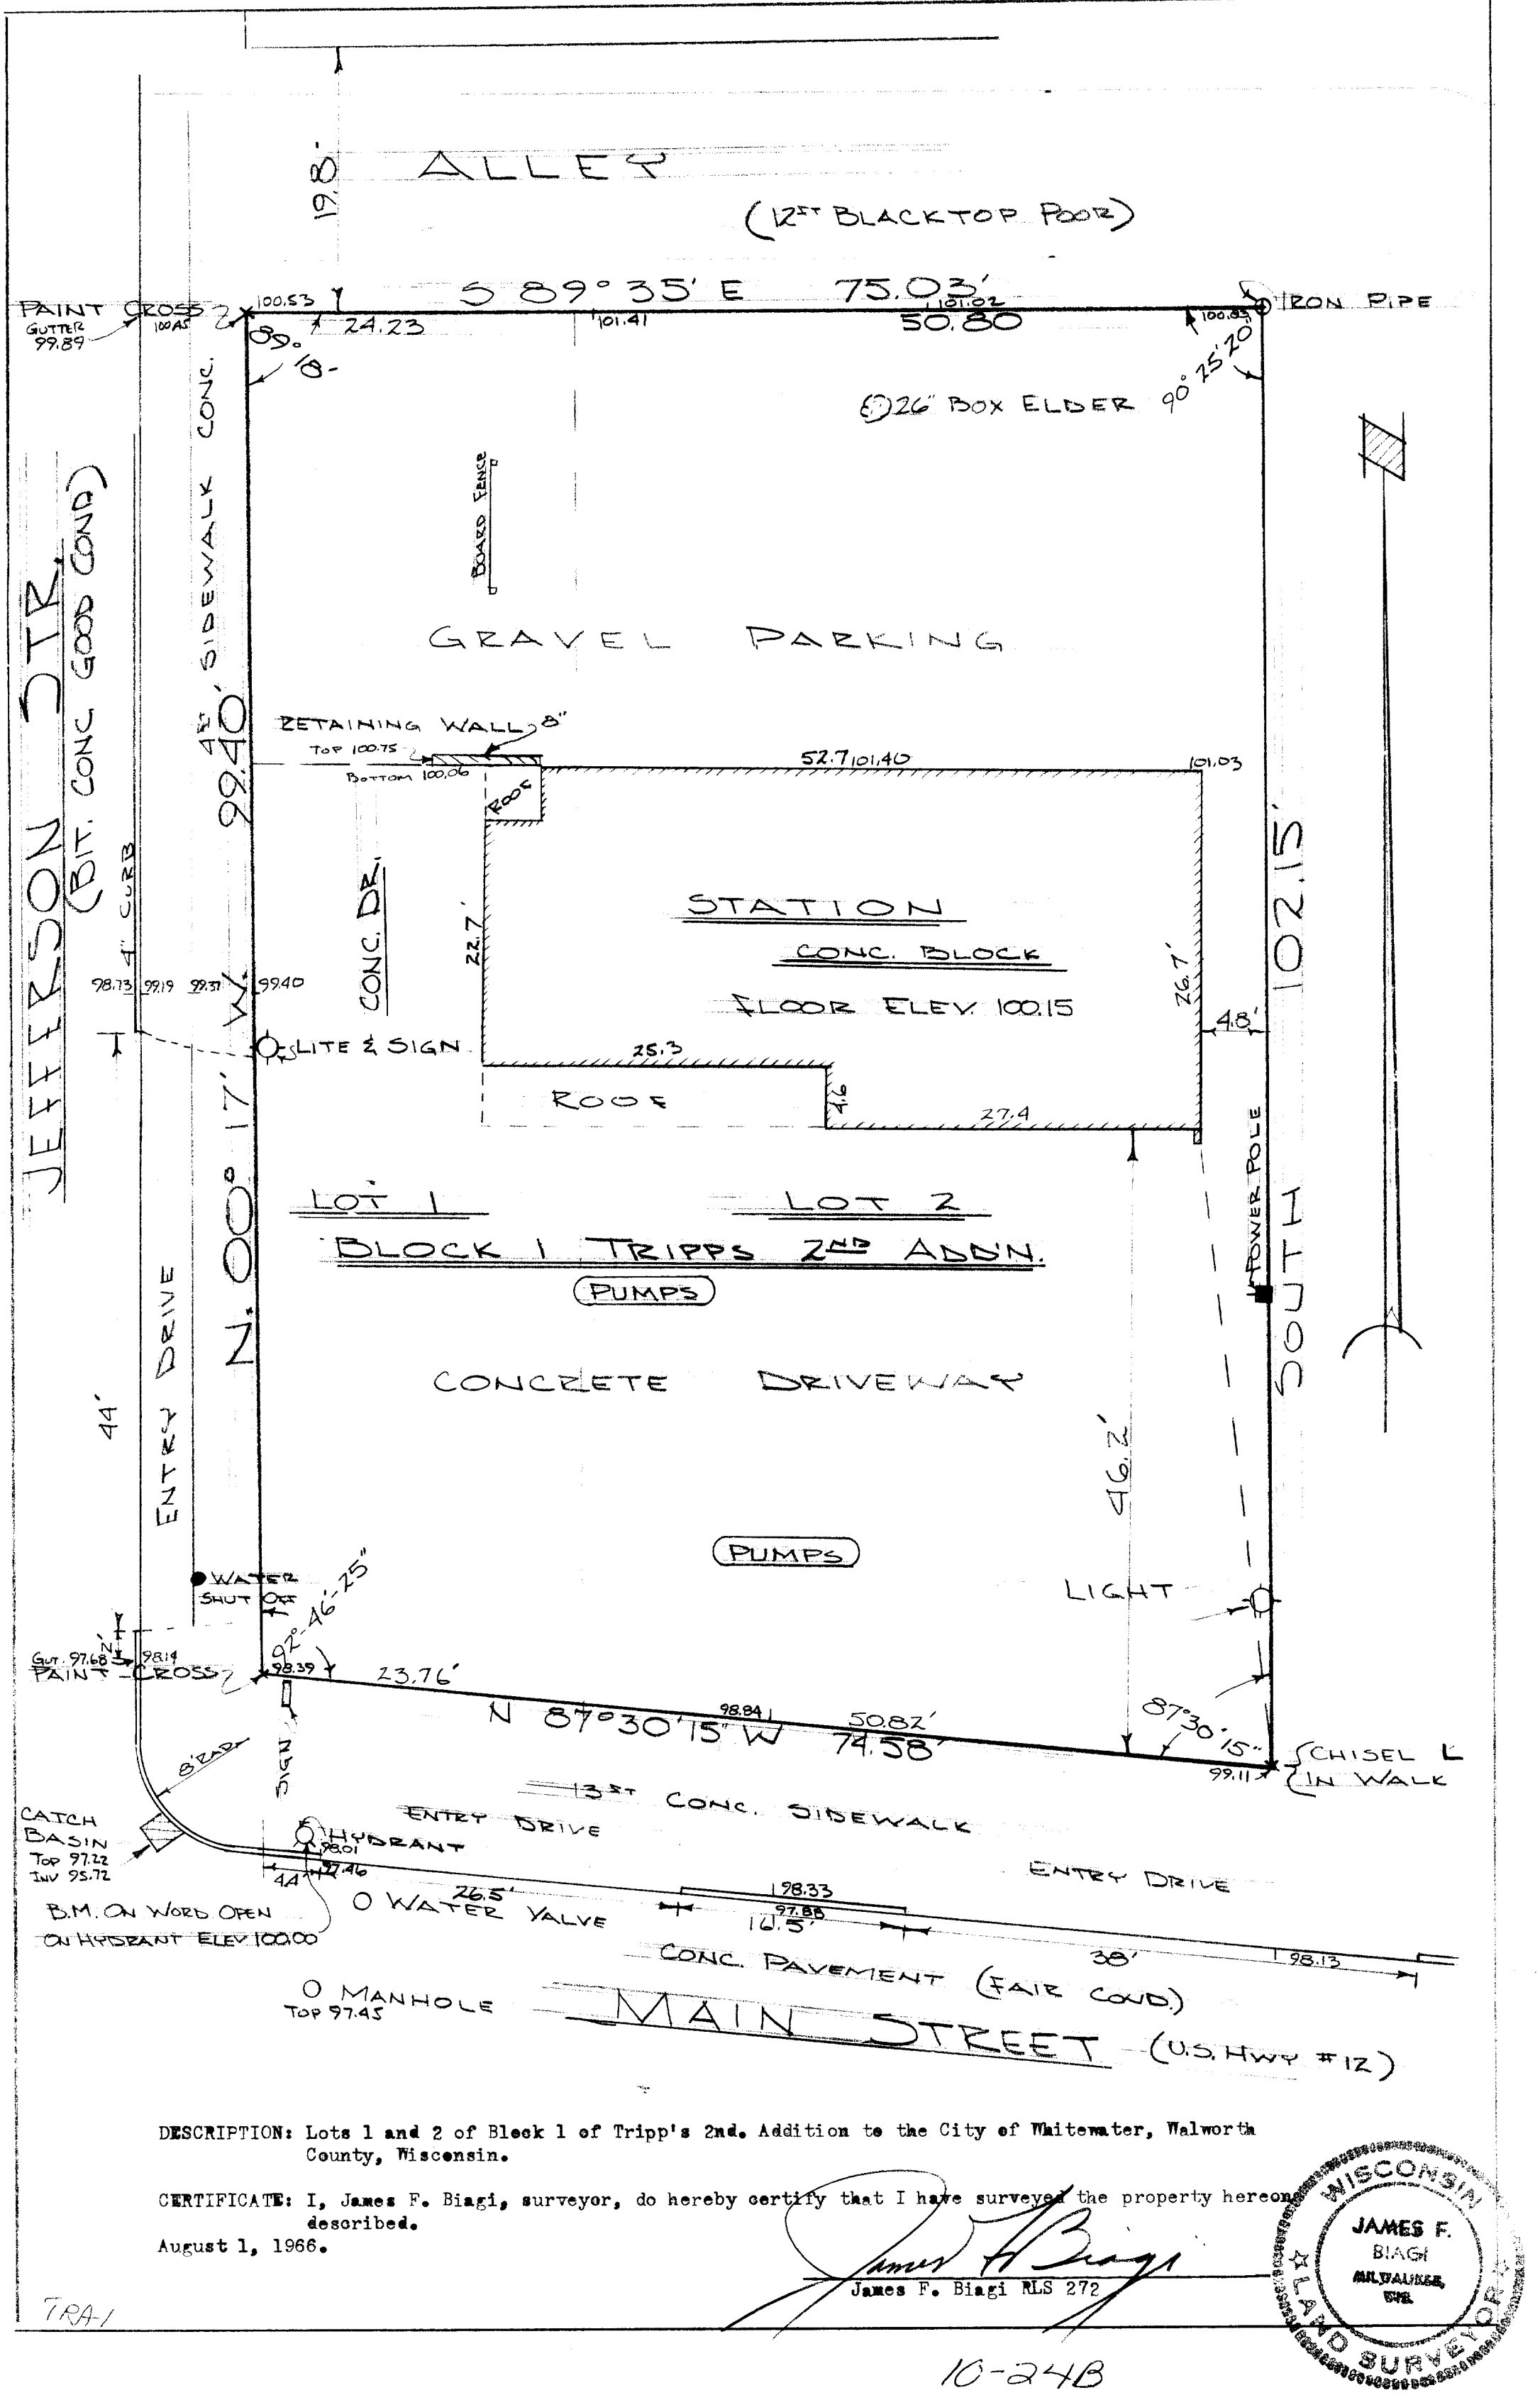

DESCRIPTION: Lots 1 and 2 of Block 1 of Tripp's 2nd. Addition to the City of Whitewater, Walworth County, Wisconsin.

CERTIFICATE: I, James F. Biagi, surveyor, do hereby certify that I have surveyed the property hereon described.

August 1, 1966.

James F. Biagi RLS 272

WISCONSIN
JAMES F. BIAGI
MILWAUKEE, WIS.
LAND SURVEYOR

TRA-1

10-24B