
#130-66
#116-69

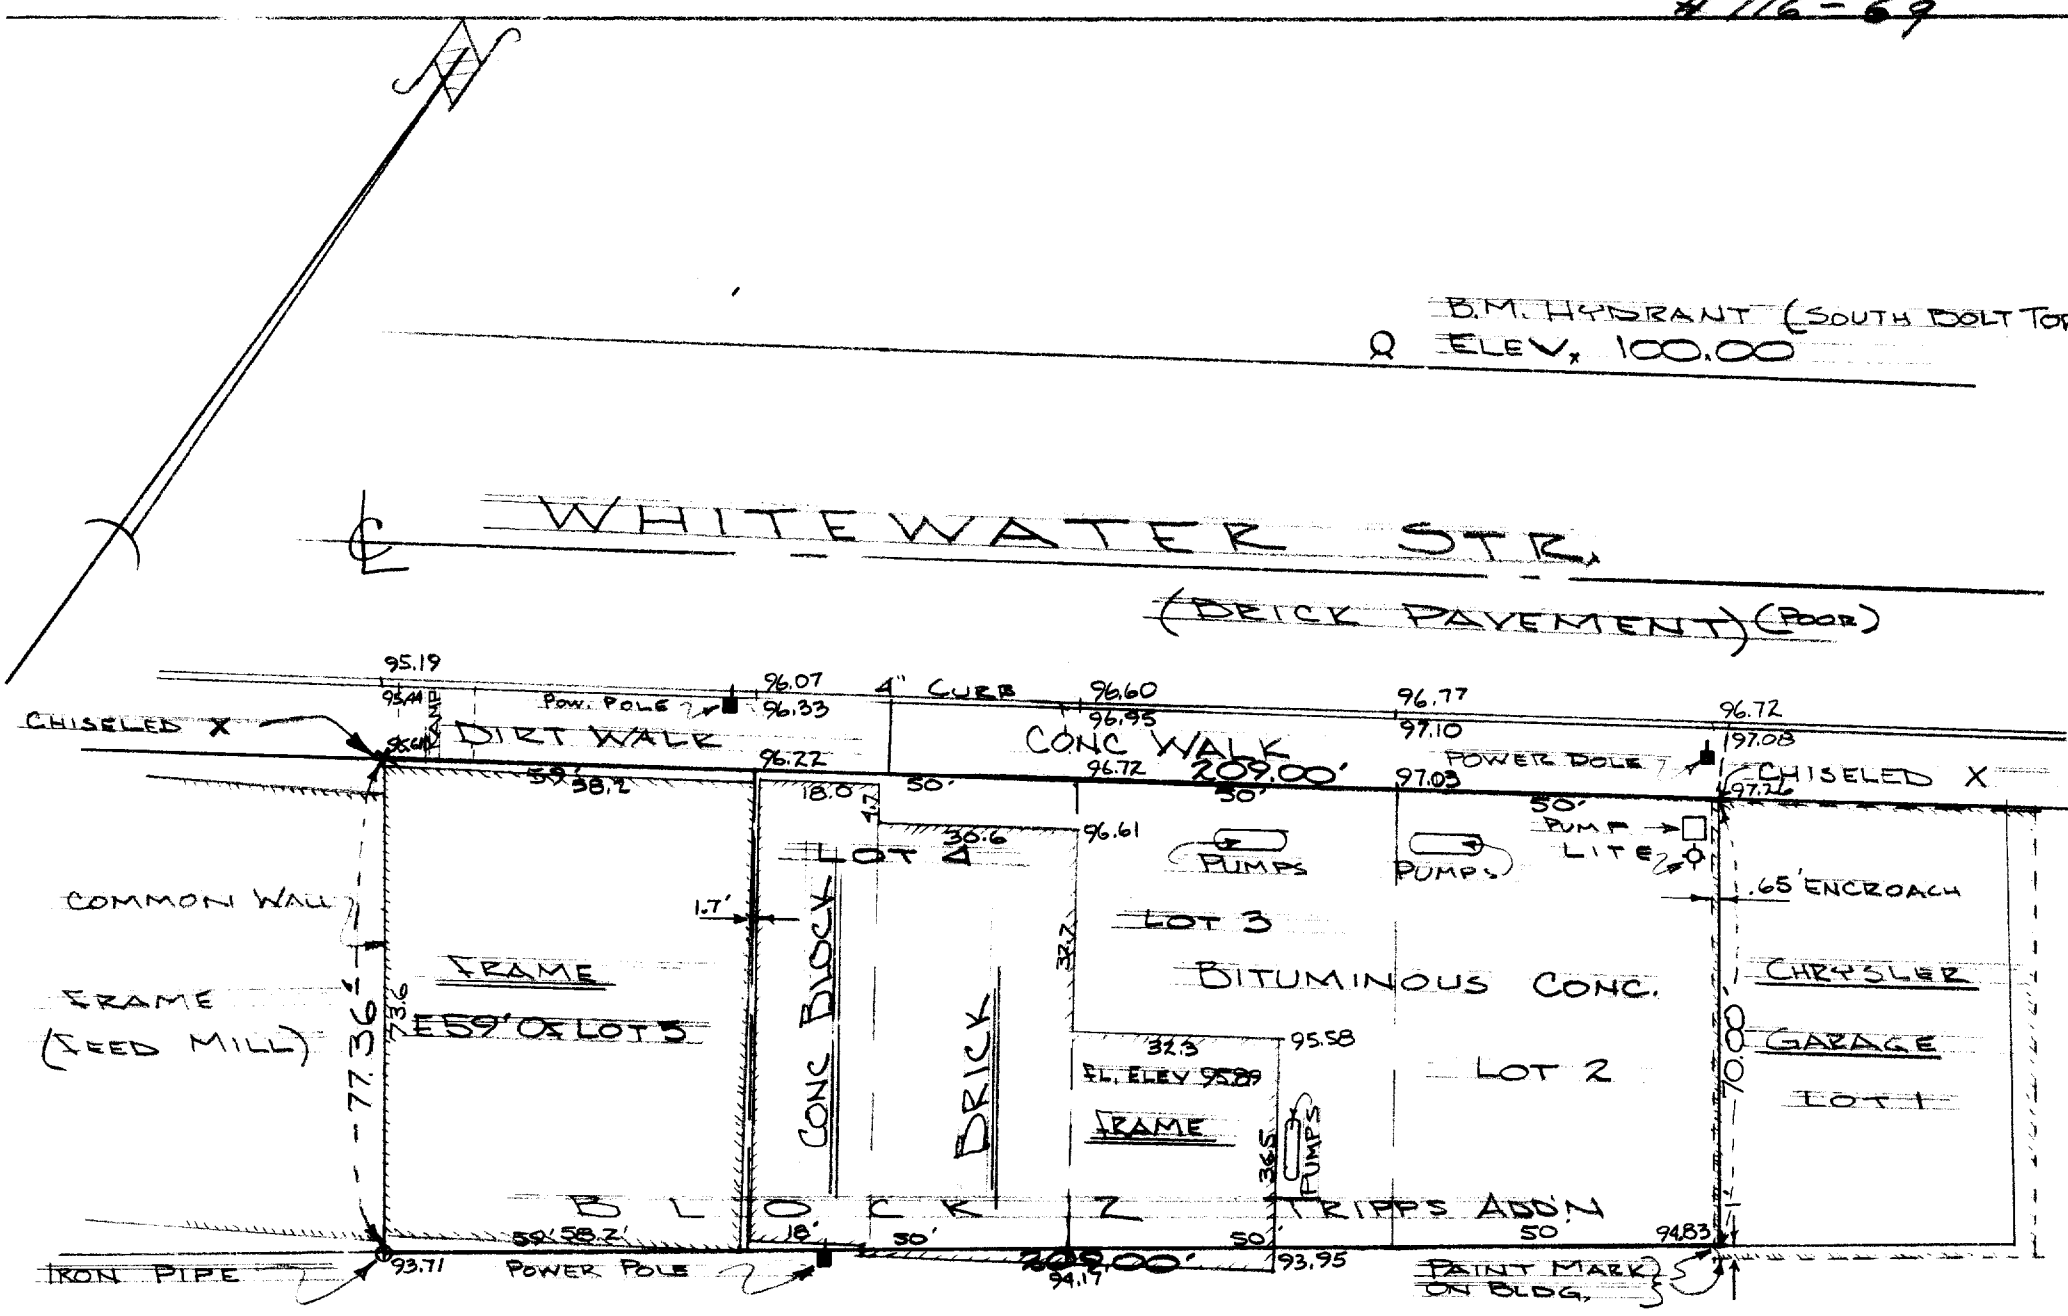

RAIL ROAD — RIGHT OF WAY

CHIC.-MIL.-ST. PAUL- & PACIFIC R.R.

℄ JAMES STREET

DESCRIPTION: Lots 2, 3, 4, and the East 59.00 feet to Lot 5 of Block (#1) Blk 2 in Tripp's Addition to the City of Whitewater, Walworth County, Wisconsin.

CERTIFICATE: I, James F. Biagi, surveyor, do hereby certify that I have surveyed the property hereon described, and that the location of the improvements are as shown.

August, 19, 1969

James F. Biagi

James F. Biagi RLS 272

WISCONSIN
JAMES F.
BIAGI
MILWAUKEE, WIS.
LAND SURVEYOR

IR - #7 [redacted]
4-12

10-25B