
#130 B-66

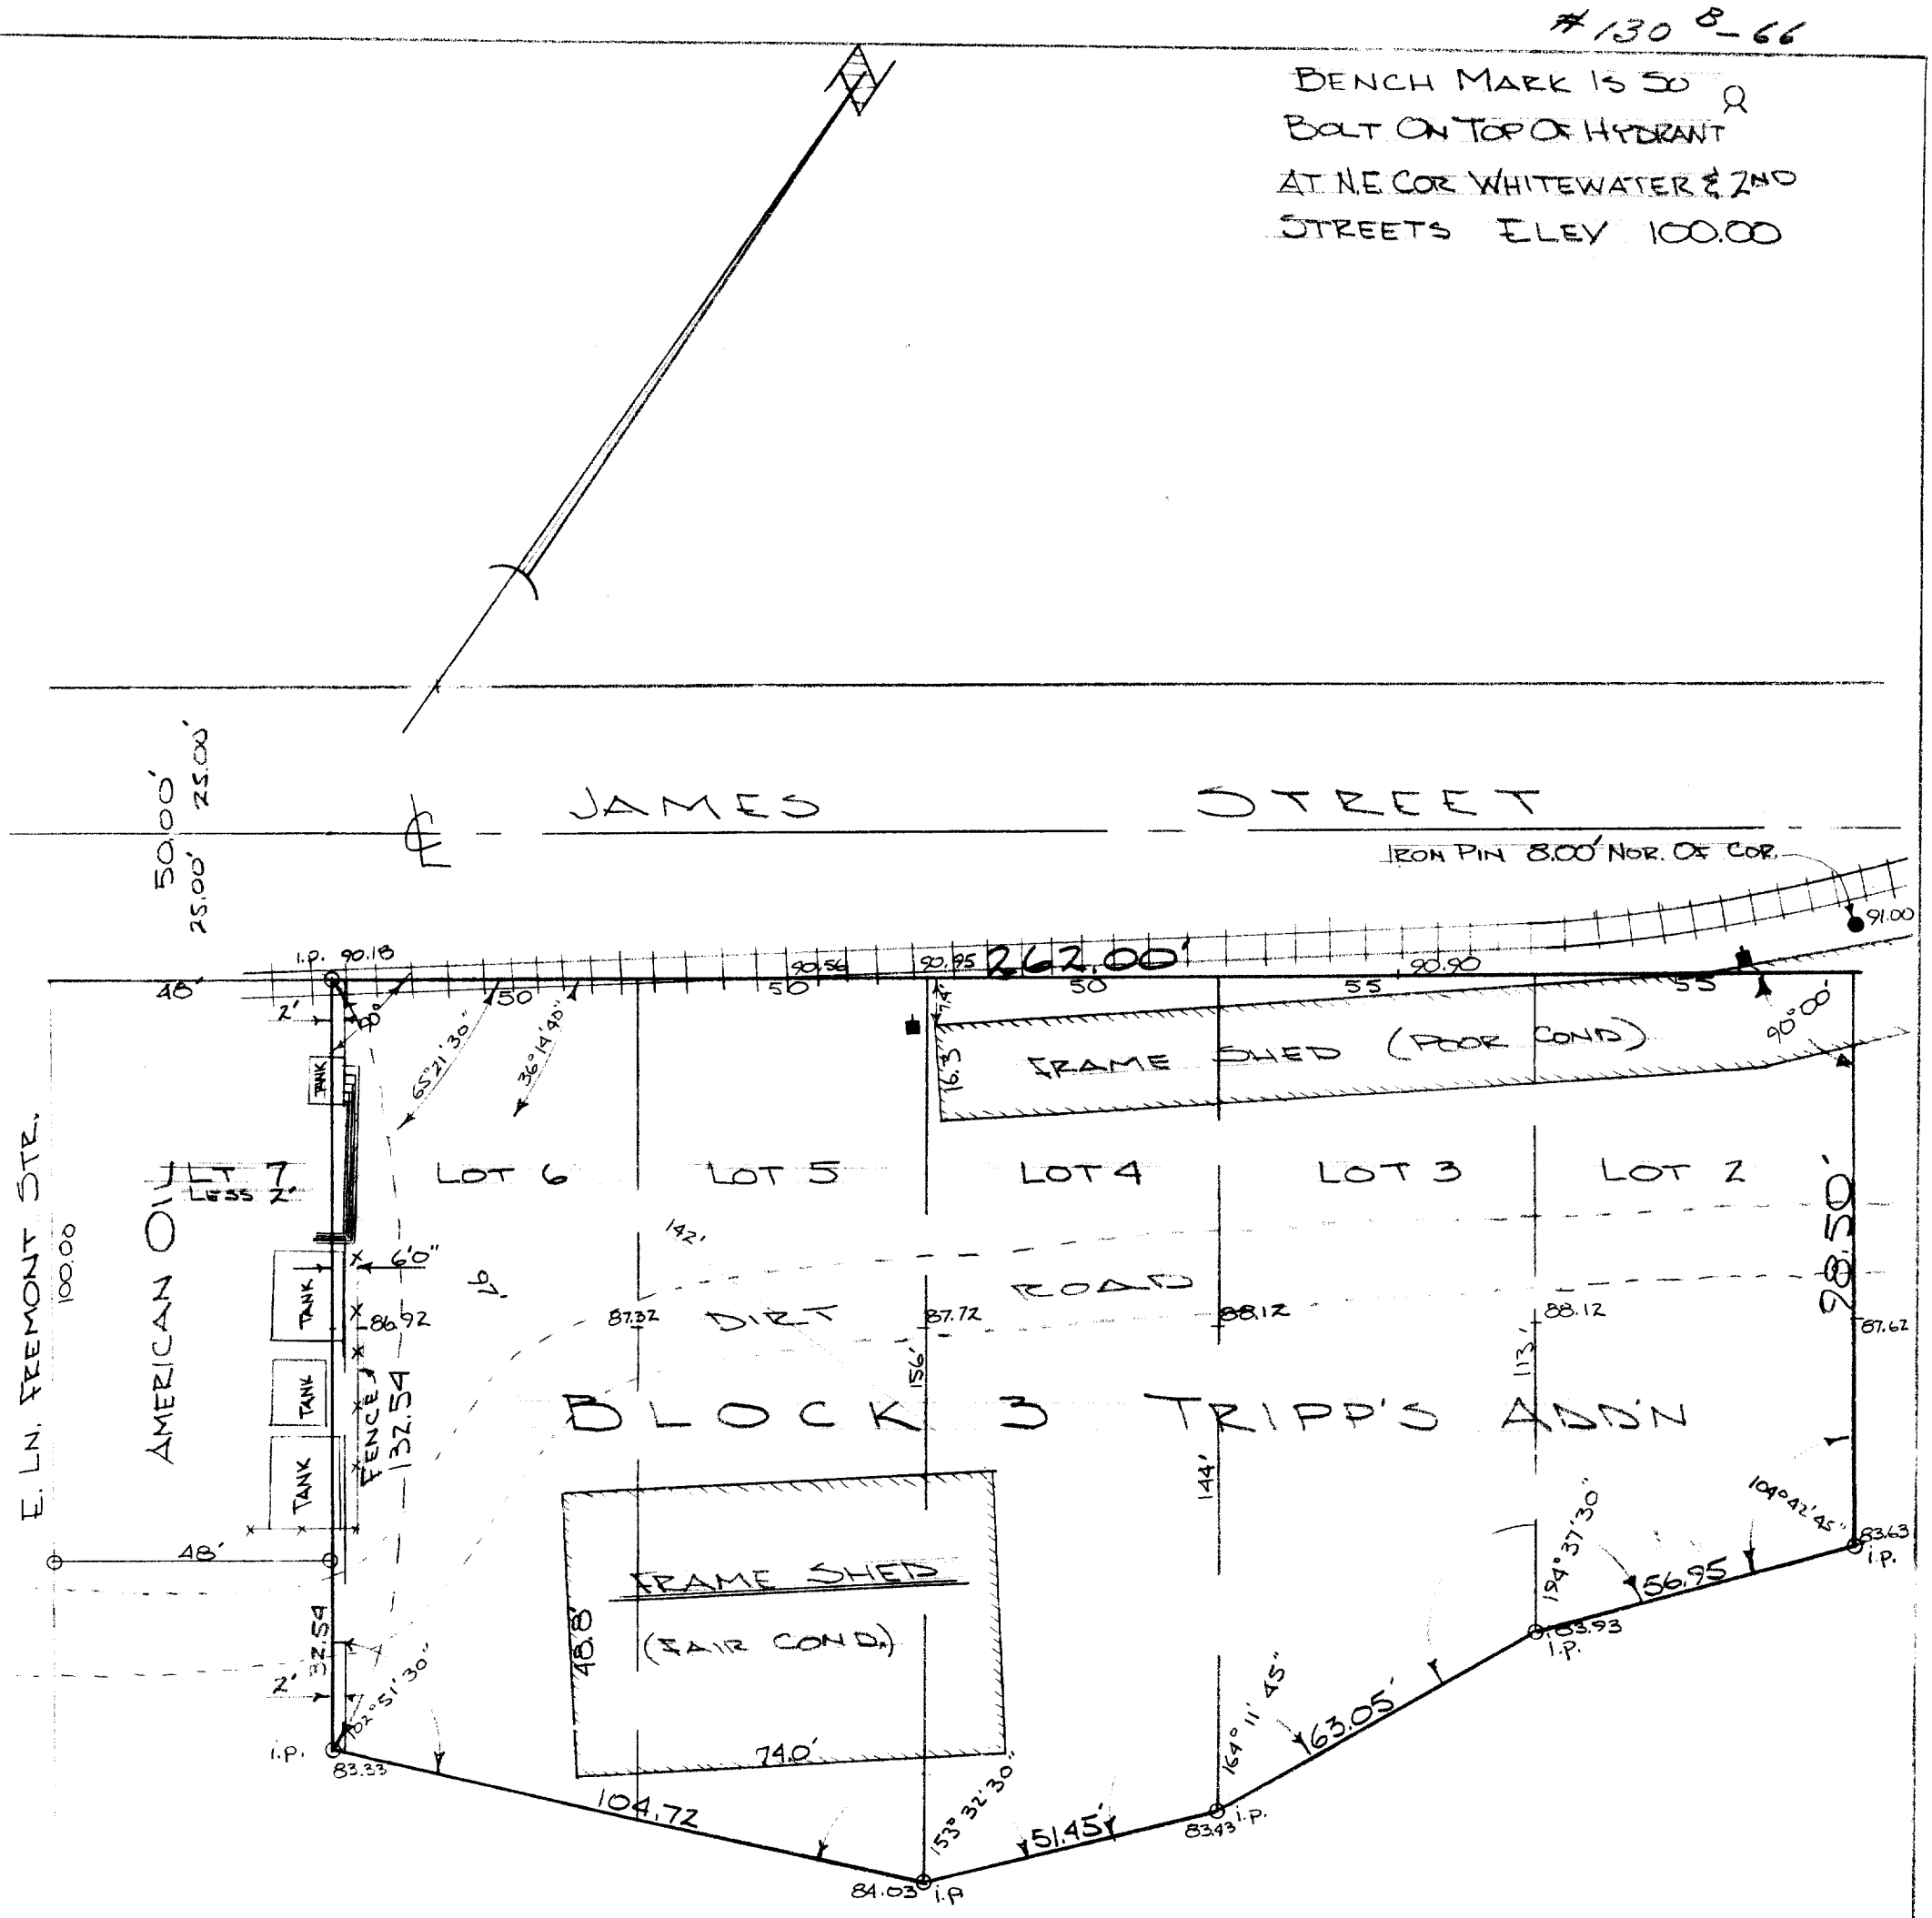

DESCRIPTION: Lots 2, 3, 4, 5, 6, and the East 2.00 feet of Lot 7, Block 3 of Tripp's Addition to the City of Whitewater, Walworth County, Wisconsin.

CERTIFICATE: I, James F. Biagi, surveyor, do hereby certify that I have surveyed the property hereon described.

August 1, 1966.

WISCONSIN
JAMES F.
BIAGI
MILWAUKEE, WIS.
LAND SURVEYOR

James F. Biagi RLS 272

TR-16

10-26B