



HAROLD H. KOLB
REGISTERED PROFESSIONAL LAND SURVEYOR
LAKE GENEVA, WISCONSIN

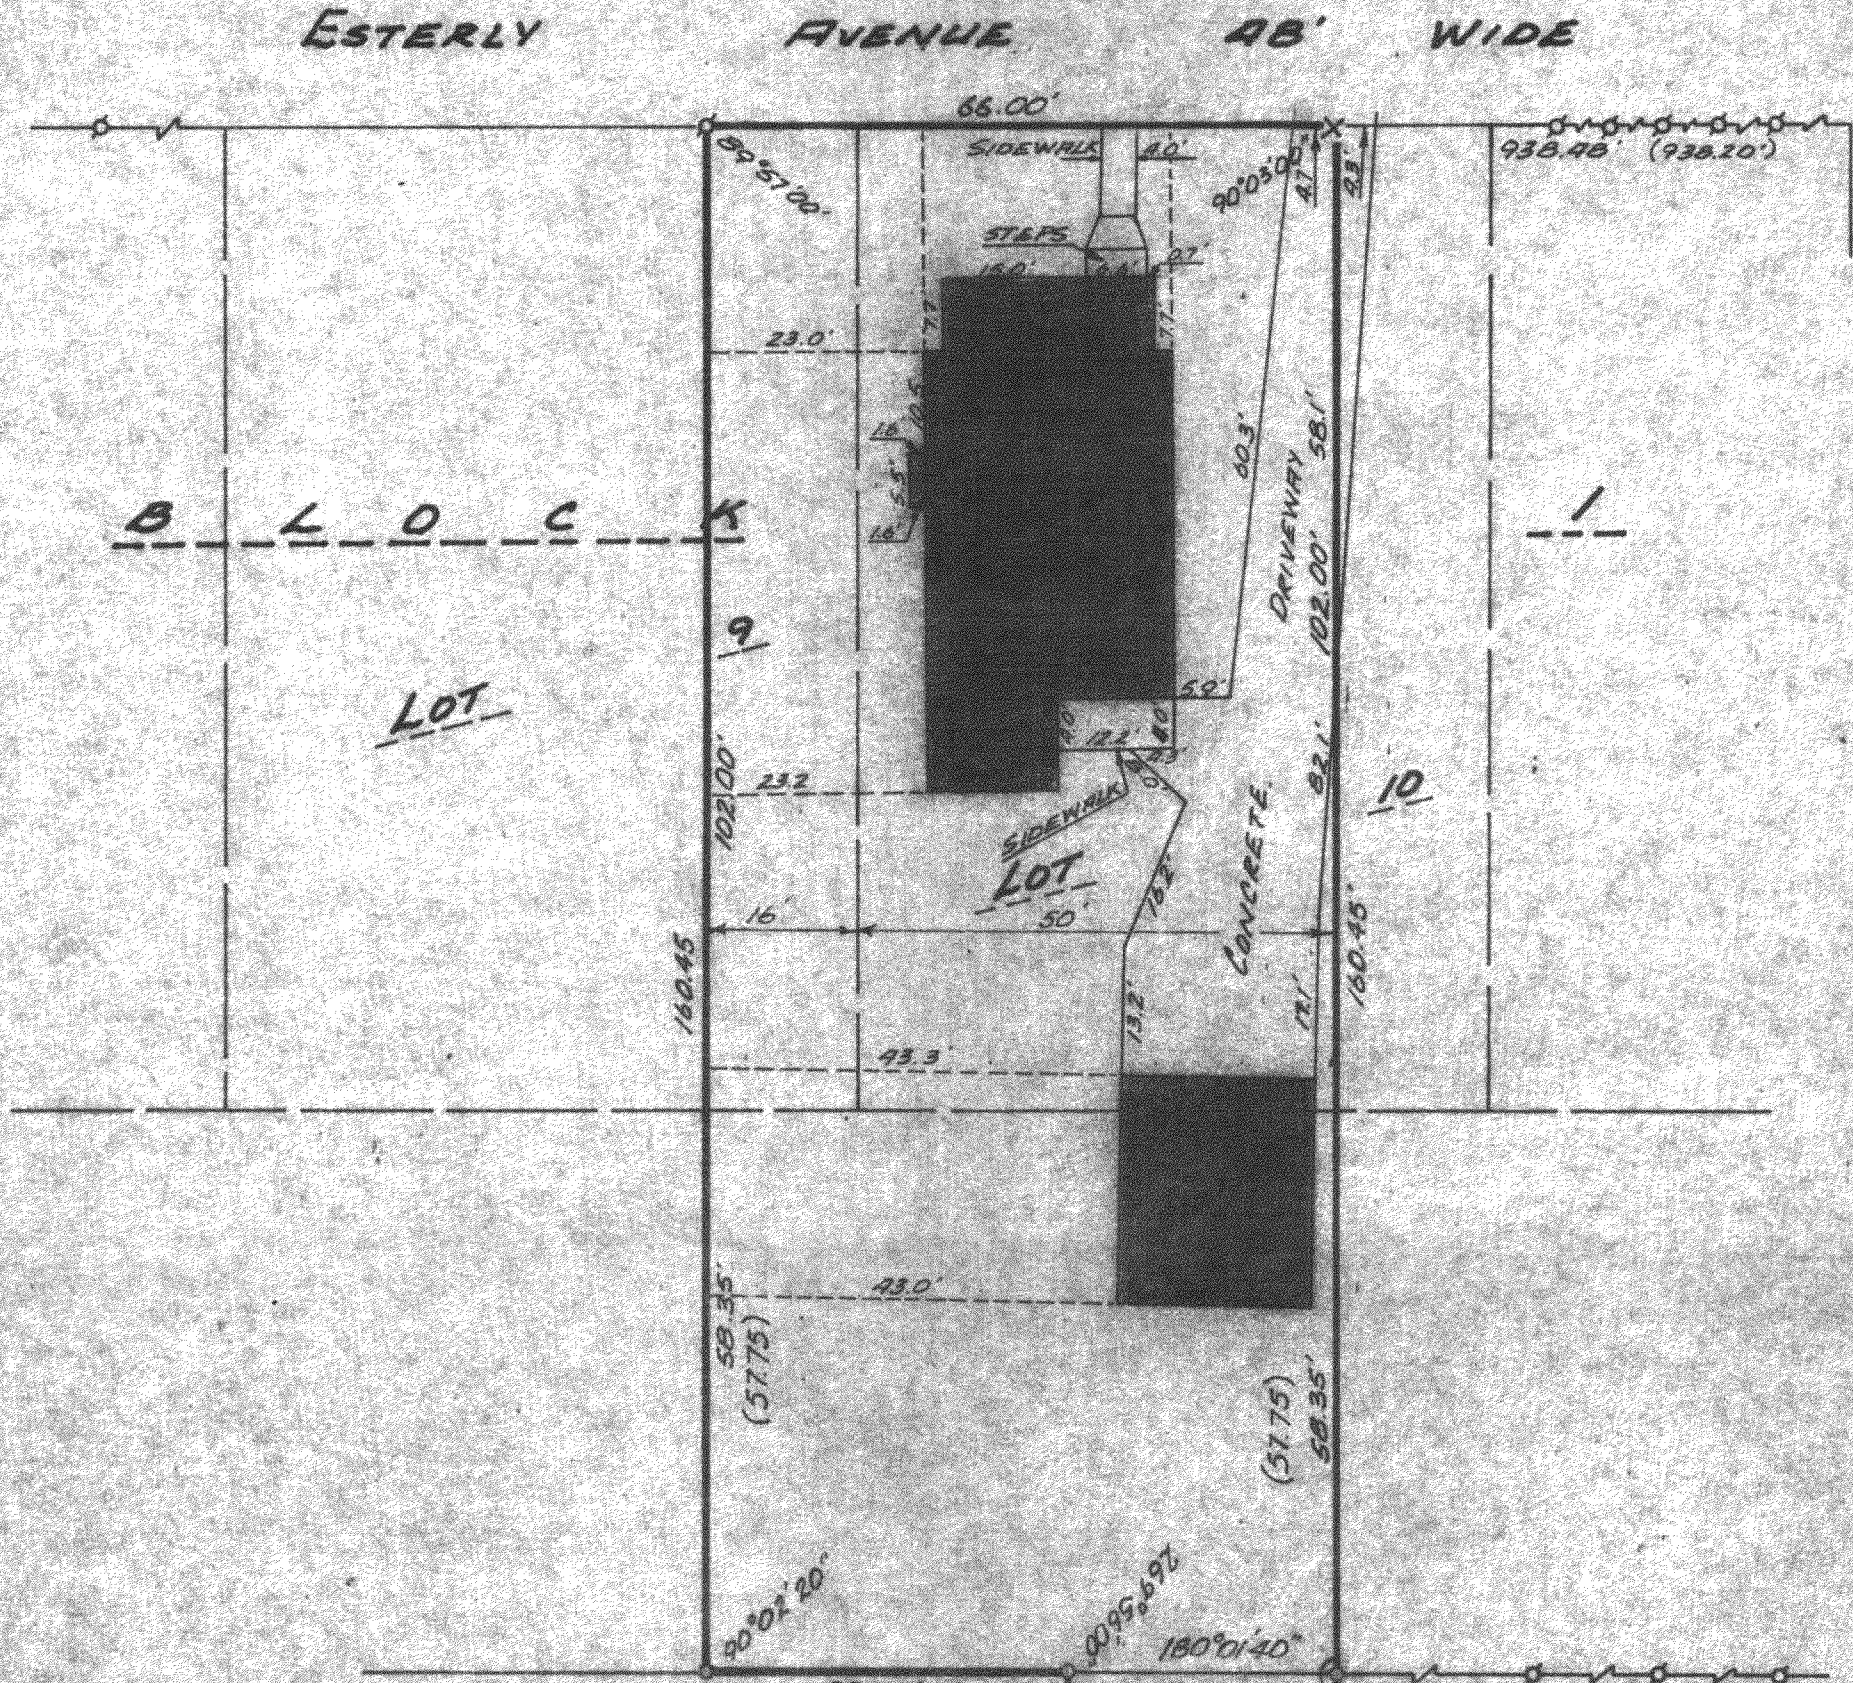

PLAT OF SURVEY OF
The South 50.00 feet of Lot 10 and the North 16.00 feet of Lot 9,
Block 1, First and Johnson's Addition and 2 parcels of land located
in the Northeast 1/4 of Section 5, T4N, R15E, City of Whitewater,
Walworth County, Wisconsin.

Accuracy - Distances, $\pm .01'$
Angles $\pm .05''$
Error of closure less than
1 part in 3000

Ordered by: Martin Harrison
Whitewater, Wisconsin

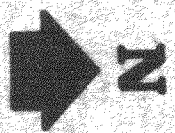

SCALE: 1" = 20'

LEGEND

- φ - IRON PIPE FOUND
- - IRON PIPE PLACED
- - CONCRETE MONUMENT
- x - CUT CROSS
- () - RECORDED AS
- ⊙ - IRON ROD FOUND



I, HAROLD H. KOLB, DO HEREBY CERTIFY THAT I HAVE
SURVEYED THE PROPERTY HEREON DESCRIBED ACCORDING
TO THE OFFICIAL RECORDS, AND THAT THE PLAT HEREON
IS A CORRECT REPRESENTATION OF THE LOT LINES.

HAROLD H. KOLB
WISCONSIN REGISTERED LAND SURVEYOR, S-187
DATE Aug 5, 1976

North line lot 9,
Block 2, Cooper and
Cox Add.

10-277