
#172-67

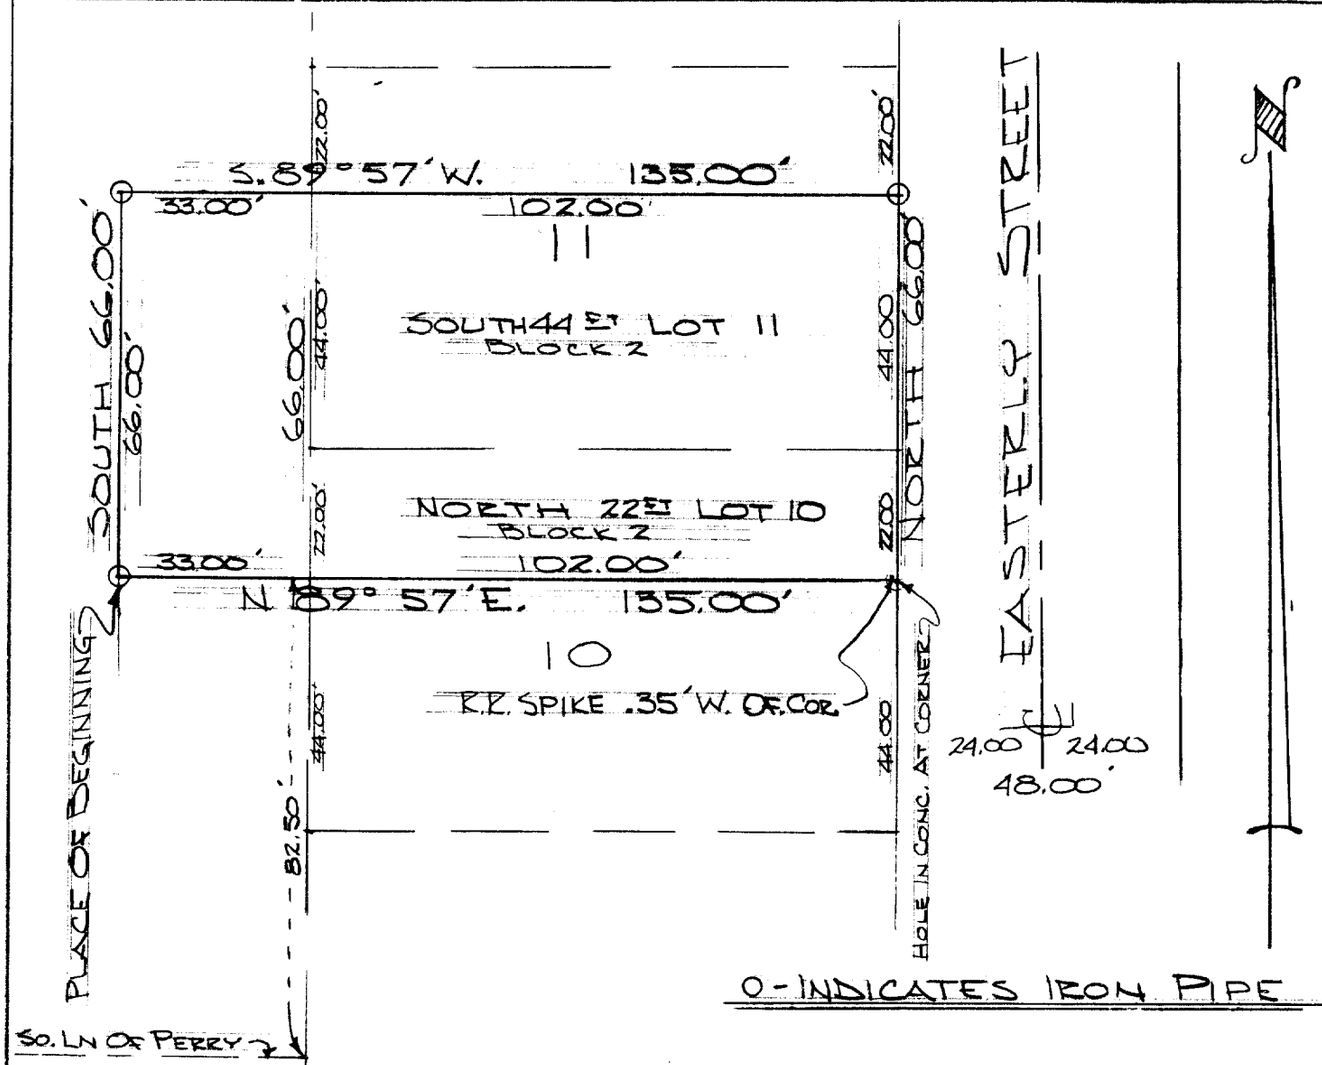

DESCRIPTION: The North 22.00 feet of Lot 10 and the South 44.00 feet of Lot 11 of Block 2, in Fish and Johnson's Addition to the City of Whitewater, Walworth County, Wisconsin. Also commencing at a point that is 10 rods east of, and 2 rods north of the point of intersection of of the south line Lot 5 of F.L.Platts Addition, extended, and the East line of Prairie Street, in the City of Whitewater, thence N. 89° 57' E. 33.00 feet to a point in the West line of aforementioned Lot 10, 22.00 feet south of the NW corner of said lot, thence North 66.00 feet to a point in the west line of Lot 11, that is 22.00 feet south of the NW corner thereof, thence S. 89° 57' W. 33.00 feet, thence South 66.00 feet to the place of beginning.

CERTIFICATE: I, James F. Biagi, surveyor, do hereby certify that I have surveyed the property hereon described.

November 6, 1967

James F. Biagi

WISCONSIN
JAMES F.
BIAGI
MILWAUKEE,
WIS.
LAND SURVEYOR

FJ - 33 + Wup-110A

10-27B