



HAROLD H. KOLB
REGISTERED PROFESSIONAL LAND SURVEYOR
LAKE GENEVA, WISCONSIN

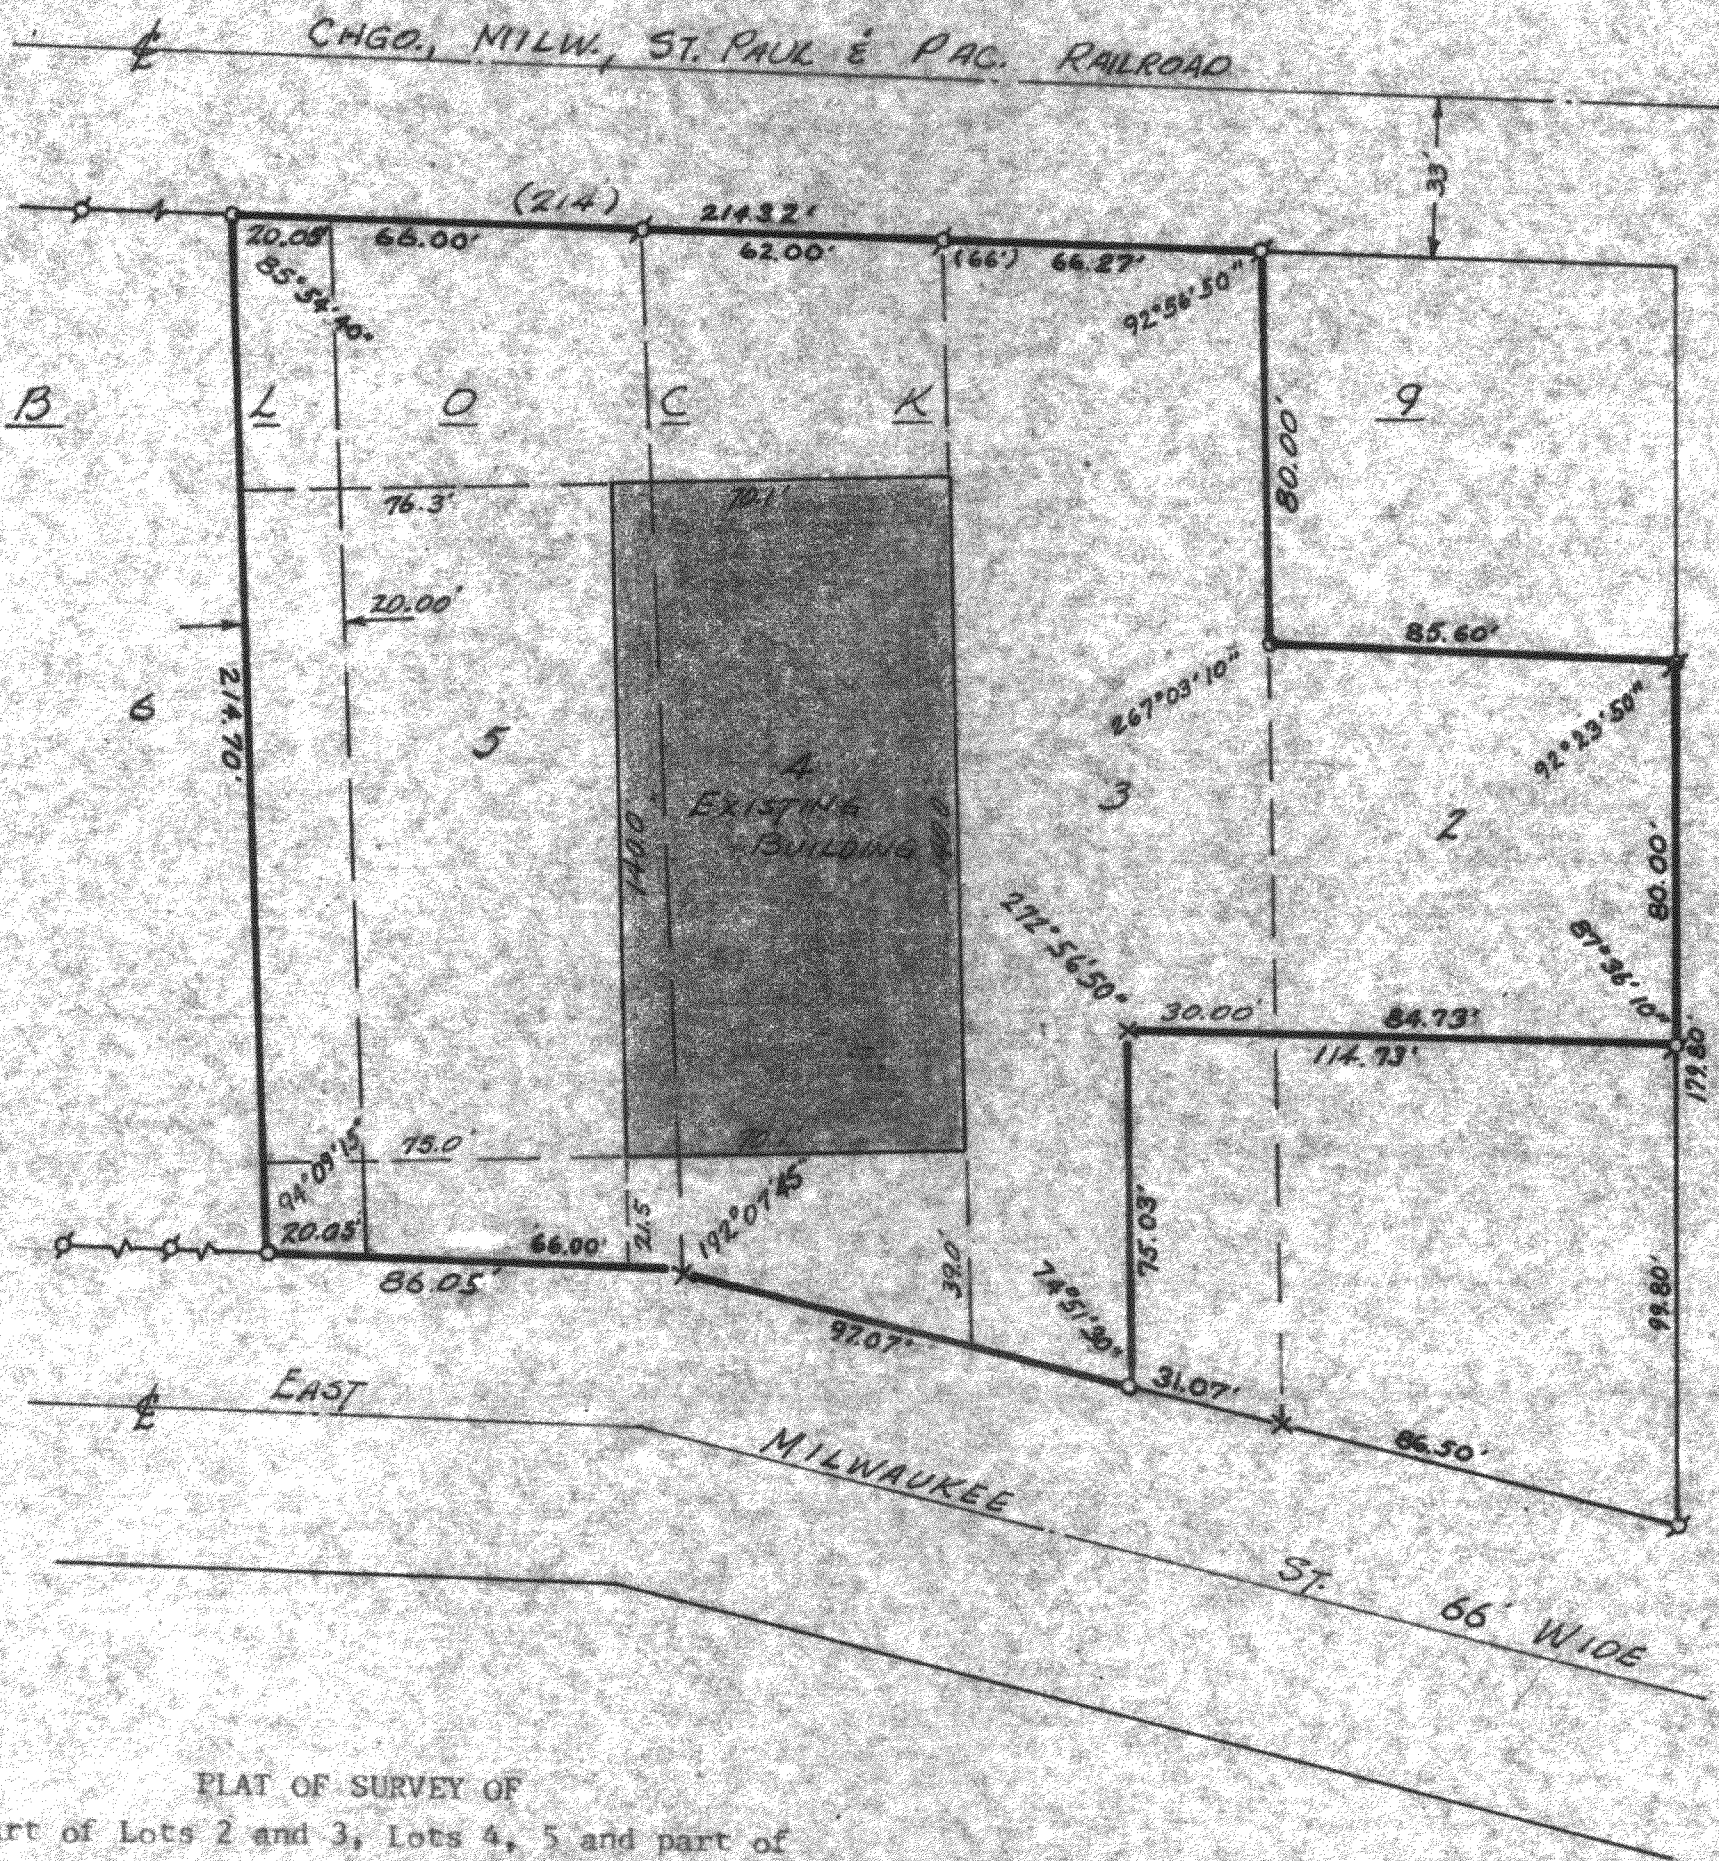

PLAT OF SURVEY OF
Part of Lots 2 and 3, Lots 4, 5 and part of
Lot 6, Block 9, S. C. Hall's Addition, City of
Whitewater, Walworth County, Wisconsin.

OWNER: The Coburn Co.
834 E. Milwaukee St.
Whitewater, Wisconsin

ACCURACY - Distances $\pm .01'$
Angles $\pm 05''$
Error of closure less
than 1 part in 3000

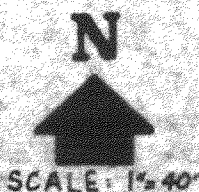

LEGEND

- φ - IRON PIPE FOUND
- - IRON PIPE PLACED
- - CONCRETE MONUMENT
- ✕ - RAILROAD SPIKE
- () - RECORDED AS

EUGENE A. BLONQUIST DO HEREBY CERTIFY THAT I HAVE
SURVEYED THE PROPERTY HEREON DESCRIBED ACCORDING
TO THE OFFICIAL RECORDS, AND THAT THE PLAT HEREON
IS A CORRECT REPRESENTATION OF THE LOT LINES.

EUGENE A. BLONQUIST
WISCONSIN REGISTERED LAND SURVEYOR, 5-1279
DATE NOV. 8, 1976