
#103-68

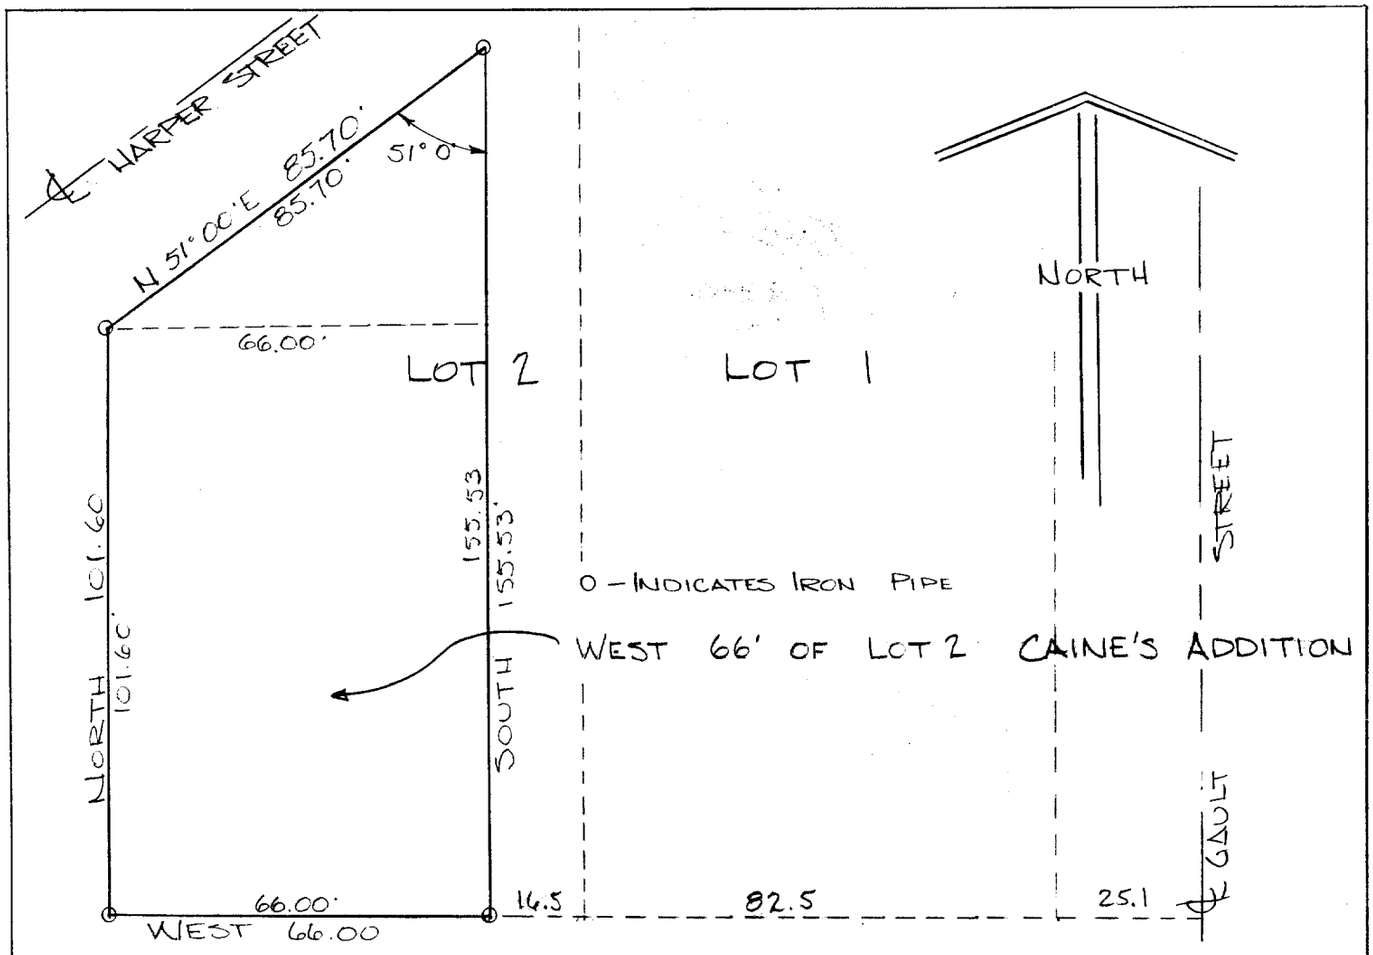

Description: The West 66.00 feet of Lot #2 Blk 3 of Caine's Addition in the NE ¼ of Section 8, T. 4 N., R. 15 E., the City of Whitewater, Walworth County, Wisconsin.

Certificate: I, James F. Biagi, surveyor, do hereby certify that I have surveyed the property hereon described.

WISCONSIN
JAMES F.
BIAGI
MILWAUKEE, WIS.
LAND SURVEYOR

James F. Biagi RLS 272

August 19, 1968

CA-20A

10-28B