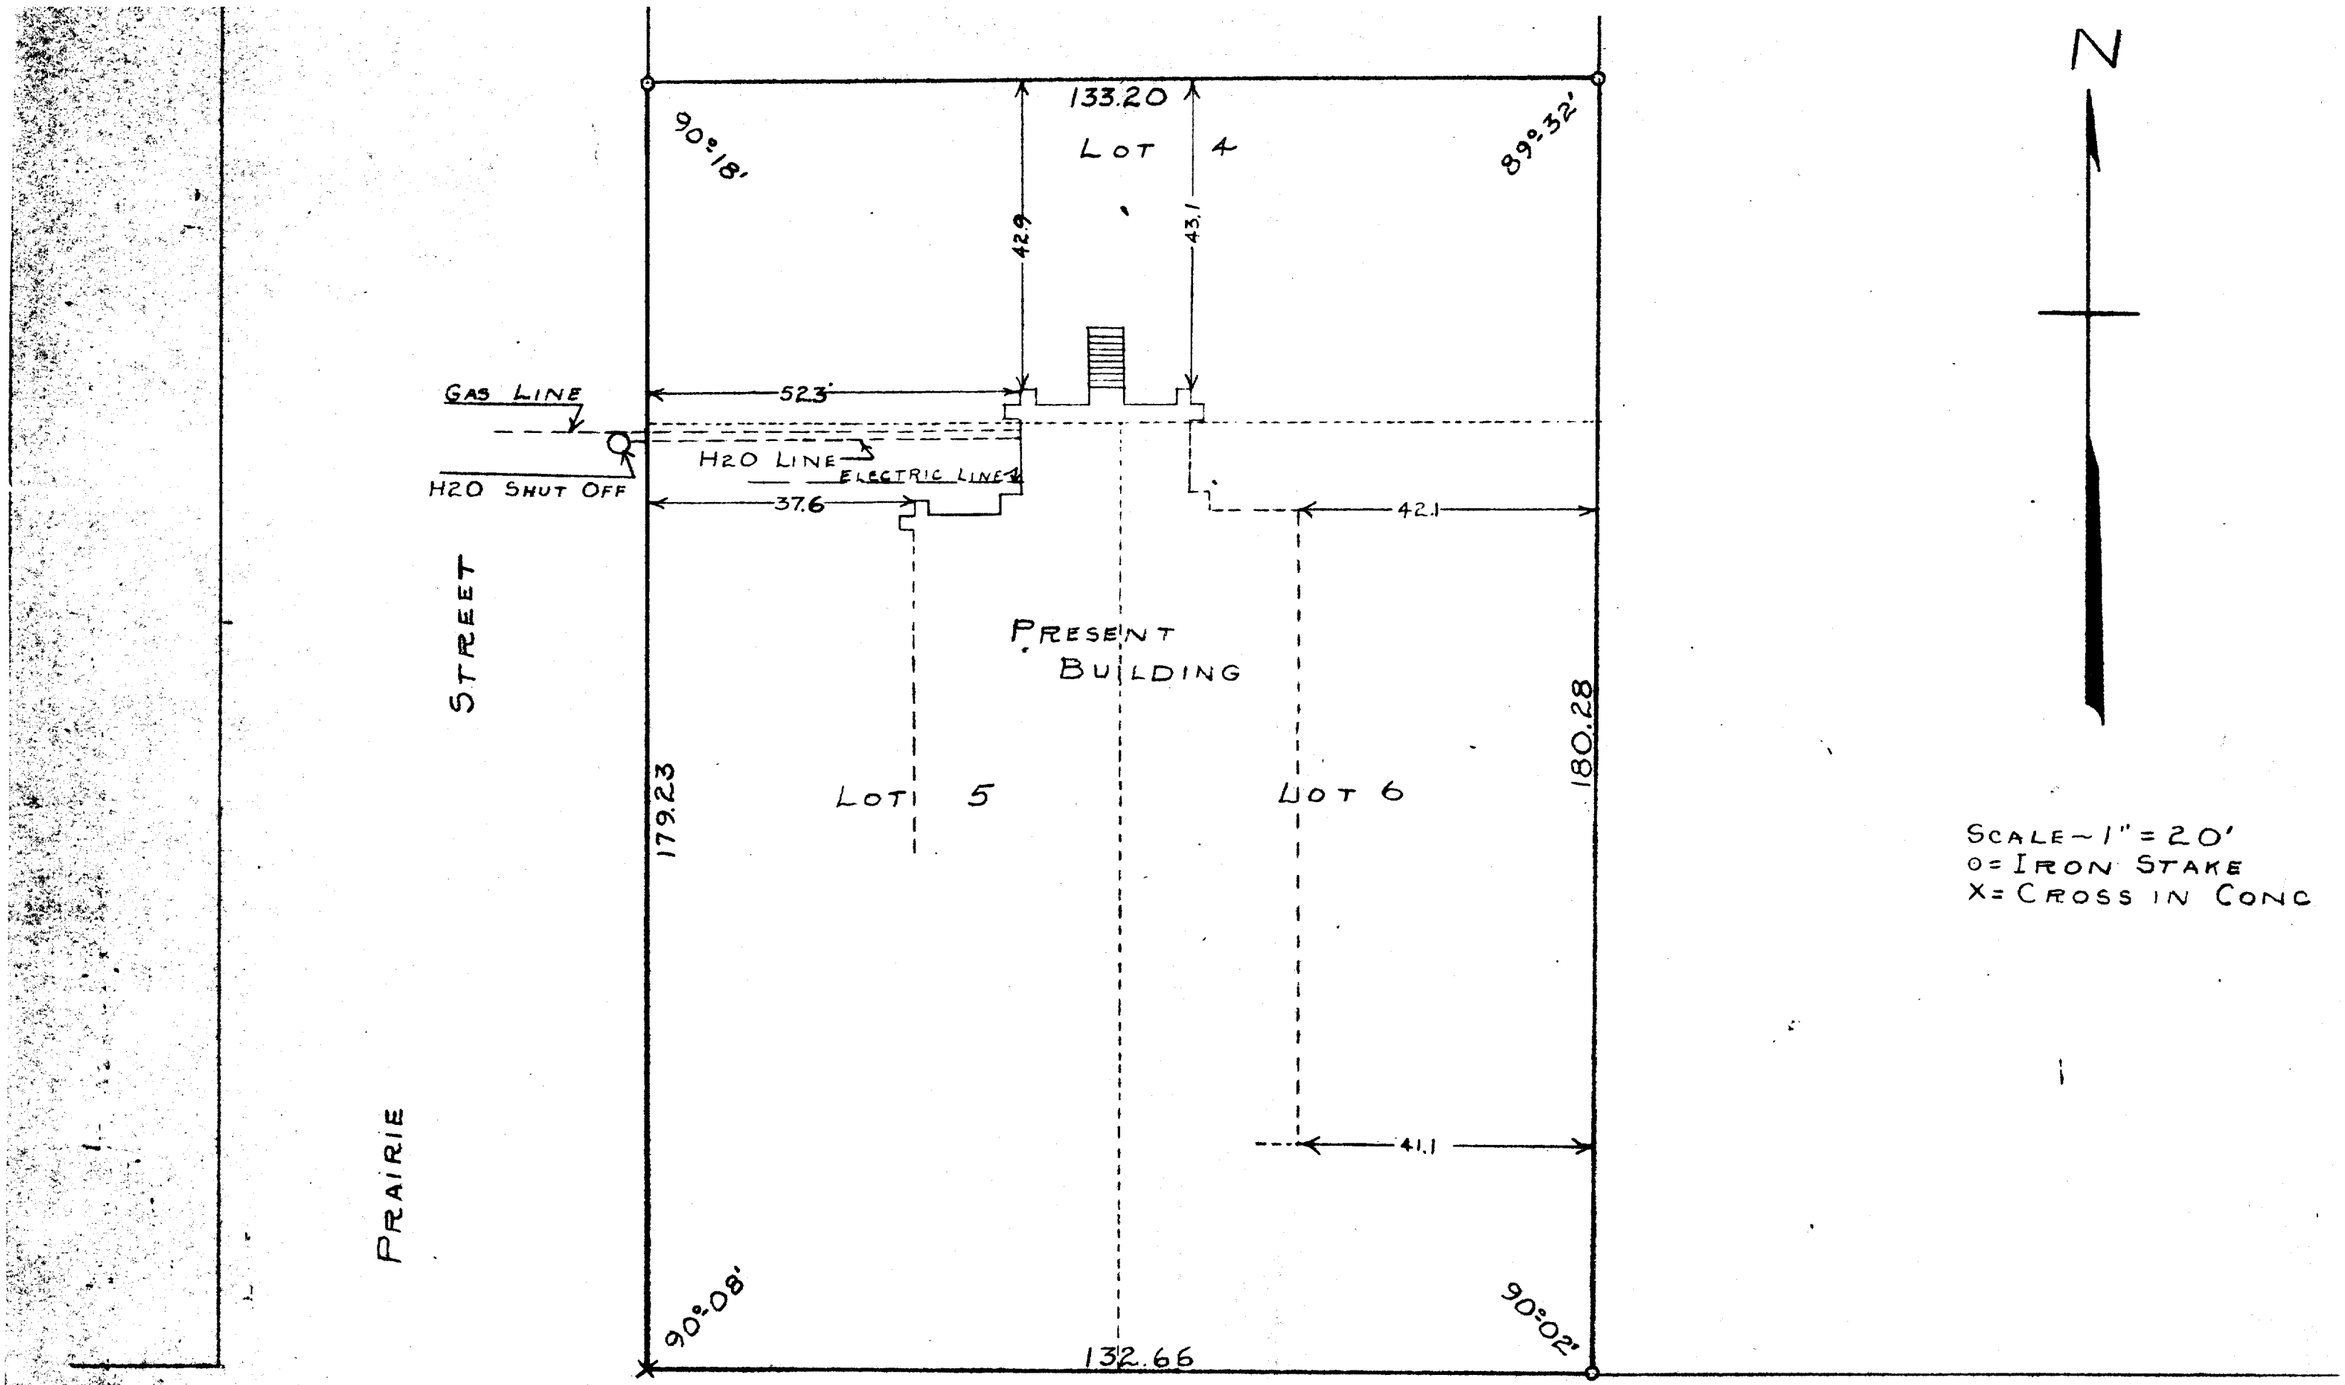


PLAT OF SURVEY OF LOTS 5 AND 6 AND PART OF LOT 4 IN BLOCK 16 OF CHAPMAN AND ADDITION TO THE VILLAGE (NOW CITY) OF WHITEWATER, WALWORTH COUNTY, WISCONSIN WHICH PROPERTY IS NOW OWNED BY THE FIRST METHODIST CHURCH
NOV. 19, 1952

George T Dunham
SURVEYOR

.CL-10

10-2-D