
168/70

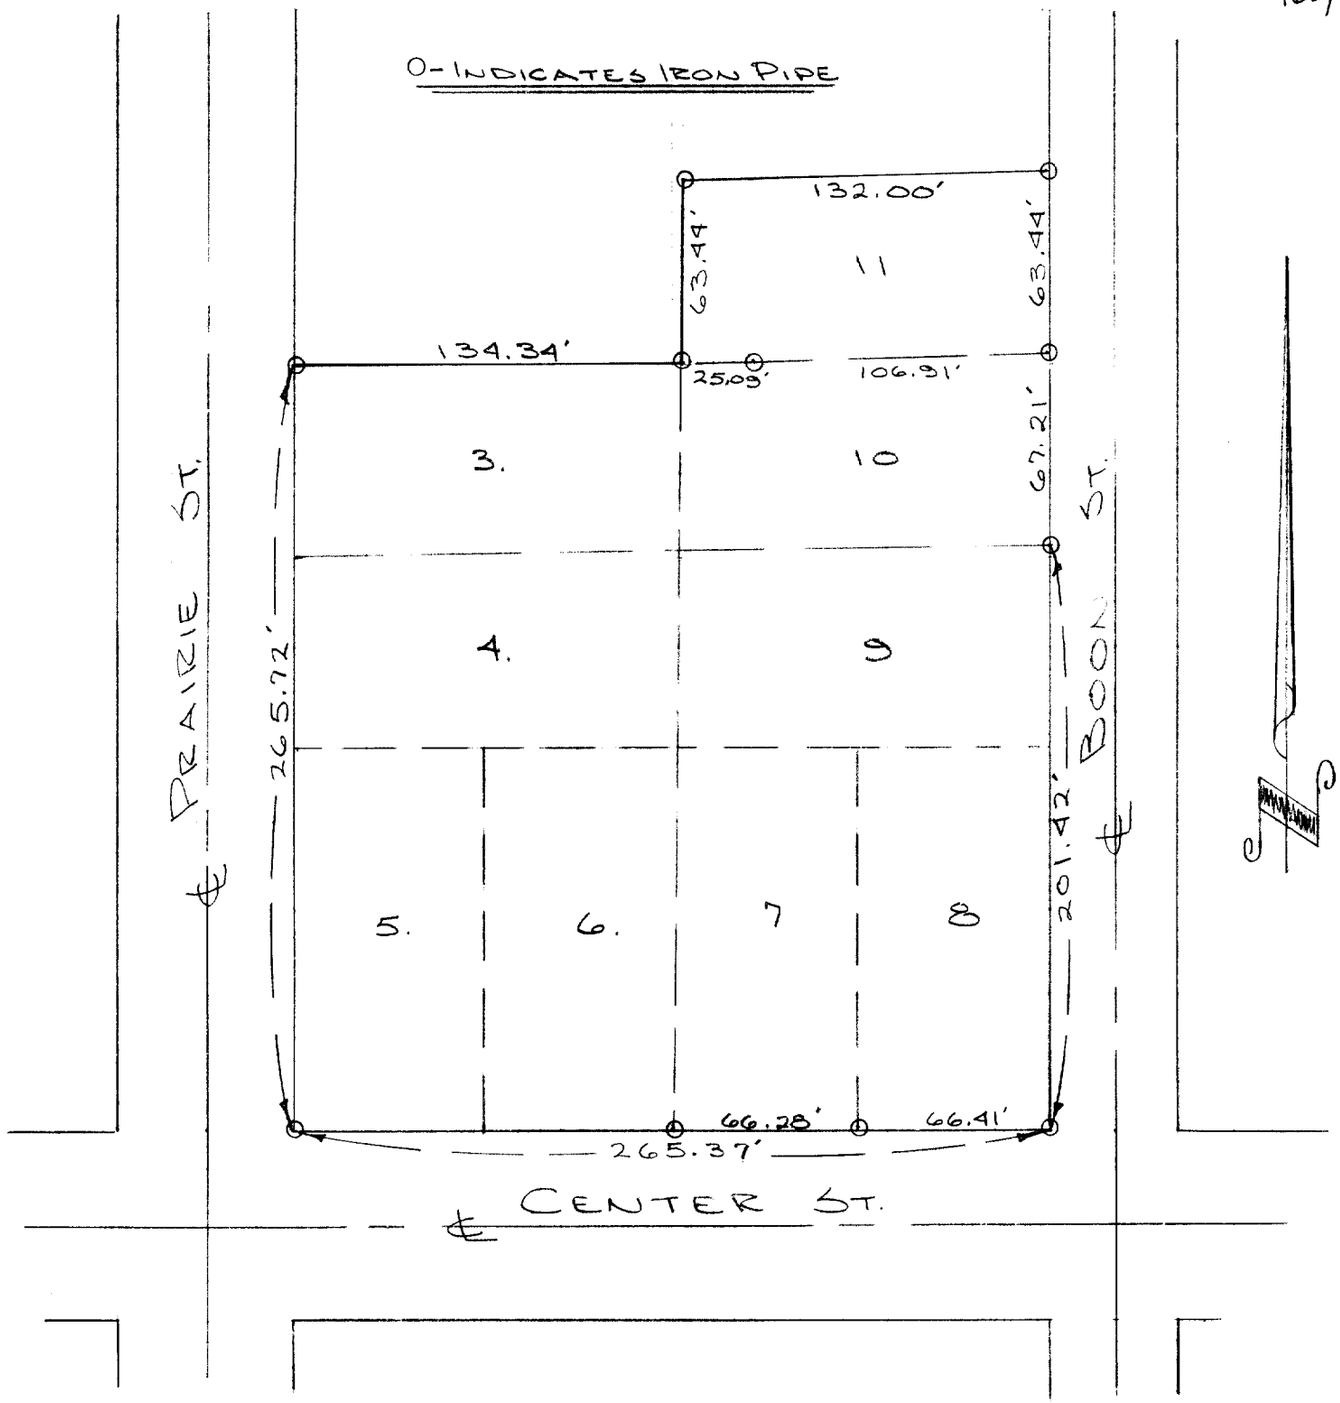

DESCRIPTION: Lots 3, 4, 5, 6, 7, 8, 9, 10, and 11 of Block 16 in Chapman and Ludingtons Addition to the City of Whitewater, Walworth County, Wisconsin.

CERTIFICATE: I, James F. Biagi, surveyor, do hereby certify that I have surveyed the property hereon described.

August 21, 1970

WISCONSIN JAMES F. BIAGI MILWAUKEE, WIS. LAND SURVEYOR

James F. Biagi, R.L.S. 272

CL 10, 9

10-308