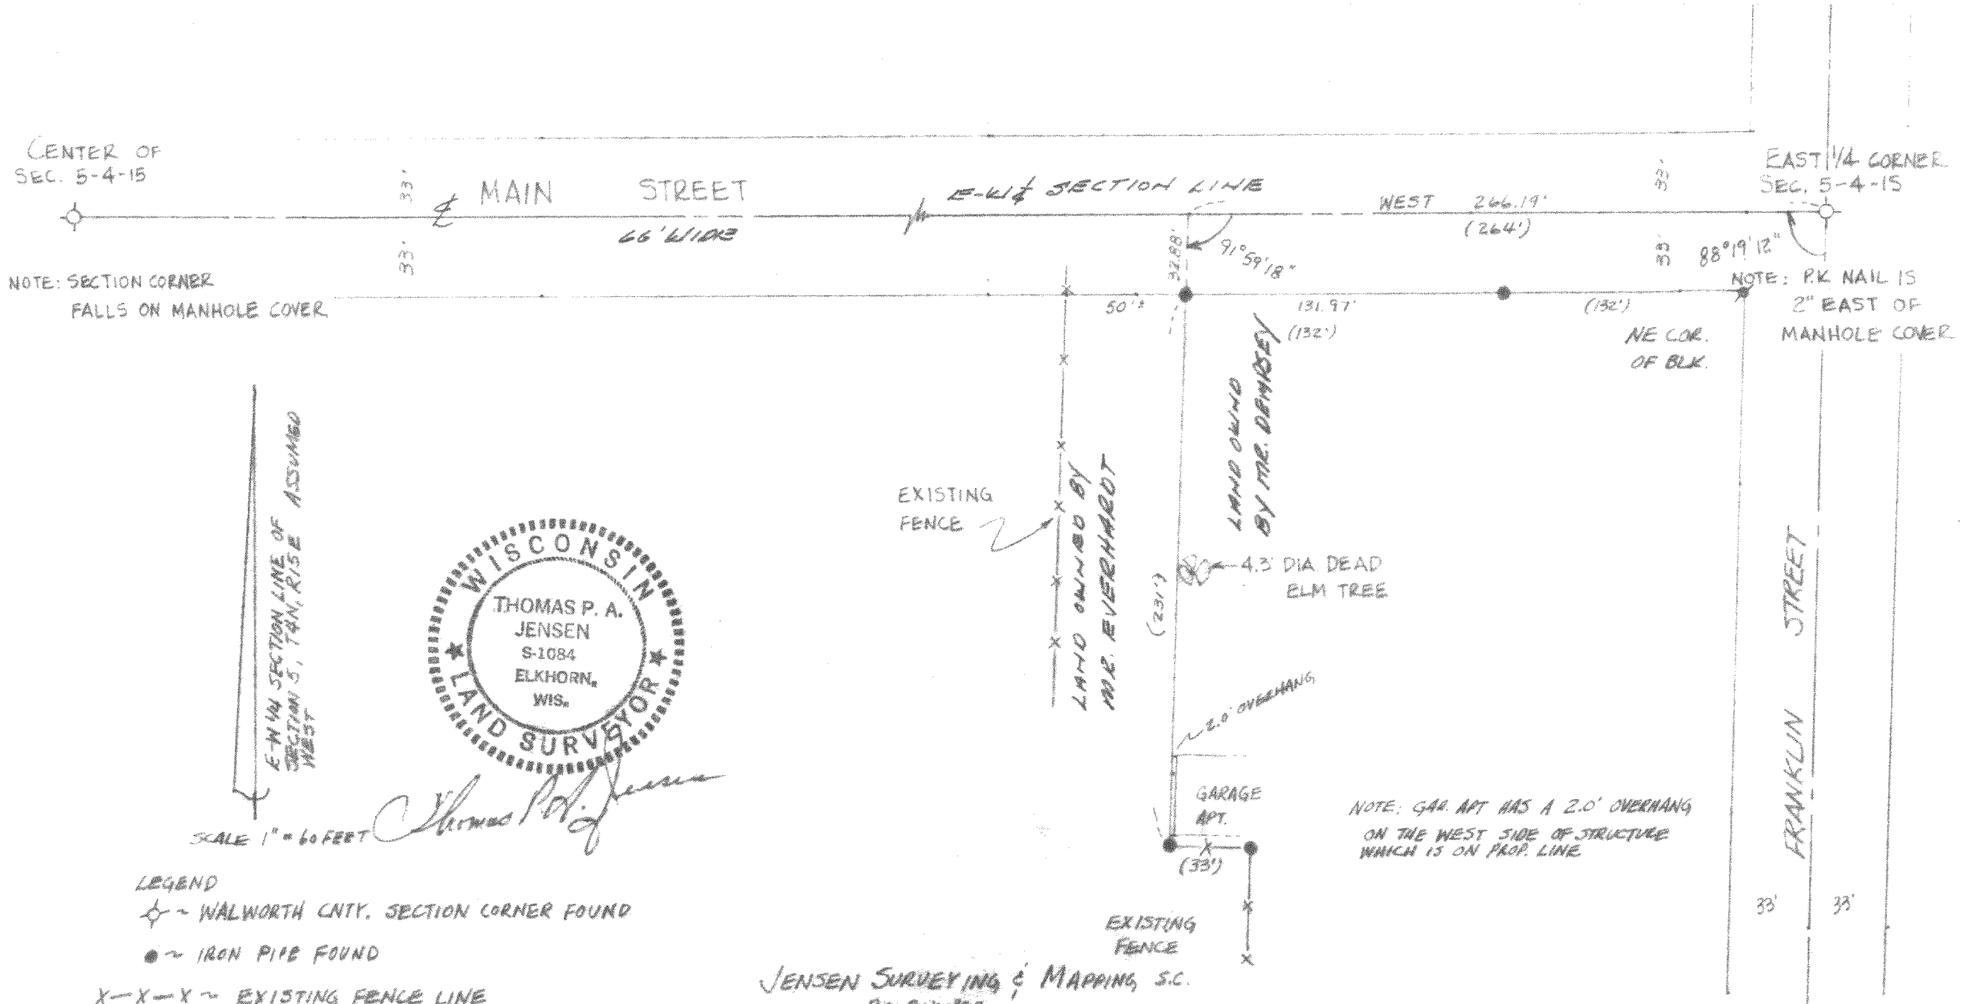

CENTER OF SEC. 5-4-15
33'
℄ MAIN STREET
66' WIDE
33'
E-W ¼ SECTION LINE
WEST 266.19'
(264')
33'
EAST 1/4 CORNER SEC. 5-4-15
91°59'18"
32.88'
88°19'12"
NOTE: SECTION CORNER FALLS ON MANHOLE COVER
50'±
131.97'
(132')
(132')
NOTE: P.K. NAIL IS 2" EAST OF MANHOLE COVER
NE COR. OF BLK.
E-W ¼ SECTION LINE OF SECTION 5, T4N, R15E ASSUMED WEST
WISCONSIN
THOMAS P. A. JENSEN
S-1084
ELKHORN, WIS.
LAND SURVEYOR
EXISTING FENCE
LAND OWNED BY MR. EVERHARDT
4.3' DIA DEAD ELM TREE
2.0' OVERHANG
GARAGE APT.
(33')
EXISTING FENCE
NOTE: GAR. APT HAS A 2.0' OVERHANG ON THE WEST SIDE OF STRUCTURE WHICH IS ON PROP. LINE
FRANKLIN STREET
33'
33'
SCALE 1" = 60 FEET
LEGEND
~ WALWORTH CNTY. SECTION CORNER FOUND
~ IRON PIPE FOUND
X—X—X ~ EXISTING FENCE LINE
~ IRON ROD FOUND
WUP-243 + 244
JENSEN SURVEYING & MAPPING, S.C.
P.O. BOX 322
ELKHORN, WIS. 53121
JULY 29, 1981
10-310-J
1981.052